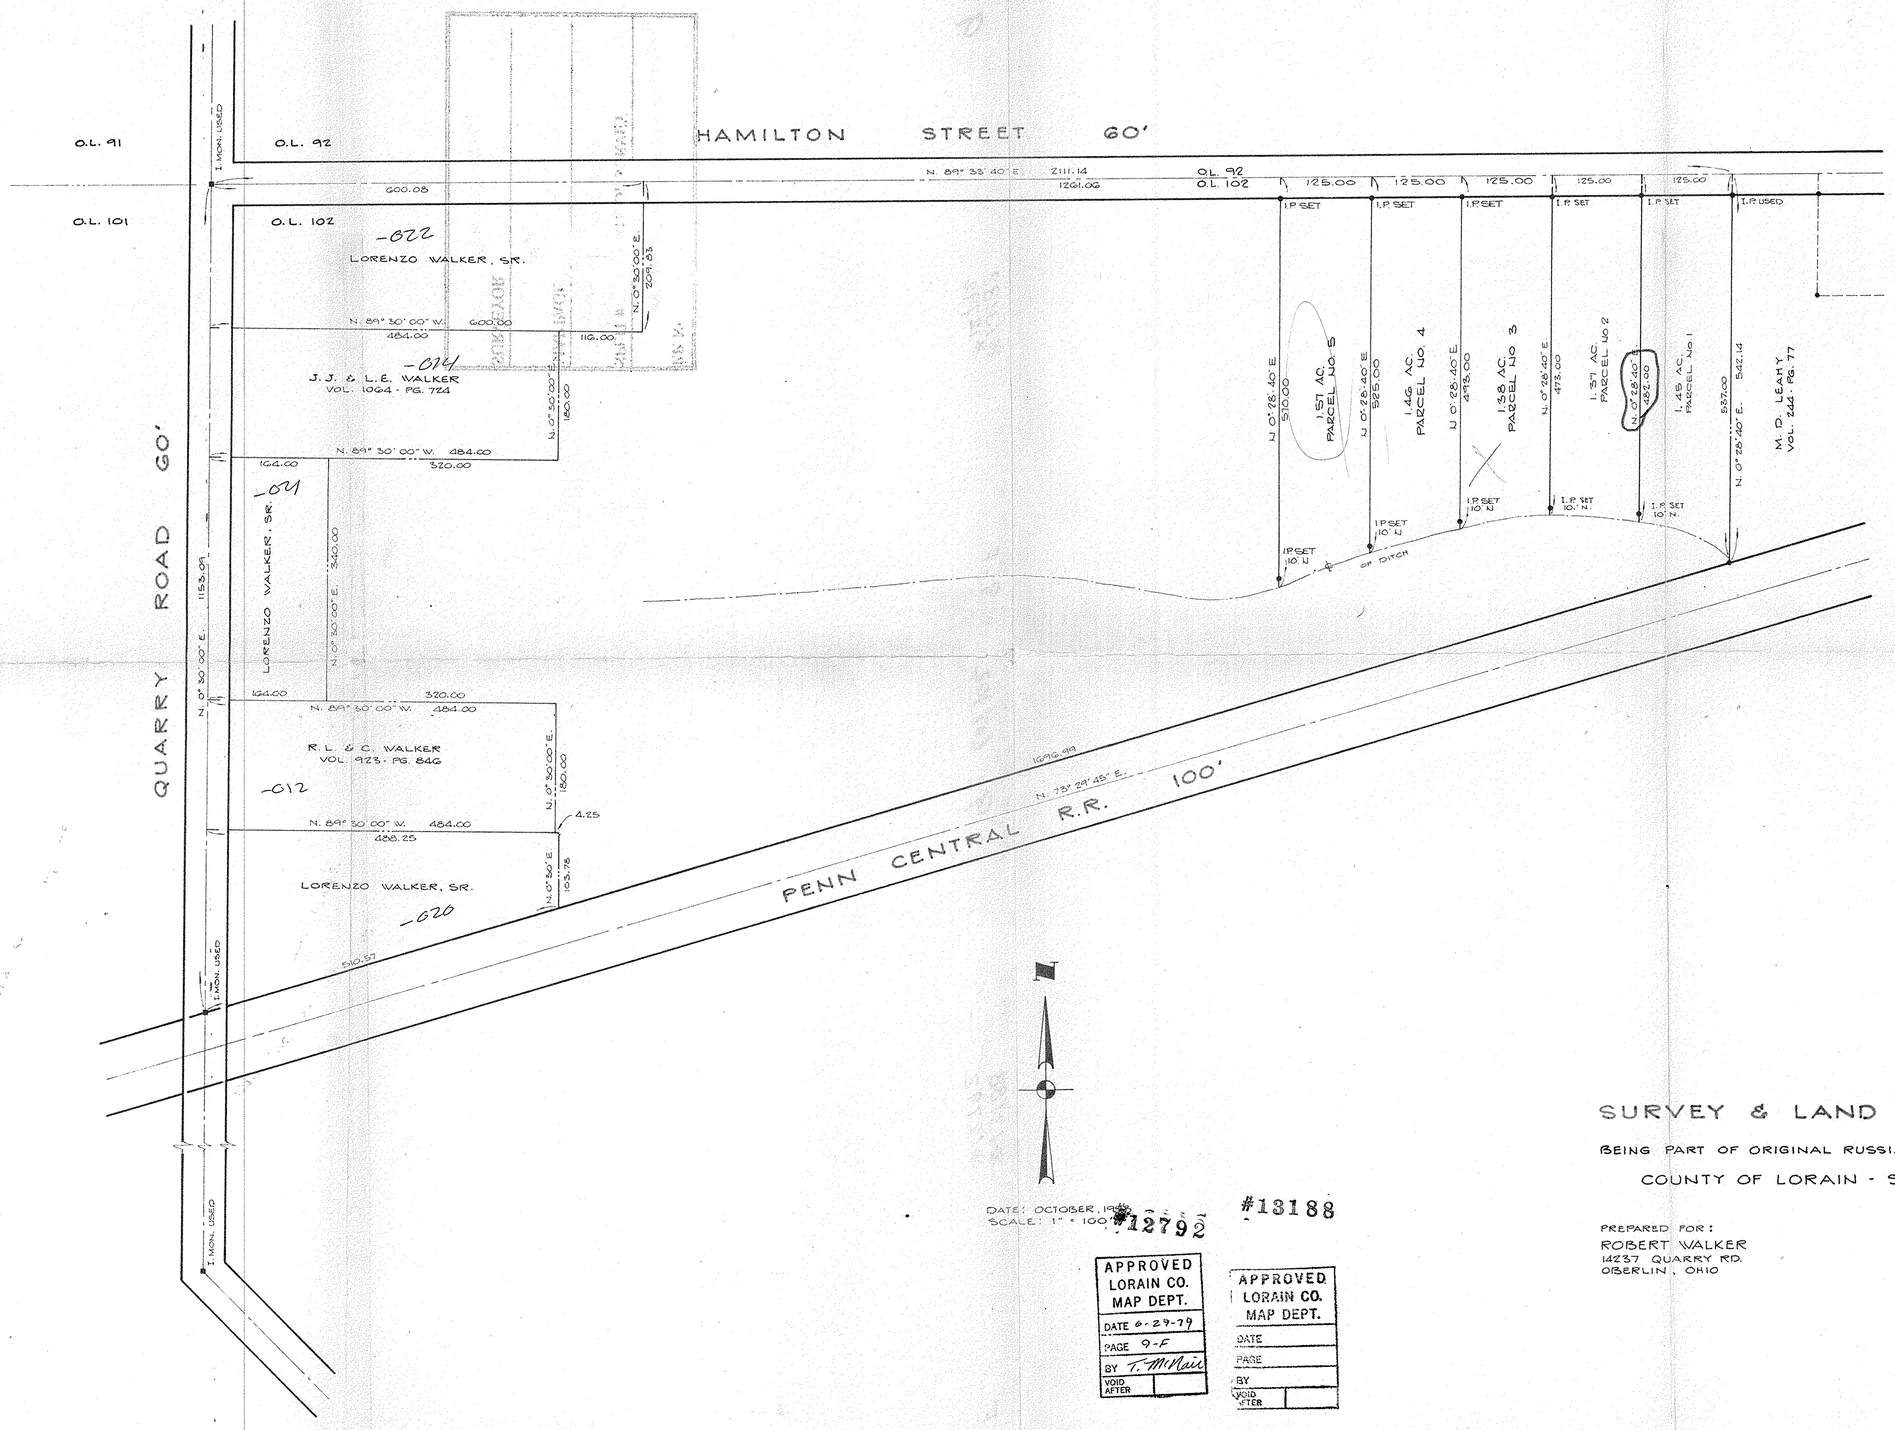

#12792

#13188

APPROVED
LORAIN CO.
MAP DEPT.
DATE 6-29-79
PAGE 9-F
BY T. McNair
VOID AFTER

APPROVED
LORAIN CO.
MAP DEPT.
DATE
PAGE
BY
VOID AFTER

SURVEY & LAND PARTITION

BEING PART OF ORIGINAL RUSSIA TOWNSHIP LOT 102

COUNTY OF LORAIN - STATE OF OHIO

PREPARED FOR:
ROBERT WALKER
14237 QUARRY RD.
OBERLIN, OHIO

BY:
FOOR & ASSOCIATES, INC.
LAND SURVEYORS
NORTH RIDGEVILLE, OHIO

STATE OF OHIO
ROBERT J. MARTIN
5139
REGISTERED
SURVEYOR

REVISED 5-3-79 ADDED PCLS. 3,4 & 5.

78-122