LAUNDON . SIMON . CAHL & ASSOC. INC.
CONSULTING ENGINEERS & SURVEYORS
219 COURT ST. ELYRIA, OHIO 44035

SURVEY FOR:

BEATRICE HOMSTEAD

Orig. Lot 17	City of	Date DEC. 26 '86 Scale 1"=200'
Orig. Sec	Village of	Dwn. by R.G.S. Chkd. by C.J.
Tract 12	County of LORAIN	Job No. 86-1540 F.B. —
Township of HENRIETTA	State of OHIO	Printed DEC 30 1986

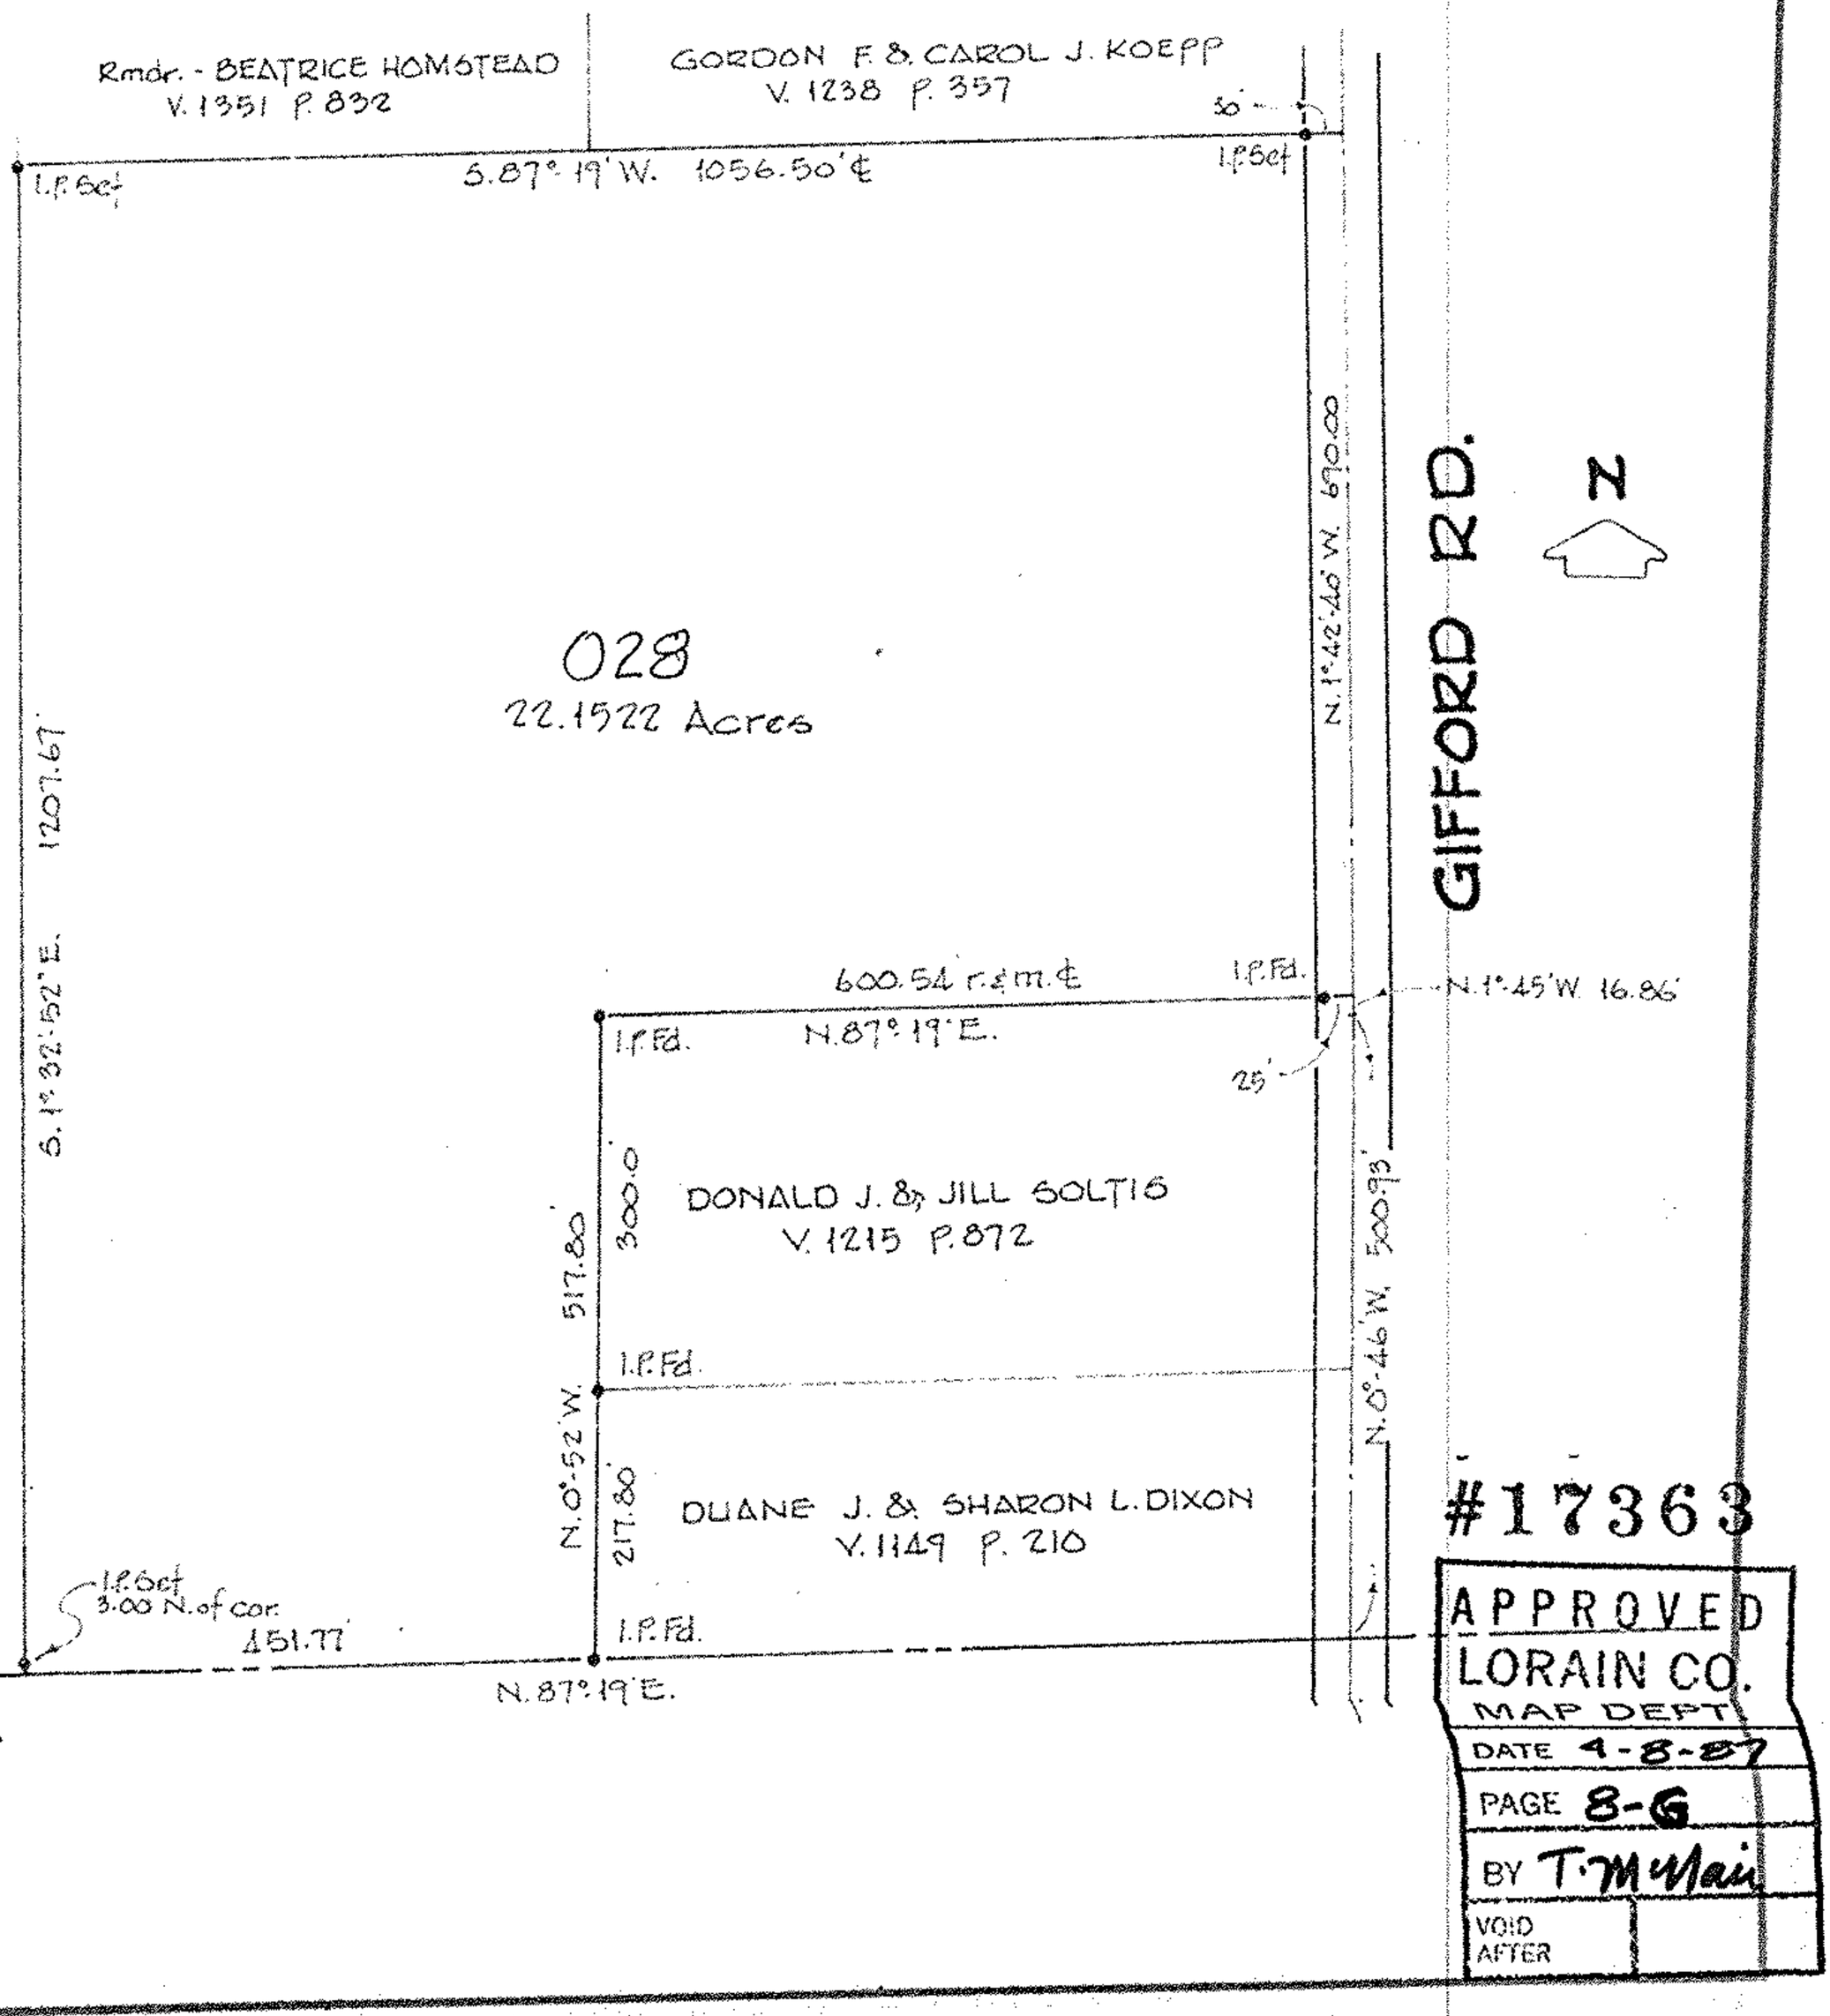

17363 3 08-

8-G

#17363

APPROVED
LORAIN CO.
MAP DEPT.
DATE 4-8-87
PAGE 8-G
BY T. McNair
VOID AFTER