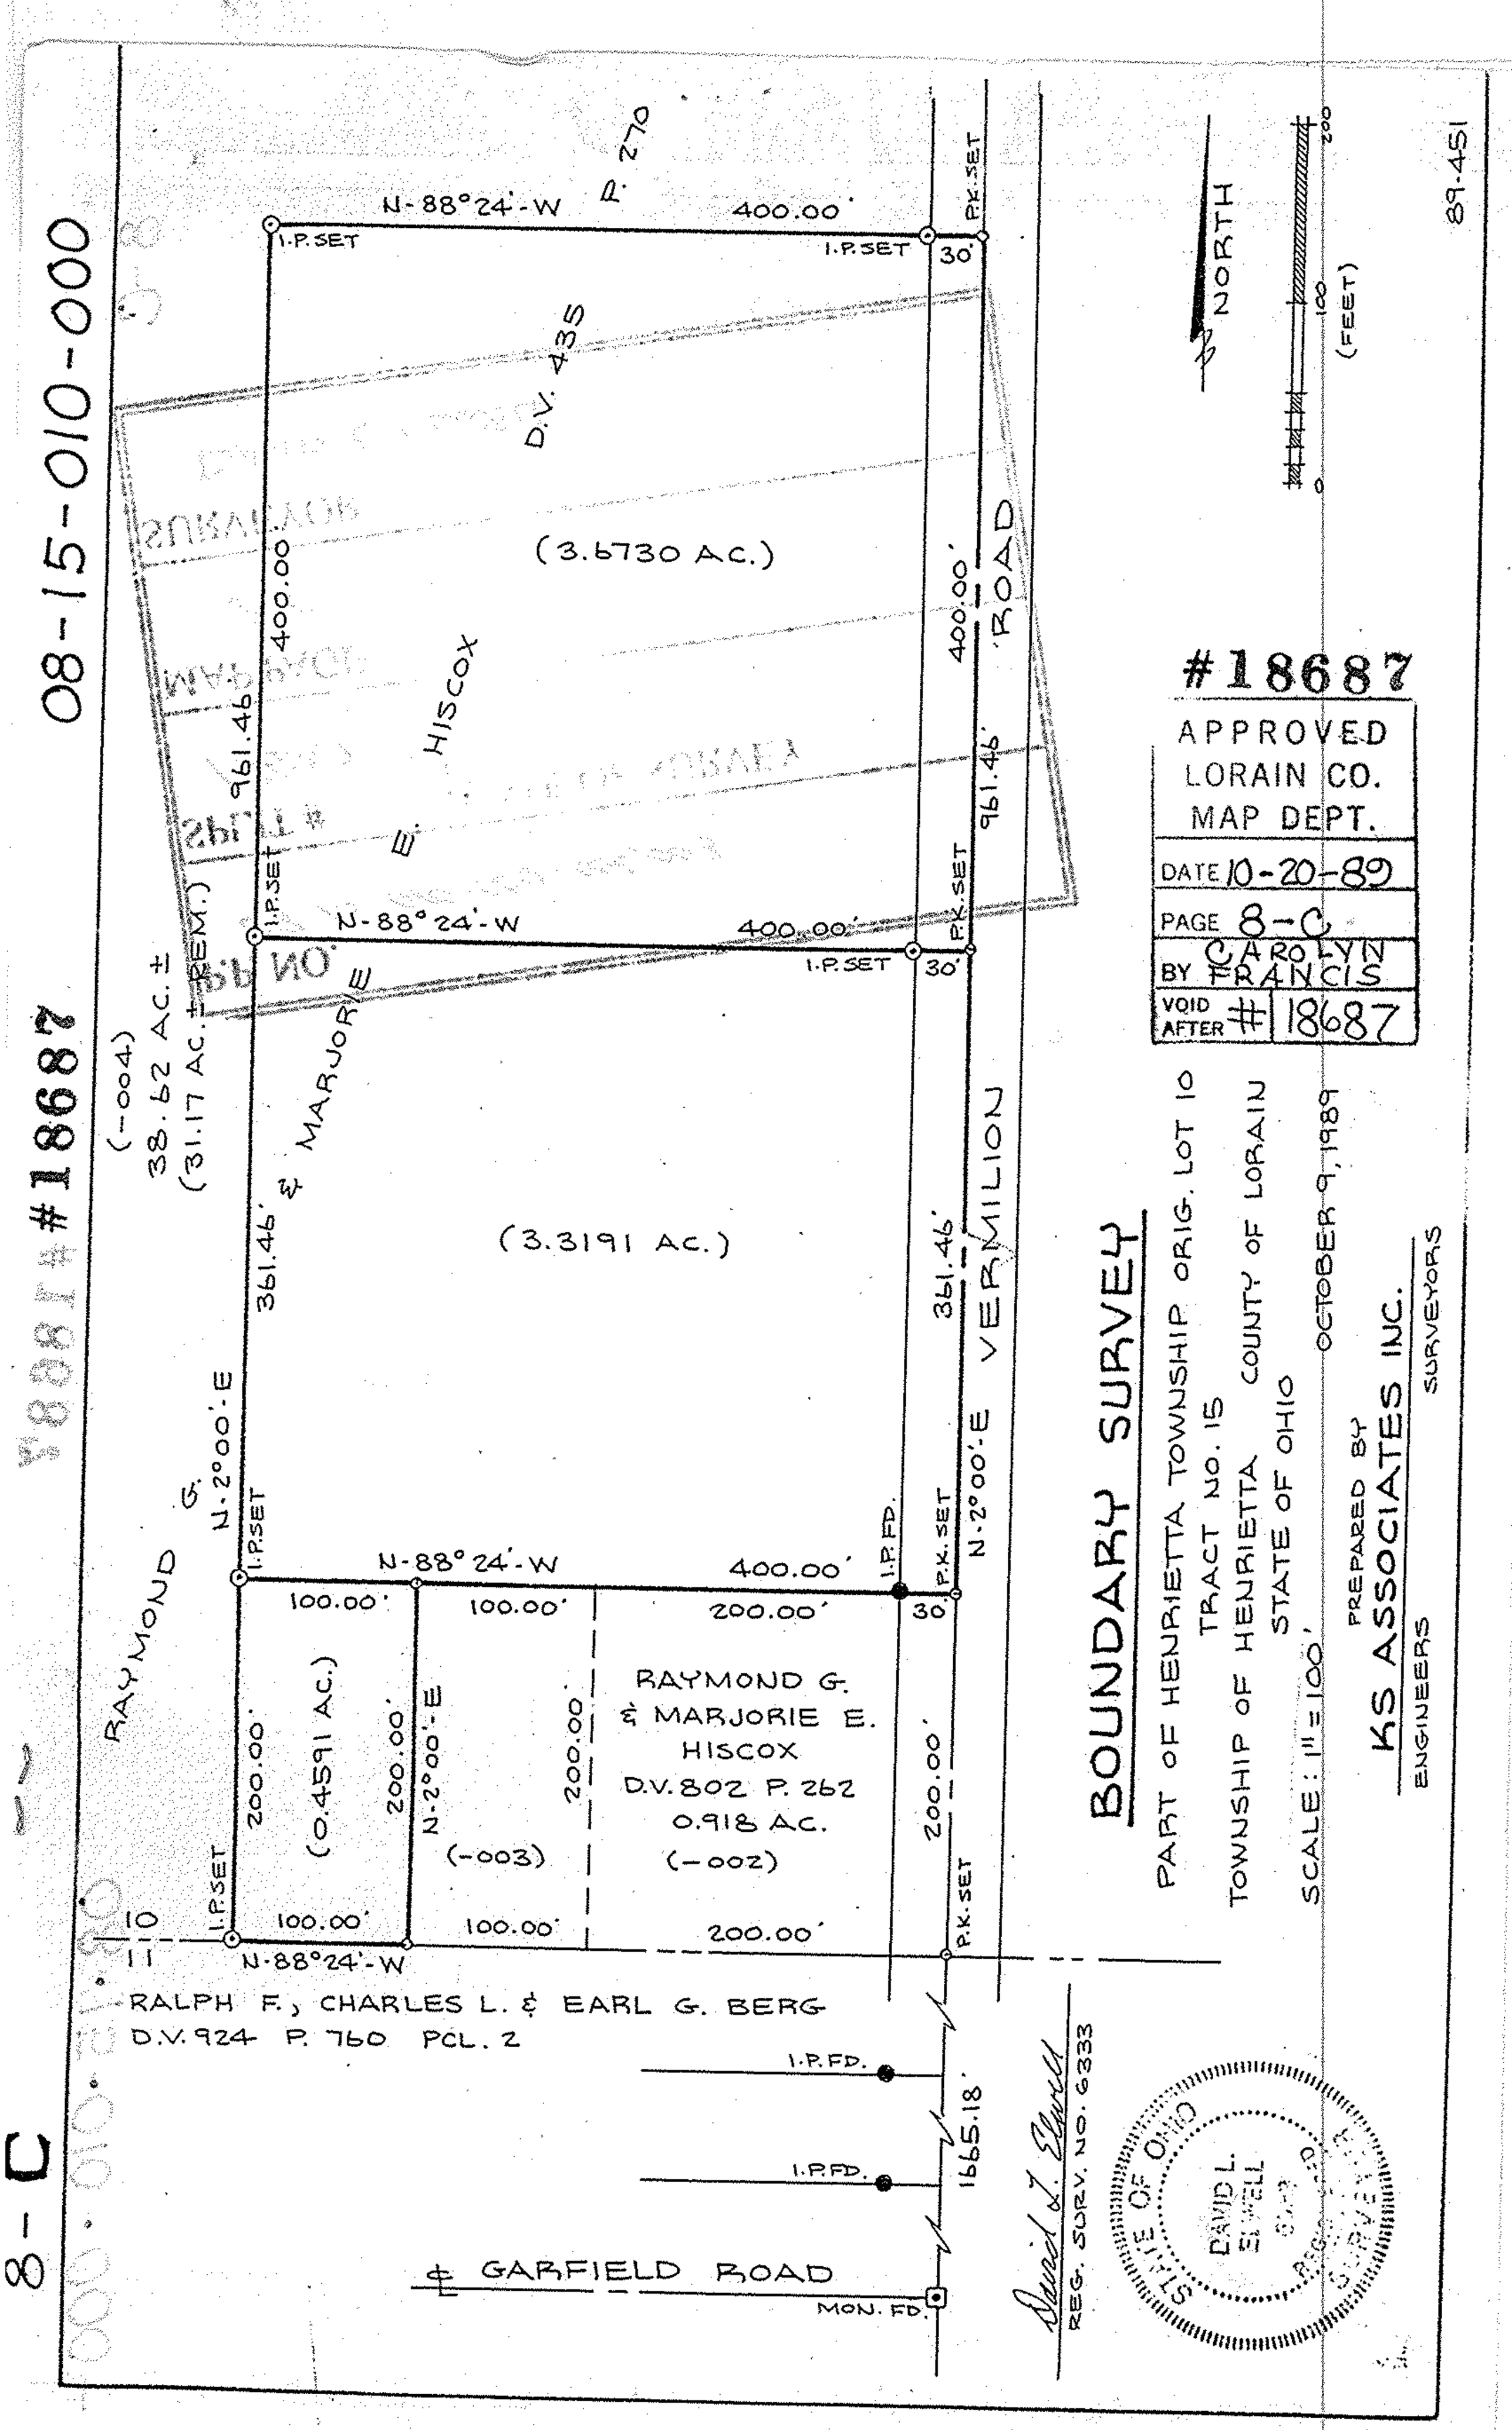

08-15-010-000
#18687
8-C
89-451
NORTH
0
100
200
(FEET)
#18687
APPROVED
LORAIN CO.
MAP DEPT.
DATE 10-20-89
PAGE 8-C
BY CAROLYN FRANCIS
VOID AFTER # 18687
N-88°24'-W
400.00'
I.P. SET
P.K. SET
30'
D.V. 435
(3.6730 AC.)
400.00'
961.46'
HISCOX
E.
ROAD
VERMILION
(-004)
38.62 AC. ±
(31.17 AC. ± REM.)
MARJORIE
(3.3191 AC.)
361.46'
N-2°00'-E
RAYMOND G.
I.P. FD.
100.00'
200.00'
(0.4591 AC.)
(-003)
RAYMOND G.
& MARJORIE E.
HISCOX
D.V. 802 P. 262
0.918 AC.
(-002)
10
11
RALPH F., CHARLES L. & EARL G. BERG
D.V. 924 P. 760 PCL. 2
1665.18'
℄ GARFIELD ROAD
MON. FD.
BOUNDARY SURVEY
PART OF HENRIETTA TOWNSHIP ORIG. LOT 10
TRACT NO. 15
TOWNSHIP OF HENRIETTA COUNTY OF LORAIN
STATE OF OHIO
SCALE: 1" = 100'
OCTOBER 9, 1989
PREPARED BY
KS ASSOCIATES INC.
ENGINEERS SURVEYORS
David L. Elwell
REG. SURV. NO. 6333
STATE OF OHIO
DAVID L. ELWELL