MAP OF SURVEY AND LOT SPLIT

PREPARED FOR

PERRY GARSKY AND WILLIAM SWANZER

P.P. NO. 17-07-020-000-002	
SPLIT # 04-01750	DATE OF SURVEY August 2004
MAP PAGE 17-E	
SURVEYOR Thomas M. SNEZEK	

SITUATED IN THE TOWNSHIP OF BRIGHTON, COUNTY OF LORAIN AND STATE OF OHIO AND BEING KNOWN AS PART OF ORIGINAL BRIGHTON TOWNSHIP TRACT 7, LOT 20 AND ALSO BEING ALL OF THOSE LANDS DEEDED TO JAMES A PARK, EXC. IN DEED INSTRUMENT #20040001435 OF LORAIN COUNTY DEED RECORDS

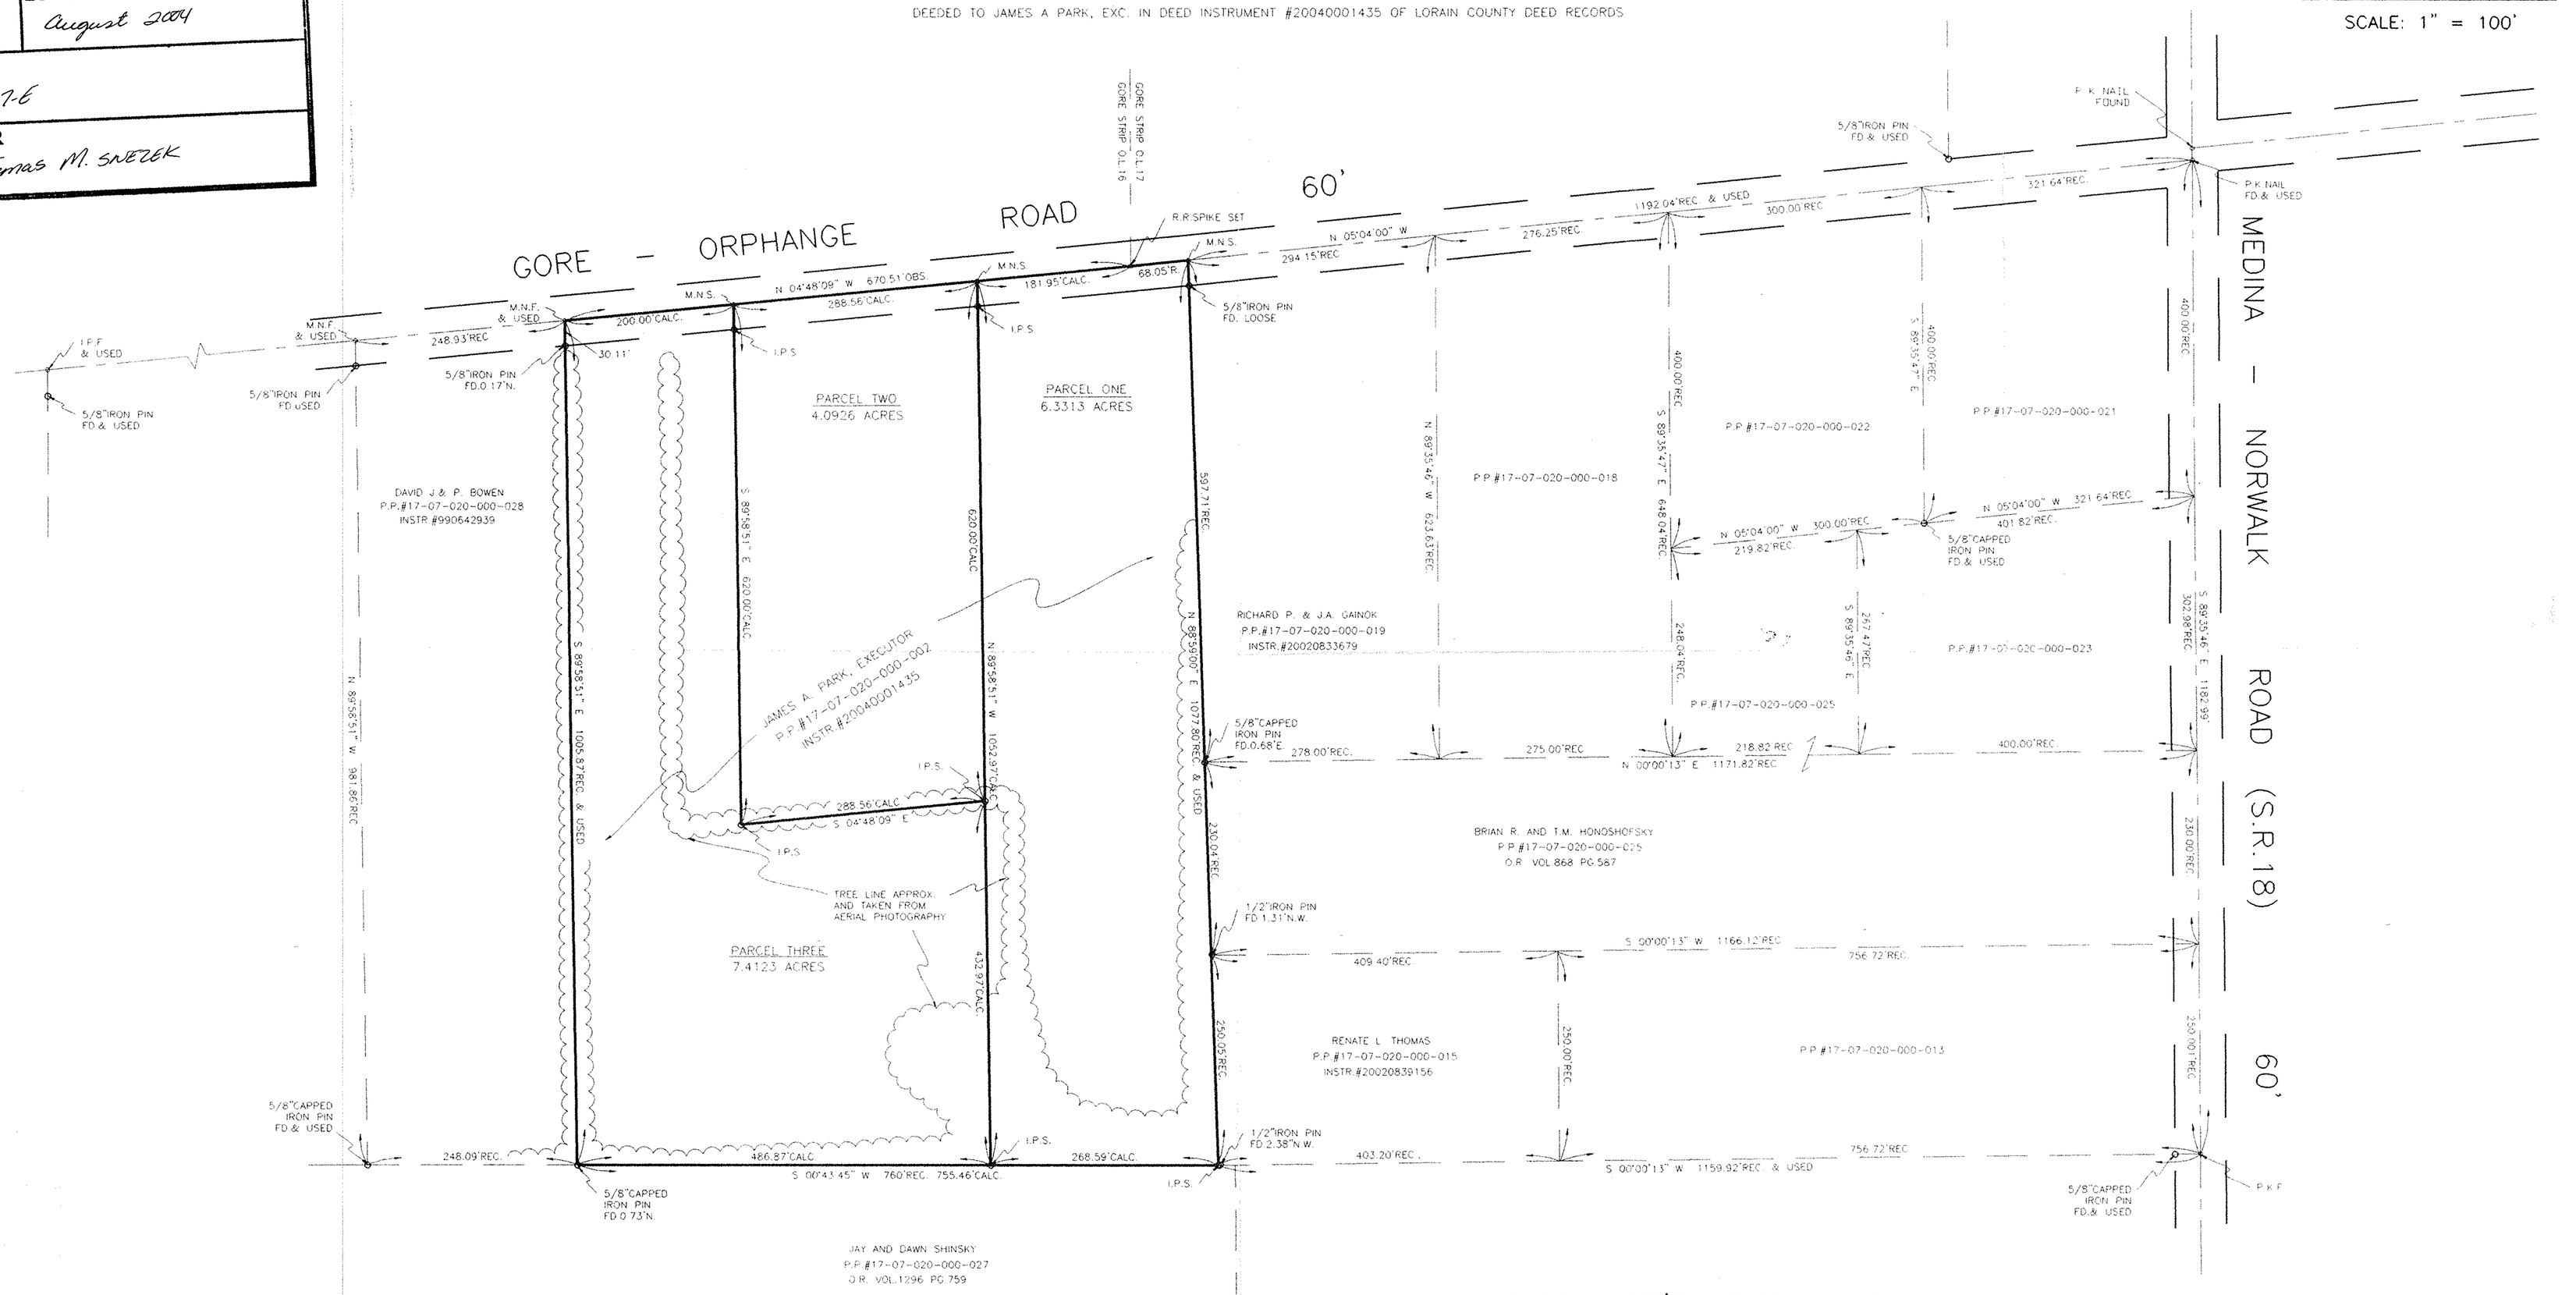

SURVEYOR'S STATEMENT

DISTANCES ARE EXPRESSED IN FEET AND DECIMAL PARTS THEREOF. BEARING ARE TO AN ASSUMED MERIDIAN AND ARE USED TO INDICATE ANGLES ONLY. PERMANENT MONUMENTS WERE FOUND OR SET AS INDICATED HEREON. ALL OF WHICH I DECLARE TO BE CORRECT TO THE BEST OF MY ABILITIES AND BELIEF.

Thomas M. Snezek

THOMAS M. SNEZEK, R.L.S.#7051

STATE OF OHIO THOMAS M. SNEZEK S-7051 SURVEYOR

8-6-04
DATE

LEGEND:

I.P.S. INDICATES A 5/8" IRON PIN WITH IDENTIFICATION CAPPED MARKED "T.M.SNEZEK S-7051" SET.

M.N.S. INDICATES A MAGNETIC NAIL SET.

APPROVED LORAIN CO. ENG. DEPT.
DATE 8-31-04
PAGE 17-E
BY JHatfield
#04-01750
№ 01750

PROJECT #0415 8/6/04