SURVEY
OF PART OF
ORIGINAL RIDGEVILLE TWP
LOT Nº 22

CITY OF N RIDGEVILLE COUNTY OF LORAIN
STATE OF OHIO

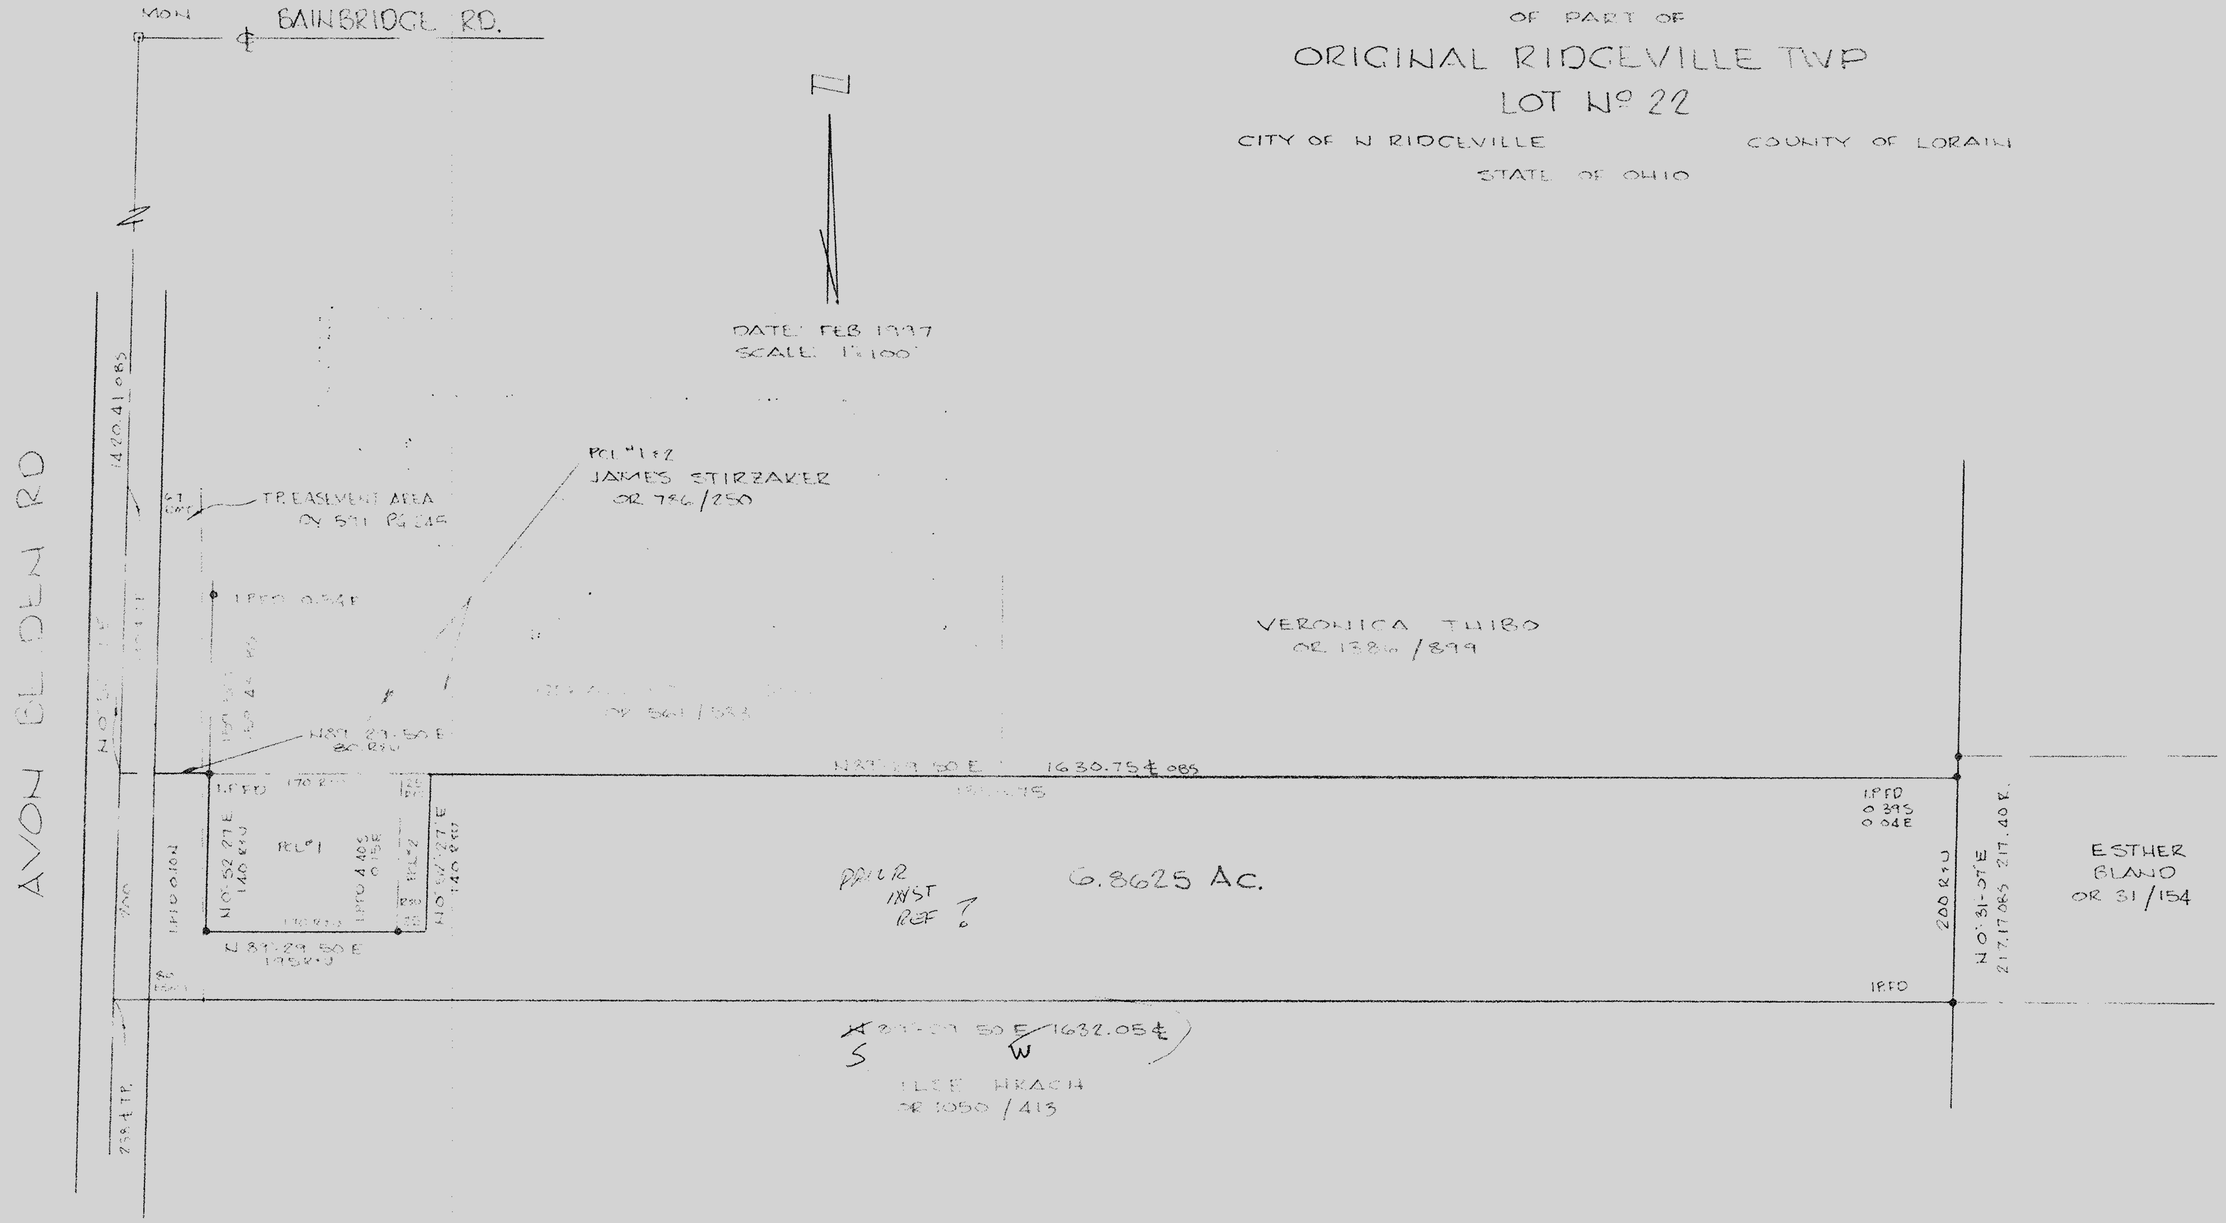

VERONICA THIBO
OR 1386/899

P.P. NO. 07-00-022-101-065
Split #22211-D
Mappage # 07-00-022-A

PREPARED FOR:
VERONICA THIBO
7611 AVON BELDEN RD
N RIDGEVILLE, OH.

PREPARED BY:
HAPONEK AND ASSOC
SURVEYORS
N. RIDGEVILLE, OH.

STATE OF OHIO

#22211-D

APPROVED LORAIN CO. MAP DEPT
DATE 6-18-97
PAGE 7-00-022A
BY R. BELL
#22211-D