P.P.N. 07-00-022-101-086, 085, 084, 065
Split # 00857
Map page # 07-00-022-C

FILE #4750

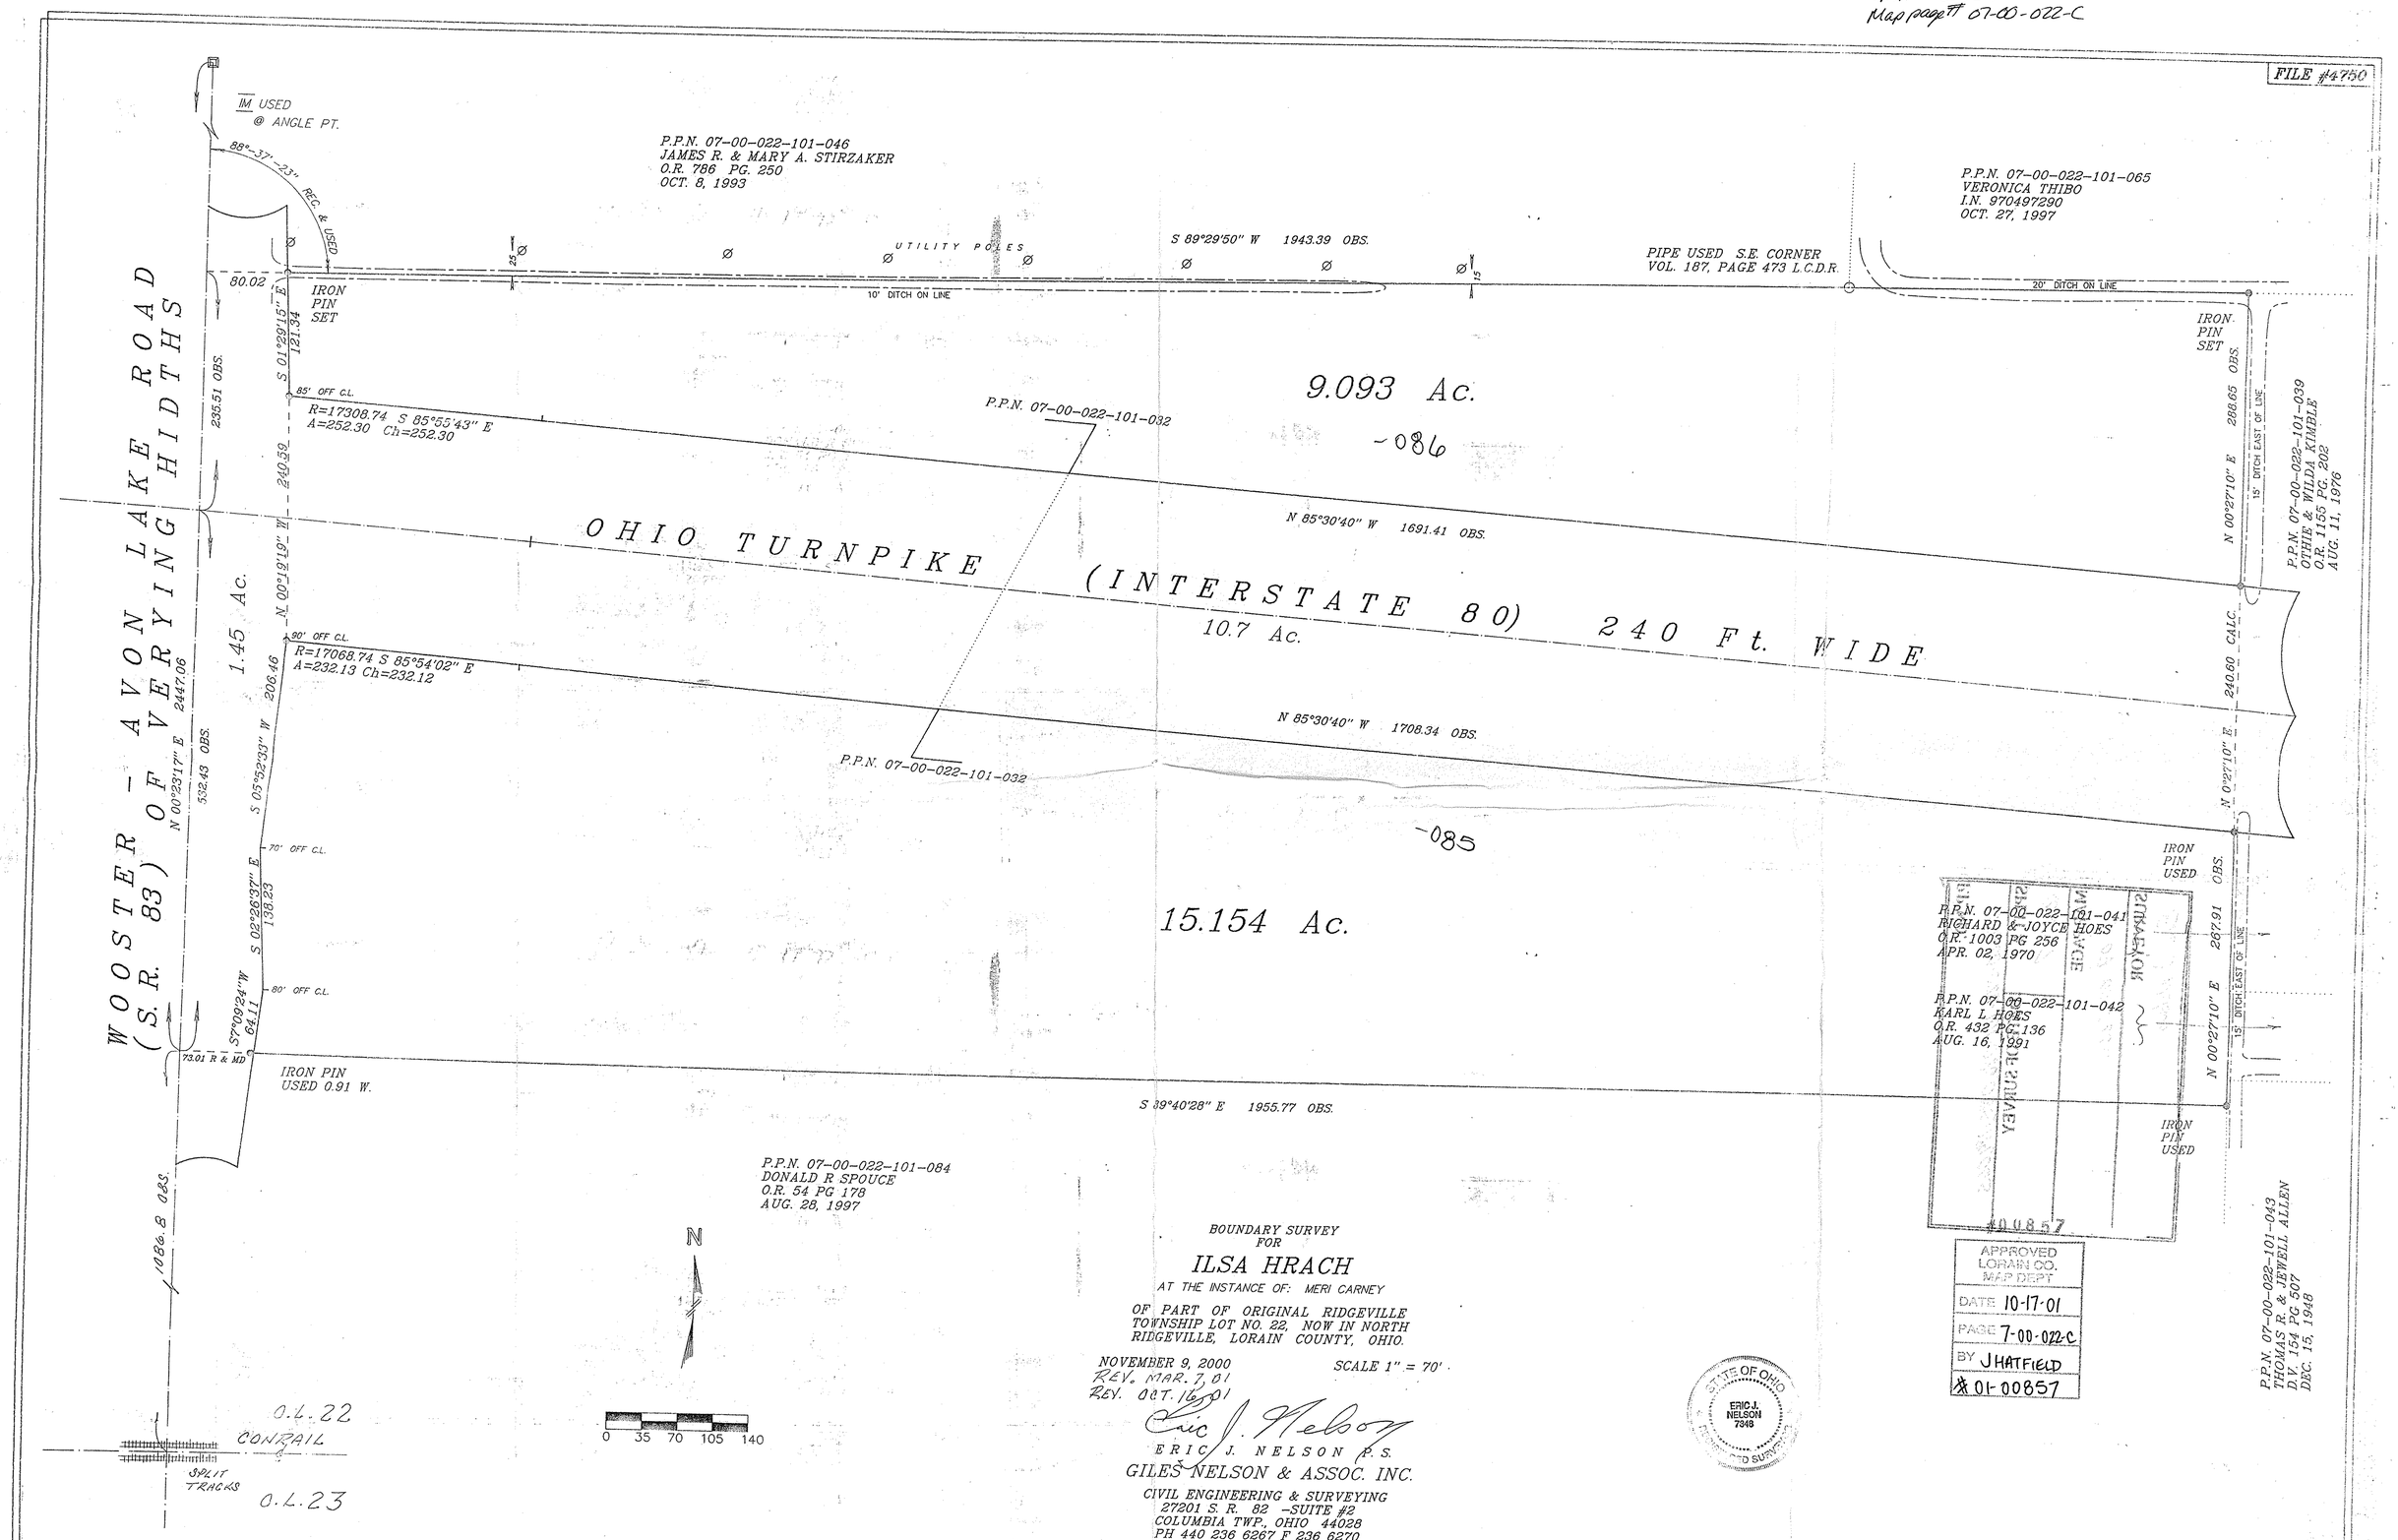

BOUNDARY SURVEY
FOR

ILSA HRACH

AT THE INSTANCE OF: MERI CARNEY

OF PART OF ORIGINAL RIDGEVILLE TOWNSHIP LOT NO. 22, NOW IN NORTH RIDGEVILLE, LORAIN COUNTY, OHIO.

NOVEMBER 9, 2000 SCALE 1" = 70'
REV. MAR. 7, 01
REV. OCT. 16, 01

ERIC J. NELSON P.S.
GILES NELSON & ASSOC. INC.
CIVIL ENGINEERING & SURVEYING
27201 S. R. 82 -SUITE #2
COLUMBIA TWP., OHIO 44028
PH 440 236 6267 F 236 6270