07-00-023 102-033 & 034

JOB #	DATE OF SURVEY

MAP PAGE
07-00-023-A,B

SURVEYOR
Dane A Haponek

SURVEY
OF PART OF
ORIGINAL RIDGEVILLE
TOWNSHIP LOT NO 23
CITY OF N RIDGEVILLE COUNTY OF LORAIN
STATE OF OHIO

DATE: APRIL 1994
SCALE: 1" = 100'

PREPARED FOR:
GREG McKEE
2592 NORTHGLEN RD.
WESTLAKE, OHIO

PREPARED BY:
HAPONEK AND ASSOC INC.
ENGINEERS + SURVEYORS
N RIDGEVILLE, OH.

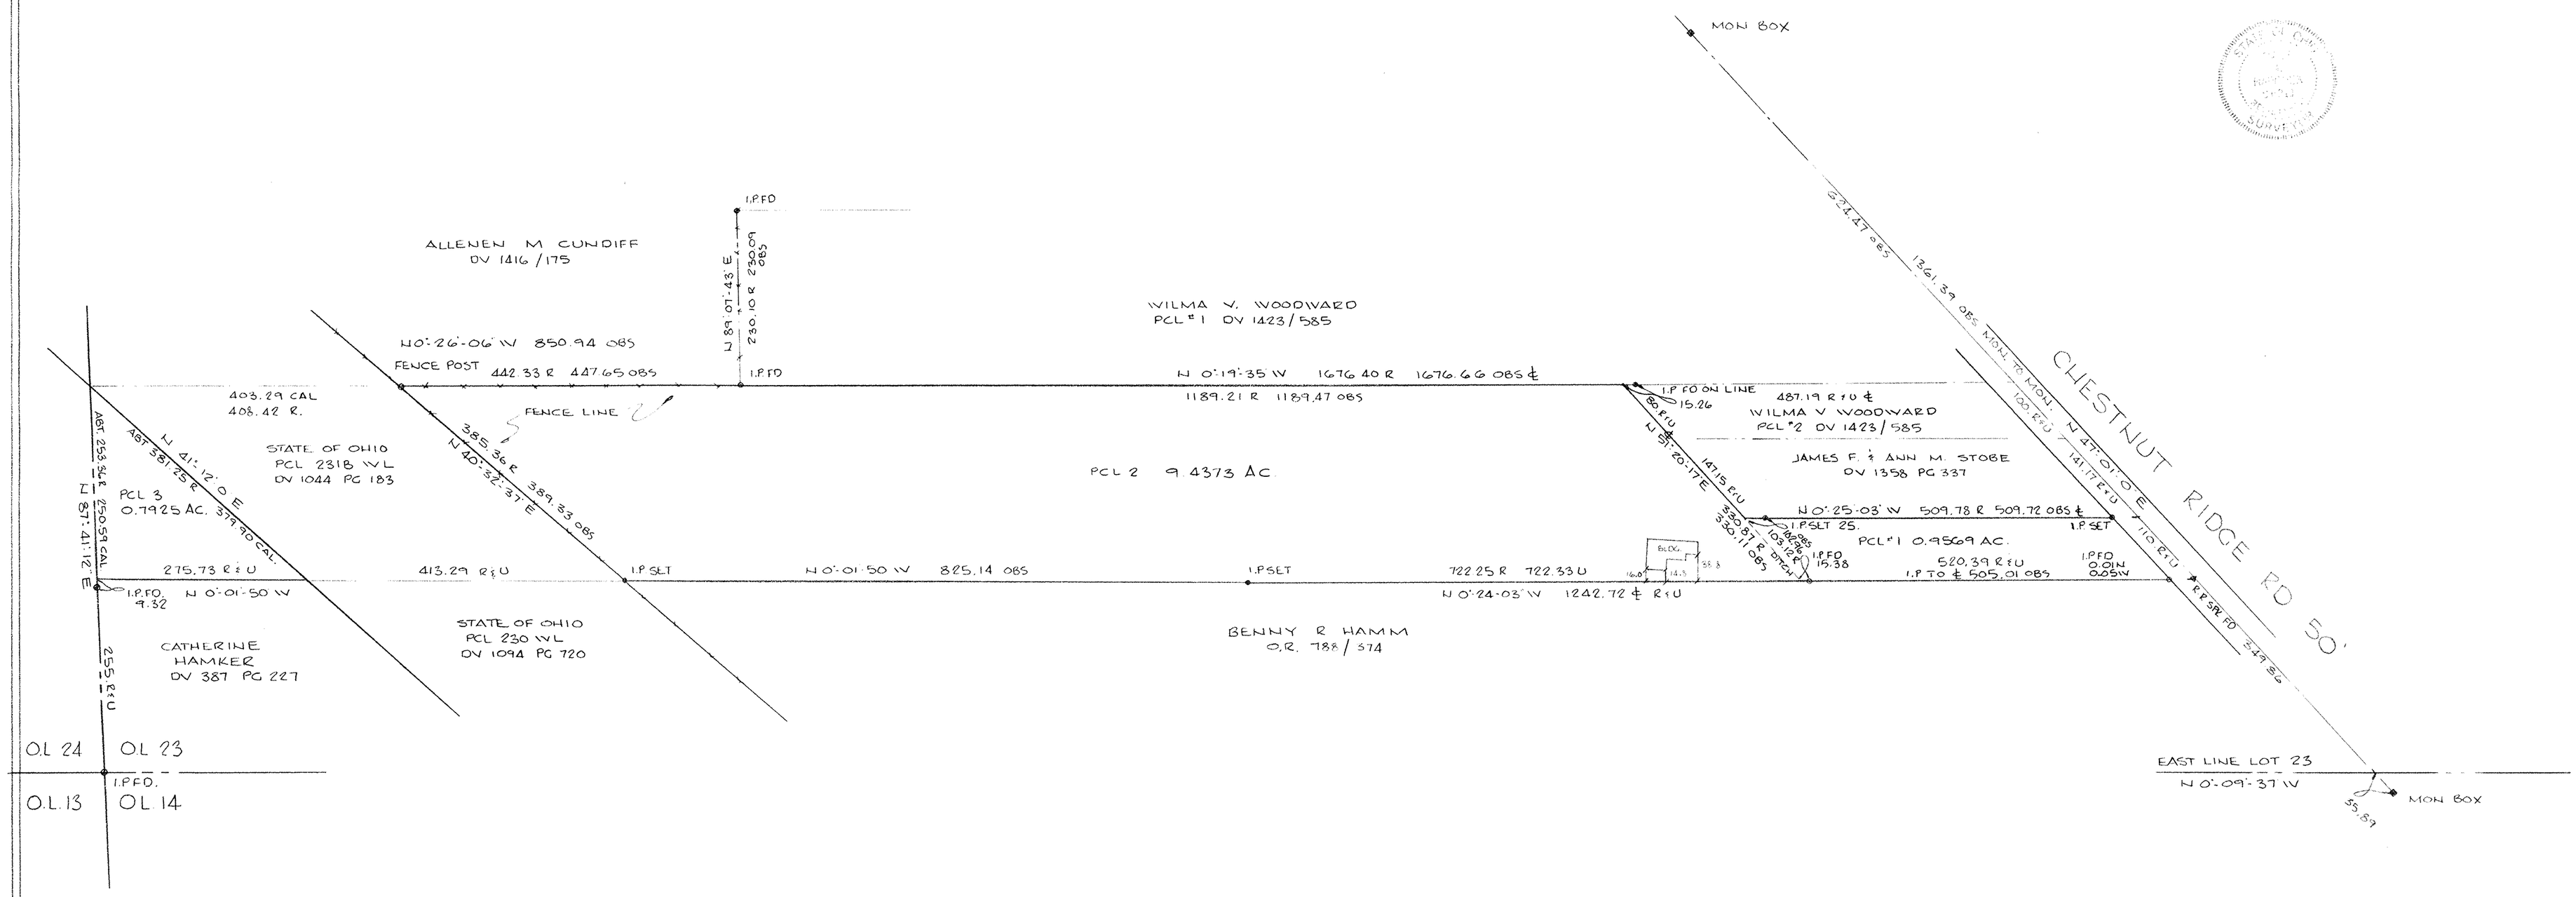

9403