SURVEY

OF PART OF

ORIGINAL RIDGEVILLE TOWNSHIP LOT 23

CITY OF N. RIDGEVILLE COUNTY OF LORAIN

AND

STATE OF OHIO

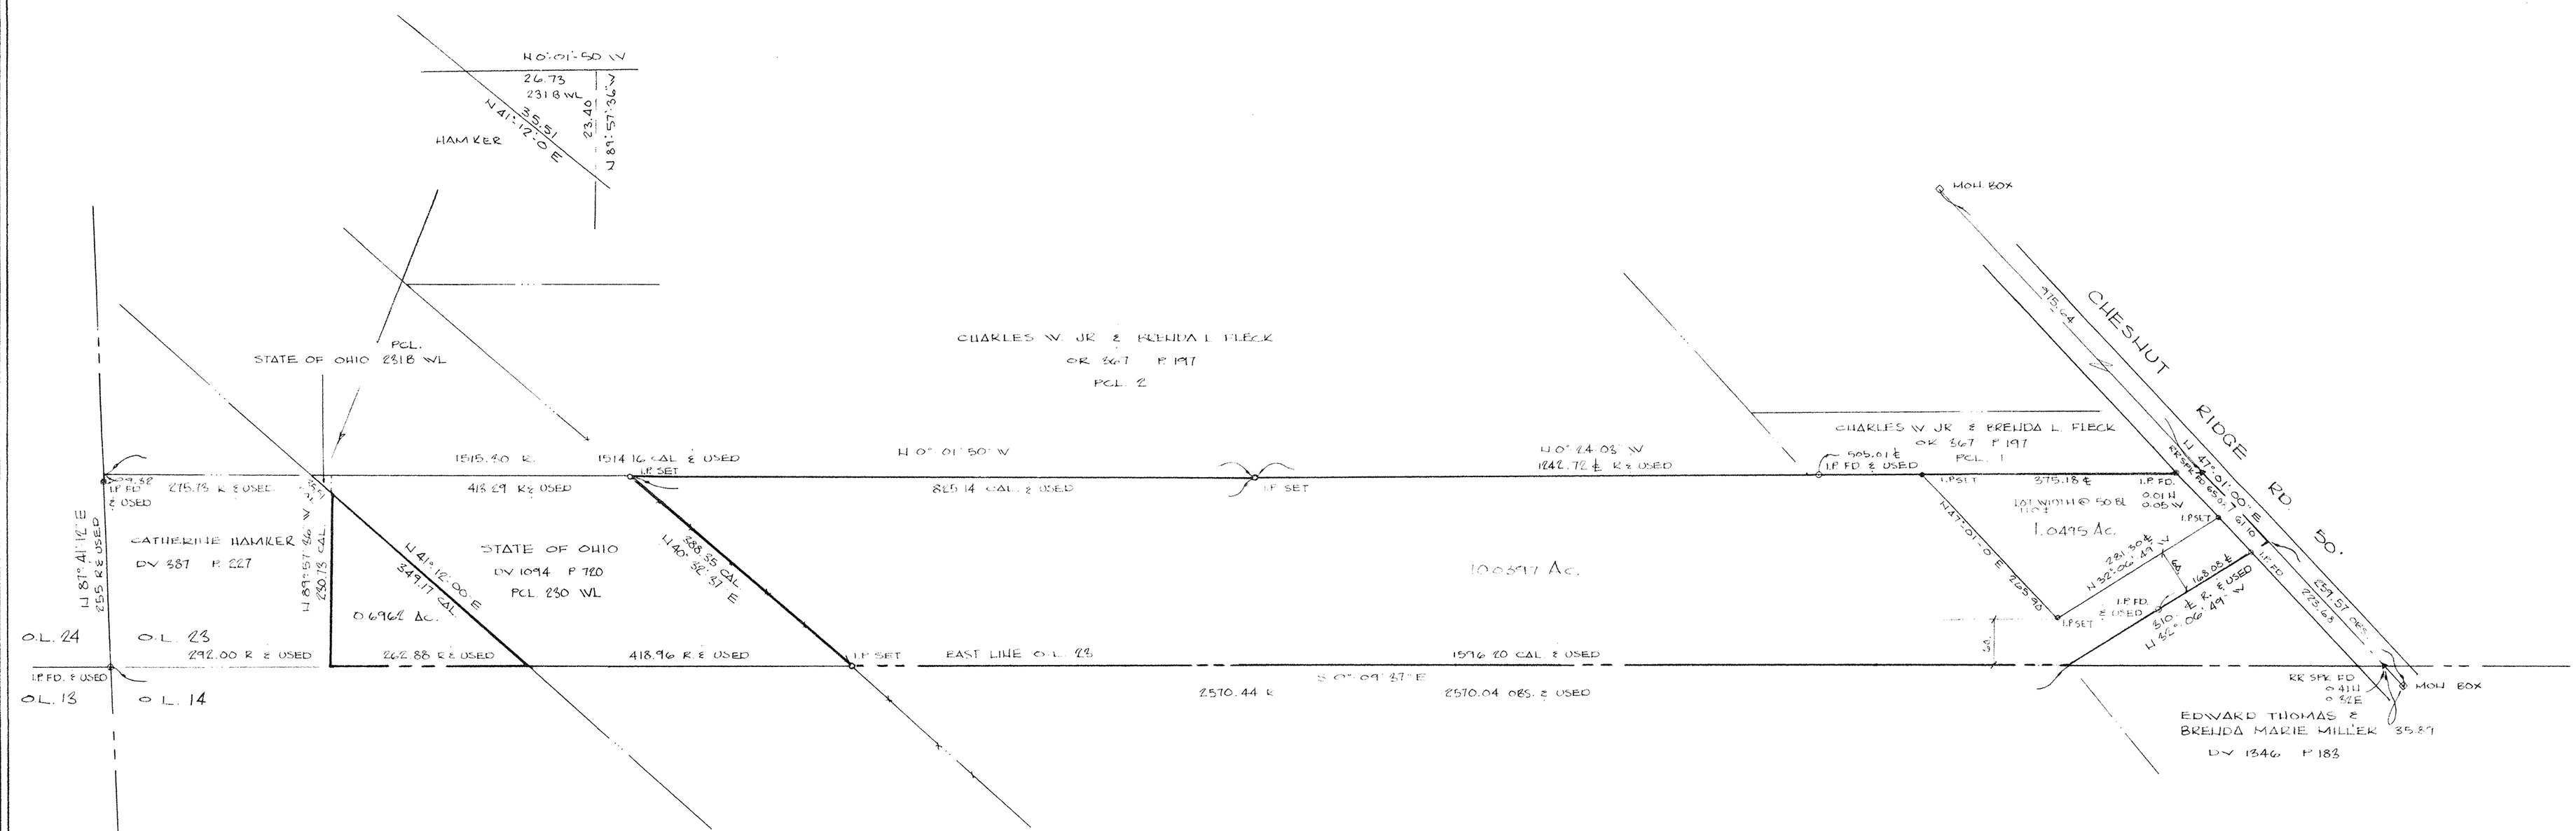

P.I. NO. 07-00-023-102-044	
SPLIT # 20956	DATE OF SURVEY
MAP PAGE 07-00-023-B	
SURVEYOR	

PREPARED FOR:

BENNY HAMM
5986 STEARNS RD.
N. OLMSTED, OH

DATE: FEB., 1994
SCALE: 1" = 100'

PREPARED BY:

HAPONEK AND ASSOC.
SURVEYORS AND ENGINEERS
N. RIDGEVILLE, OH

STATE OF OHIO
DANE A. HAPONEK
S-6211
REGISTERED
SURVEYOR

REVISED 4-24-94 ADDED SPLIT

94-03