100 0 100 200

SCALE IN FEET

SCALE: 1" = 100'

LEGEND

- 5/8" CAPPED REBAR SET
- IRON PIN/PIPE FOUND
- MONUMENT BOX FOUND
- P.K. NAIL FOUND

ABBREVIATIONS

REC. = RECORD
SURV. = SURVEYED
FND. = FOUND
EX. = EXISTING
GAR. = GARAGE
R/W = RIGHT-OF-WAY

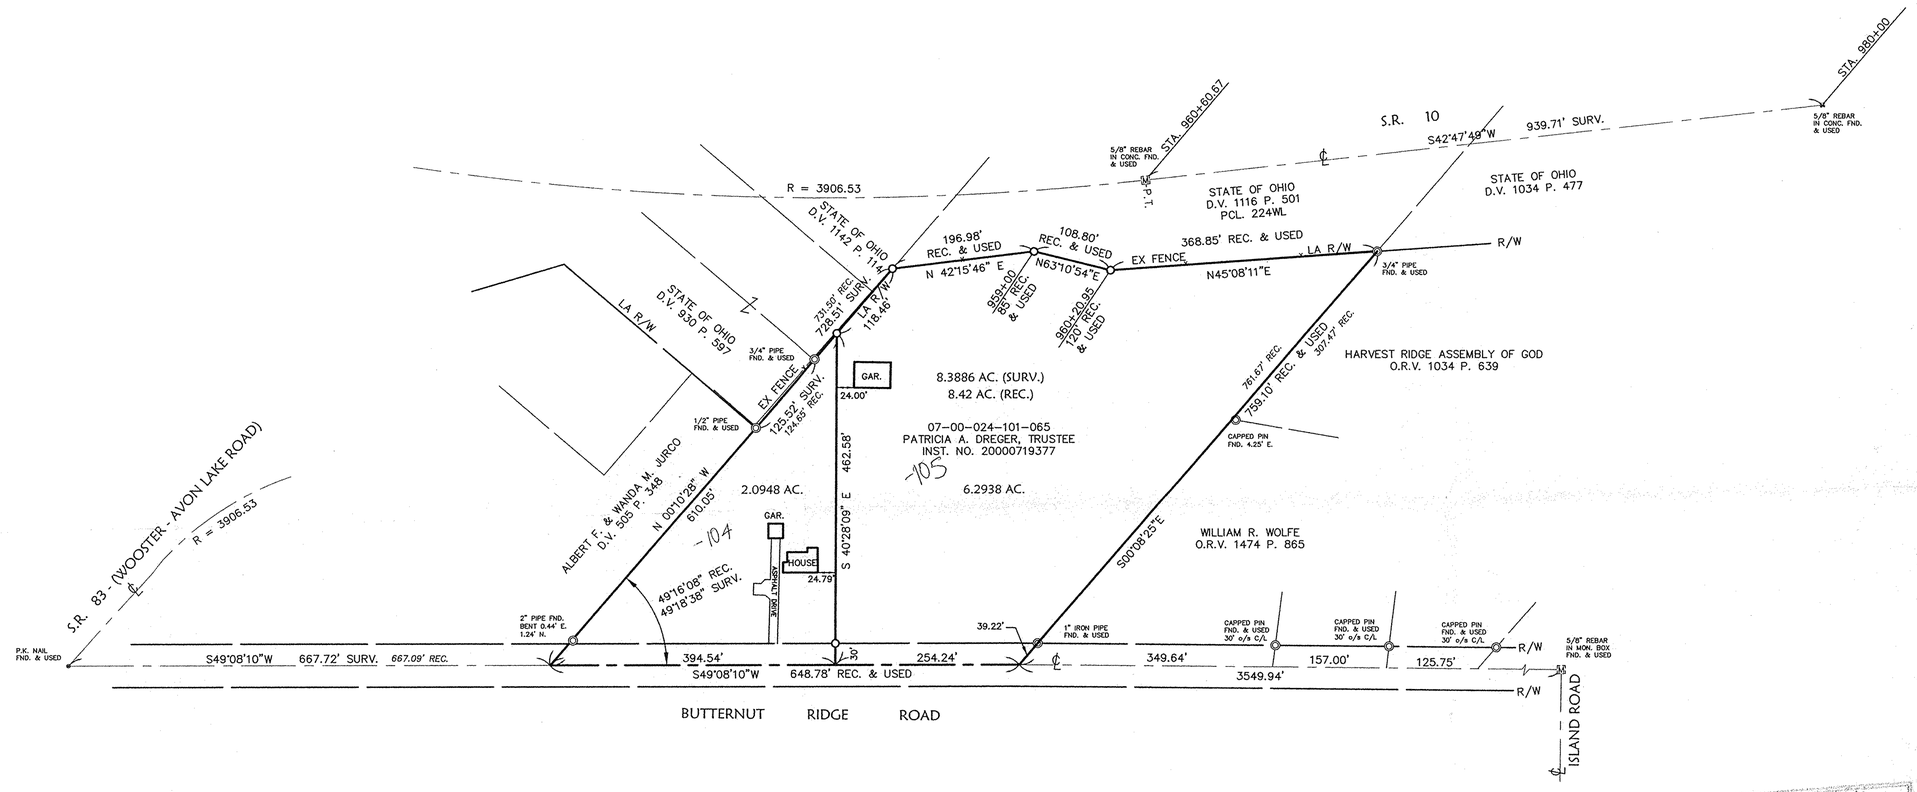

P.P. NO. 07-00-024-101-105, 104	
SPLIT # 00763	DATE OF SURVEY
MAP PAGE 07-00-024-C	
SURVEYOR KSA	

0

00763

APPROVED
LORAIN CO.
MAP DEPT
DATE 5-30-01
PAGE 7-00-024-C
BY J Hatfield
01-00763

STATE OF OHIO
DAVID L. ELWELL
6333
REGISTERED SURVEYOR

David L. Elwell
DAVID L. ELWELL, REG. SURVEYOR NO. 6333

DATE: 4-12-01
DRAWN BY: AMK
CH'D BY:
DWG. NAME: 0-SURV01
PATH: R:\01000\01125\LDDT\
F.B.

REVISIONS

DATE	DESCRIPTION	BY

KS ASSOCIATES
KS ASSOCIATES, INC.
260 Burns Road, Suite 100
P.O. Box 569
Elyria, Ohio 44036
Phone (440) 365-4730
Fax (440) 365-4790
mailroom@ksassoc.com
www.ksassoc.com

SURVEY MAP

PART OF ORIGINAL RIDGEVILLE TOWNSHIP LOT NO. 24
CITY OF NORTH RIDGEVILLE COUNTY OF LORAIN
STATE OF OHIO

SHEET 1 OF 1

JOB NO. 01125