07-00-024-C #9025 07-00-024-~~000~~ 102

P.P. NO. 07-00-024-102-018	
SPLIT # 9025	DATE OF SURVEY 5-76
MAP PAGE 07-00-024-D	
SURVEYOR Mc Glinchy & Assoc	

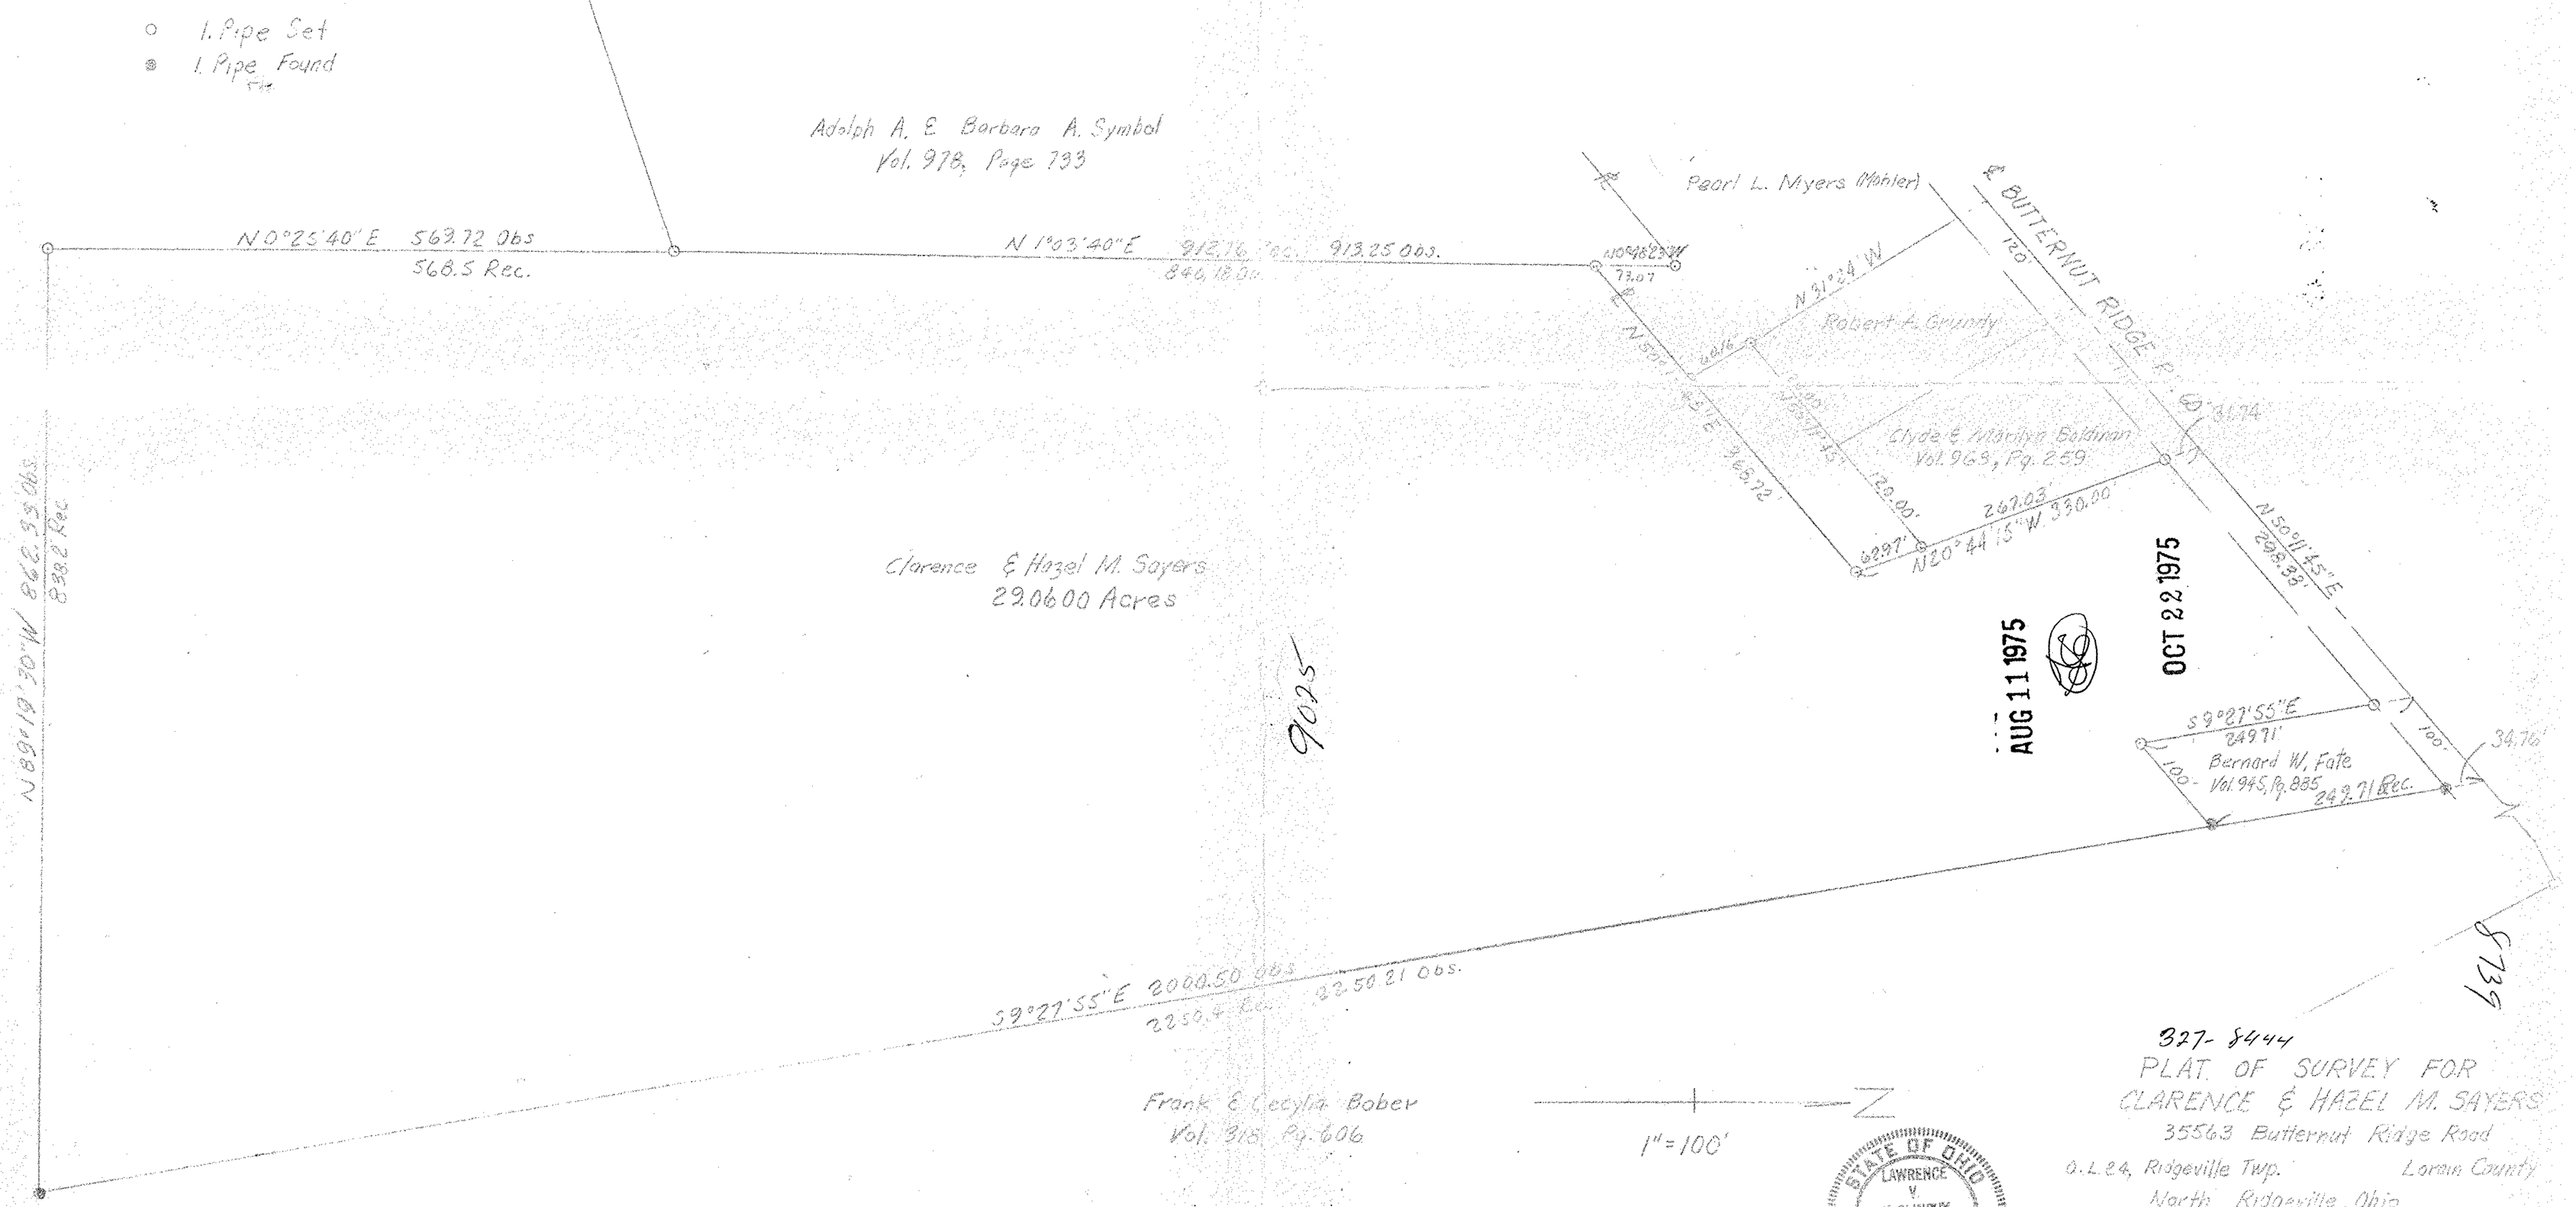

327-8444

PLAT OF SURVEY FOR
CLARENCE & HAZEL M. SAYERS
35563 Butternut Ridge Road
O.L. 24, Ridgeville Twp. Lorain County
North Ridgeville, Ohio

McGLINCHY & ASSOCIATES
Professional Engineers & Surveyors
538 West Broad Street Elyria, Ohio
Tel. No. 74147

STATE OF OHIO
LAWRENCE V. McGLINCHY
4970
REGISTERED SURVEYOR

May, 1976

07-00-024-~~000~~ 102 #9025 7-00-024-C