FILE NO. 07-00-024-102-046,045	
SPLIT # 00044	DATE OF SURVEY
MAP PAGE 07-00-024-C1D	
SURVEYOR Dane A. Haparek	

SURVEY

OF PART OF

ORIGINAL RIDGEVILLE TWP LOT 24

CITY OF N. RIDGEVILLE COUNTY OF LORAIN

STATE OF OHIO

PREPARED BY:

HAPAREK AND ASSOC
SURVEYORS
N. RIDGEVILLE, OH

PREPARED FOR:

BERNARD W. AND NANCY L. FATE
39541 BUTTERNUT RIDGE ROAD
N. RIDGEVILLE, OH

NOTE: SURVEY BASED ON McCLINCHY SURVEY DV 107 P 418

DATE: DEC 1998
SCALE: 1" 100'

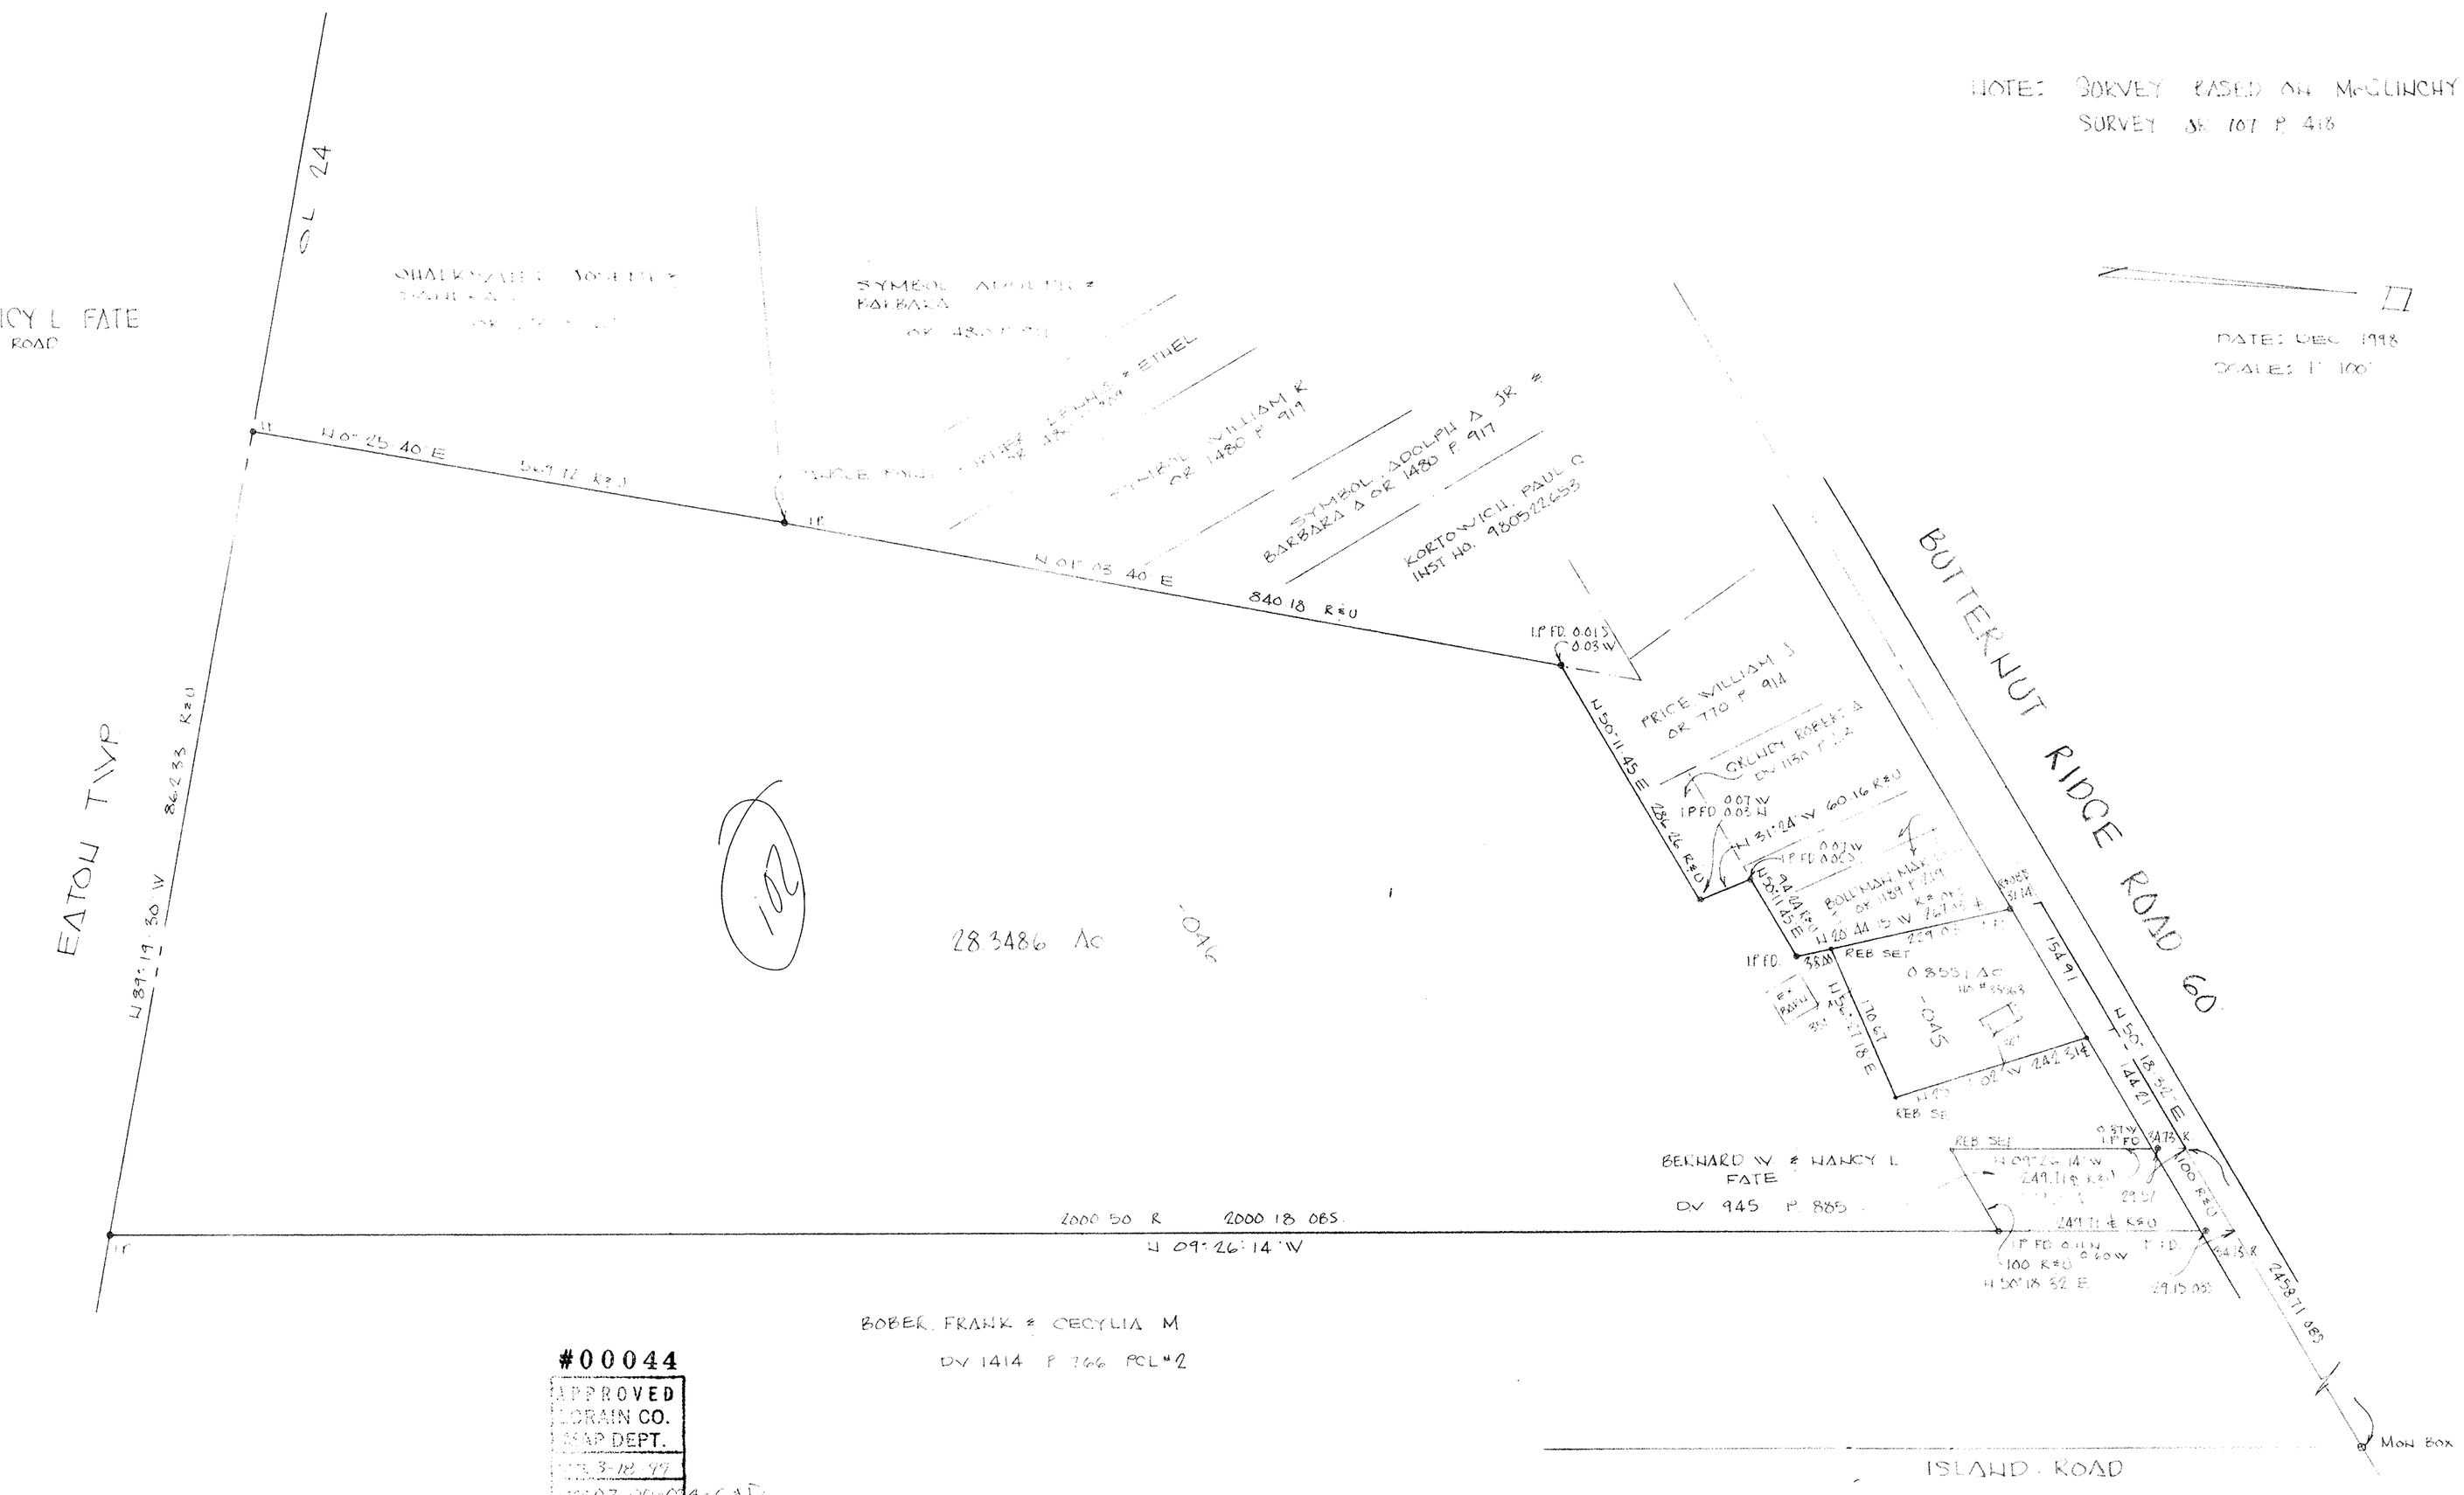

#00044

APPROVED
LORAIN CO.
MAP DEPT.
DATE 3-12-99
07-00-024-C1D
BY
00044

92 05