PART OF ORIGINAL RIDGEVILLE TOWNSHIP LOTS 27 AND 28
NOW CITY OF NORTH RIDGEVILLE, COUNTY OF LORAIN
STATE OF OHIO

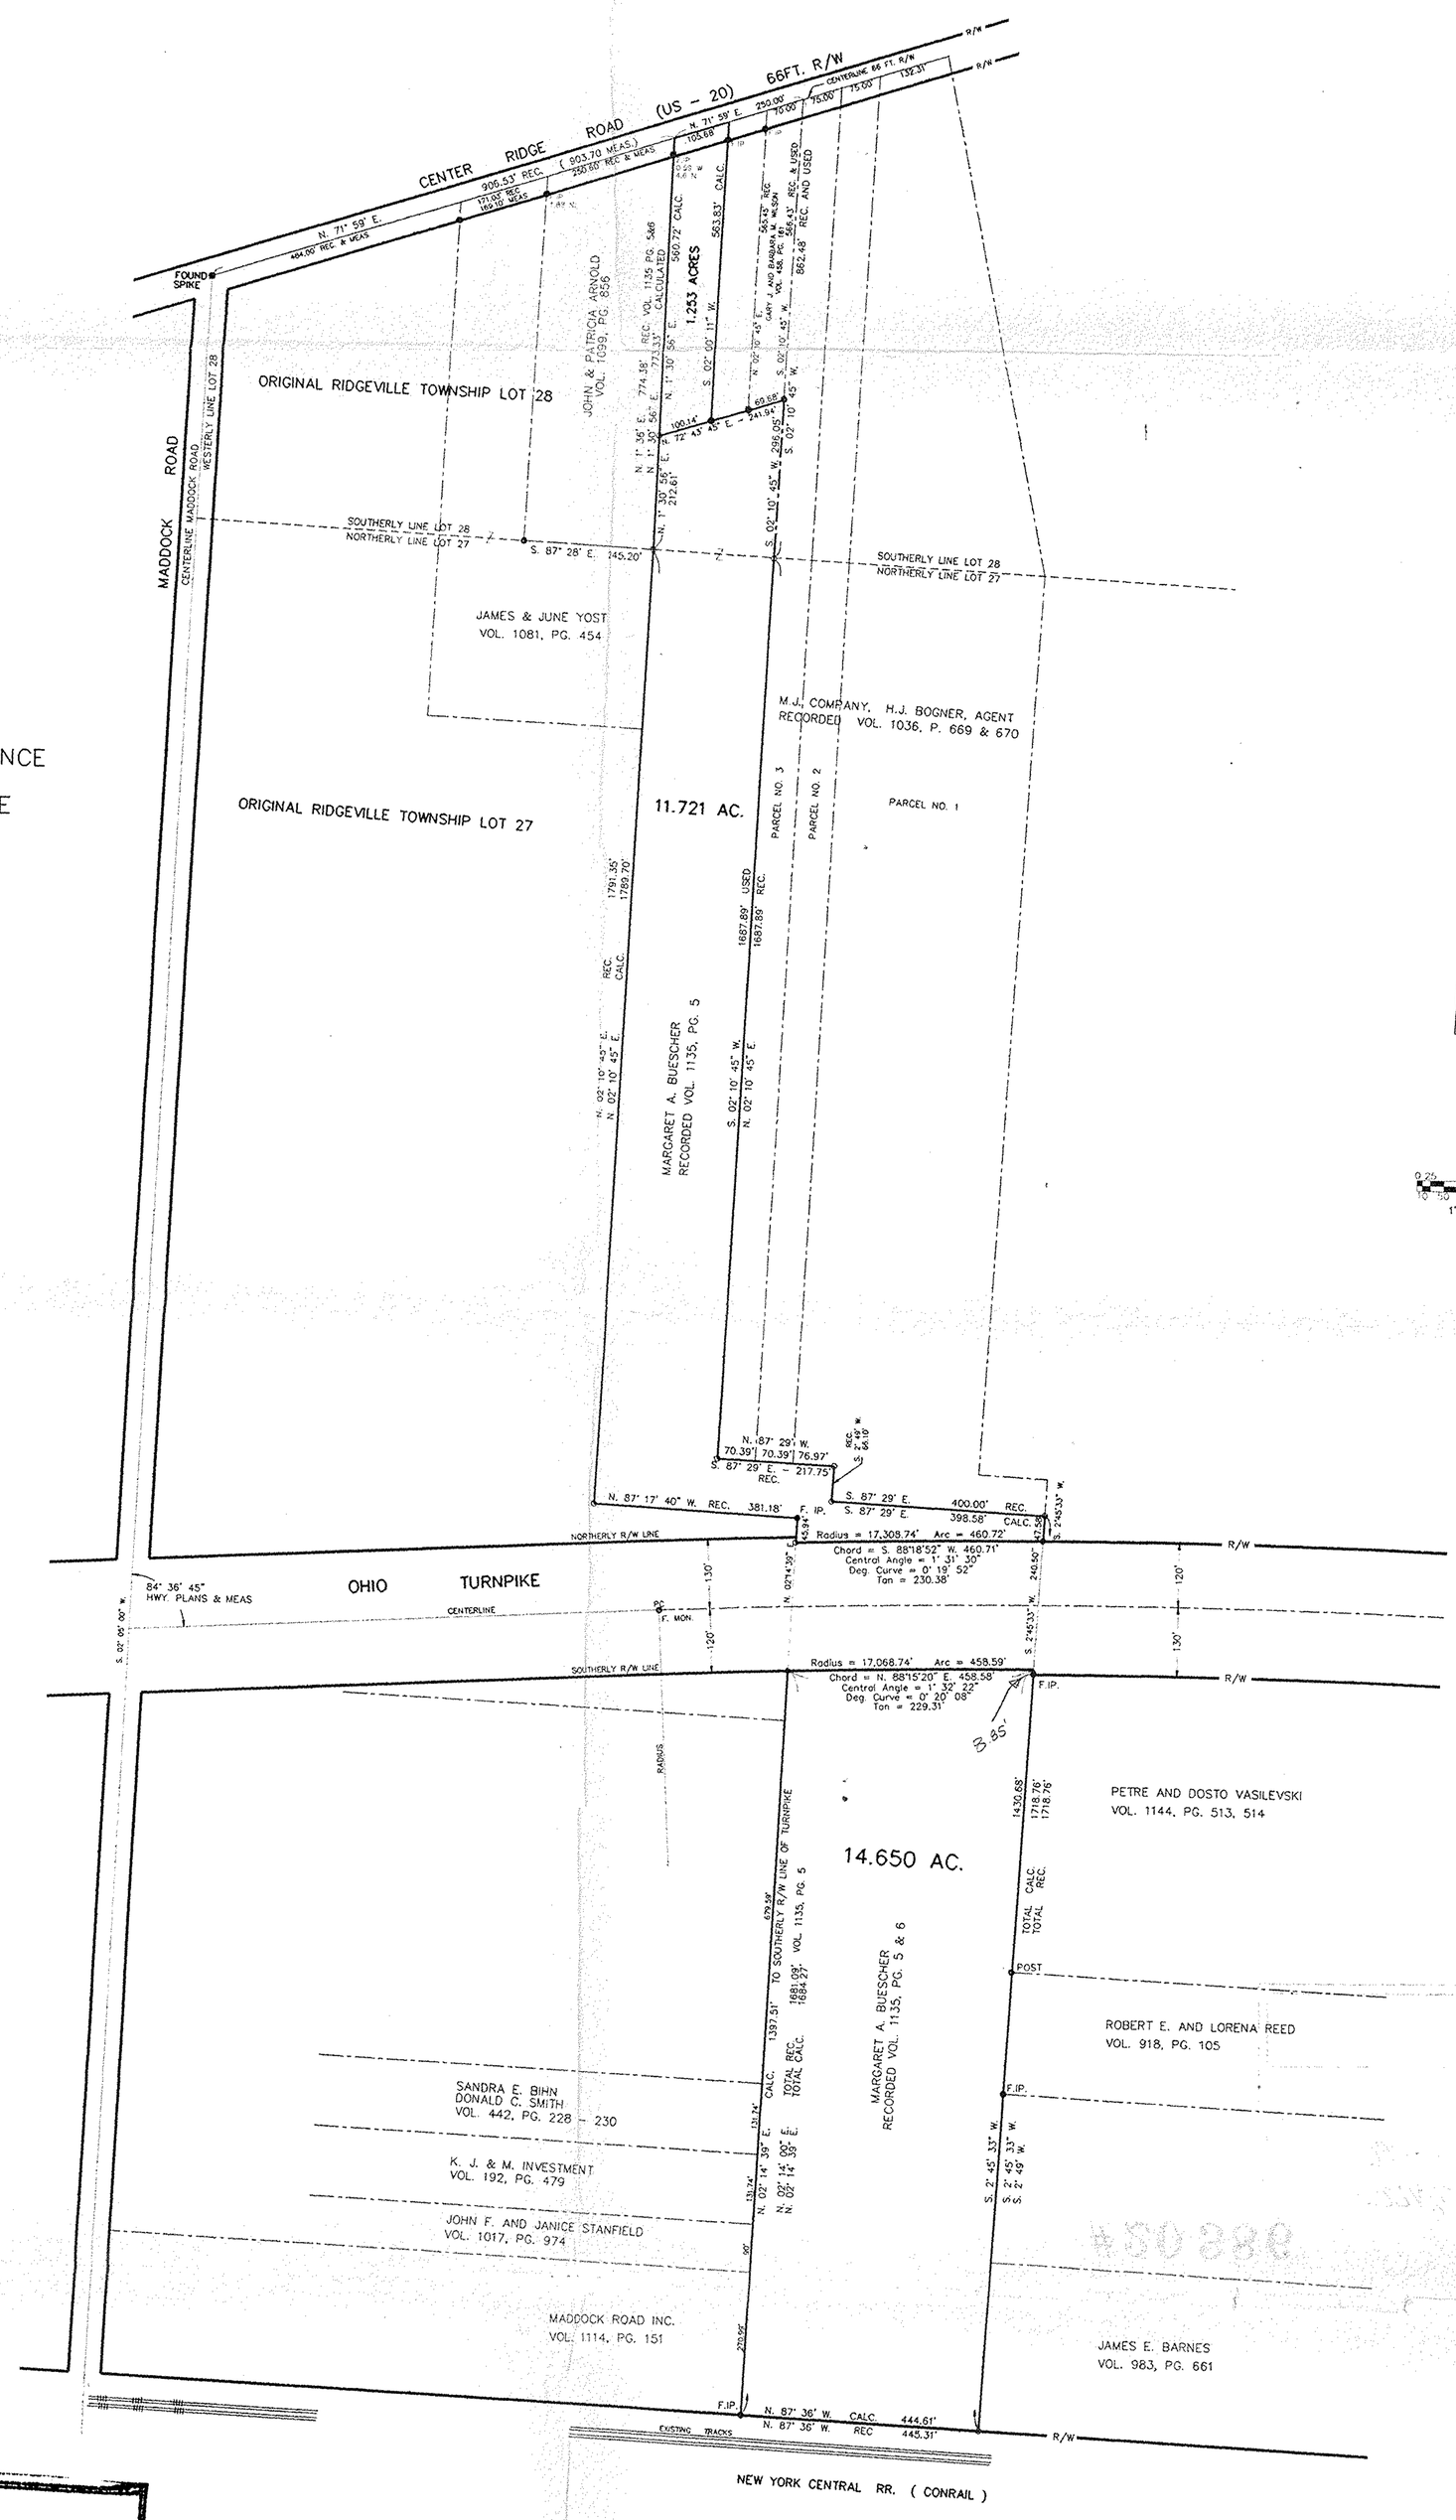

LEGEND

R/W = RIGHT-OF-WAY
F. IP. = FOUND IRON PIPE
F. MON. = FOUND MONUMENT
REC. = RECORDED DEED BEARING OR DISTANCE
MEAS. = MEASURED BEARING OR DISTANCE
CALC. = CALCULATED BEARING OR DISTANCE
o = IRON ROD WITH I.D. CAP SET

N

07-00-027-101
07-00-027-109
07-00-028-103

20386

APPROVED
LORAIN CO.
MAP DEPT.
DATE 6-4-93
PAGE 7-00-028- -027 A- C C
BY CAROLYN FRANCIS
VOID AFTER # 20386

1" = 200'

P.P. NO. 07-00-027-101-099, 100	
SPLIT # 20386	**DATE OF SURVEY**
MAP PAGE 07-00-027-A,C	
SURVEYOR James M. Loch	

STATE OF OHIO
JAMES M. LOCH
6468
REGISTERED SURVEYOR

I HEREBY CERTIFY THIS SURVEY TO BE CORRECT TO THE BEST OF MY KNOWLEDGE.

JAMES M. LOCH
OHIO R.L.S. No. 6468