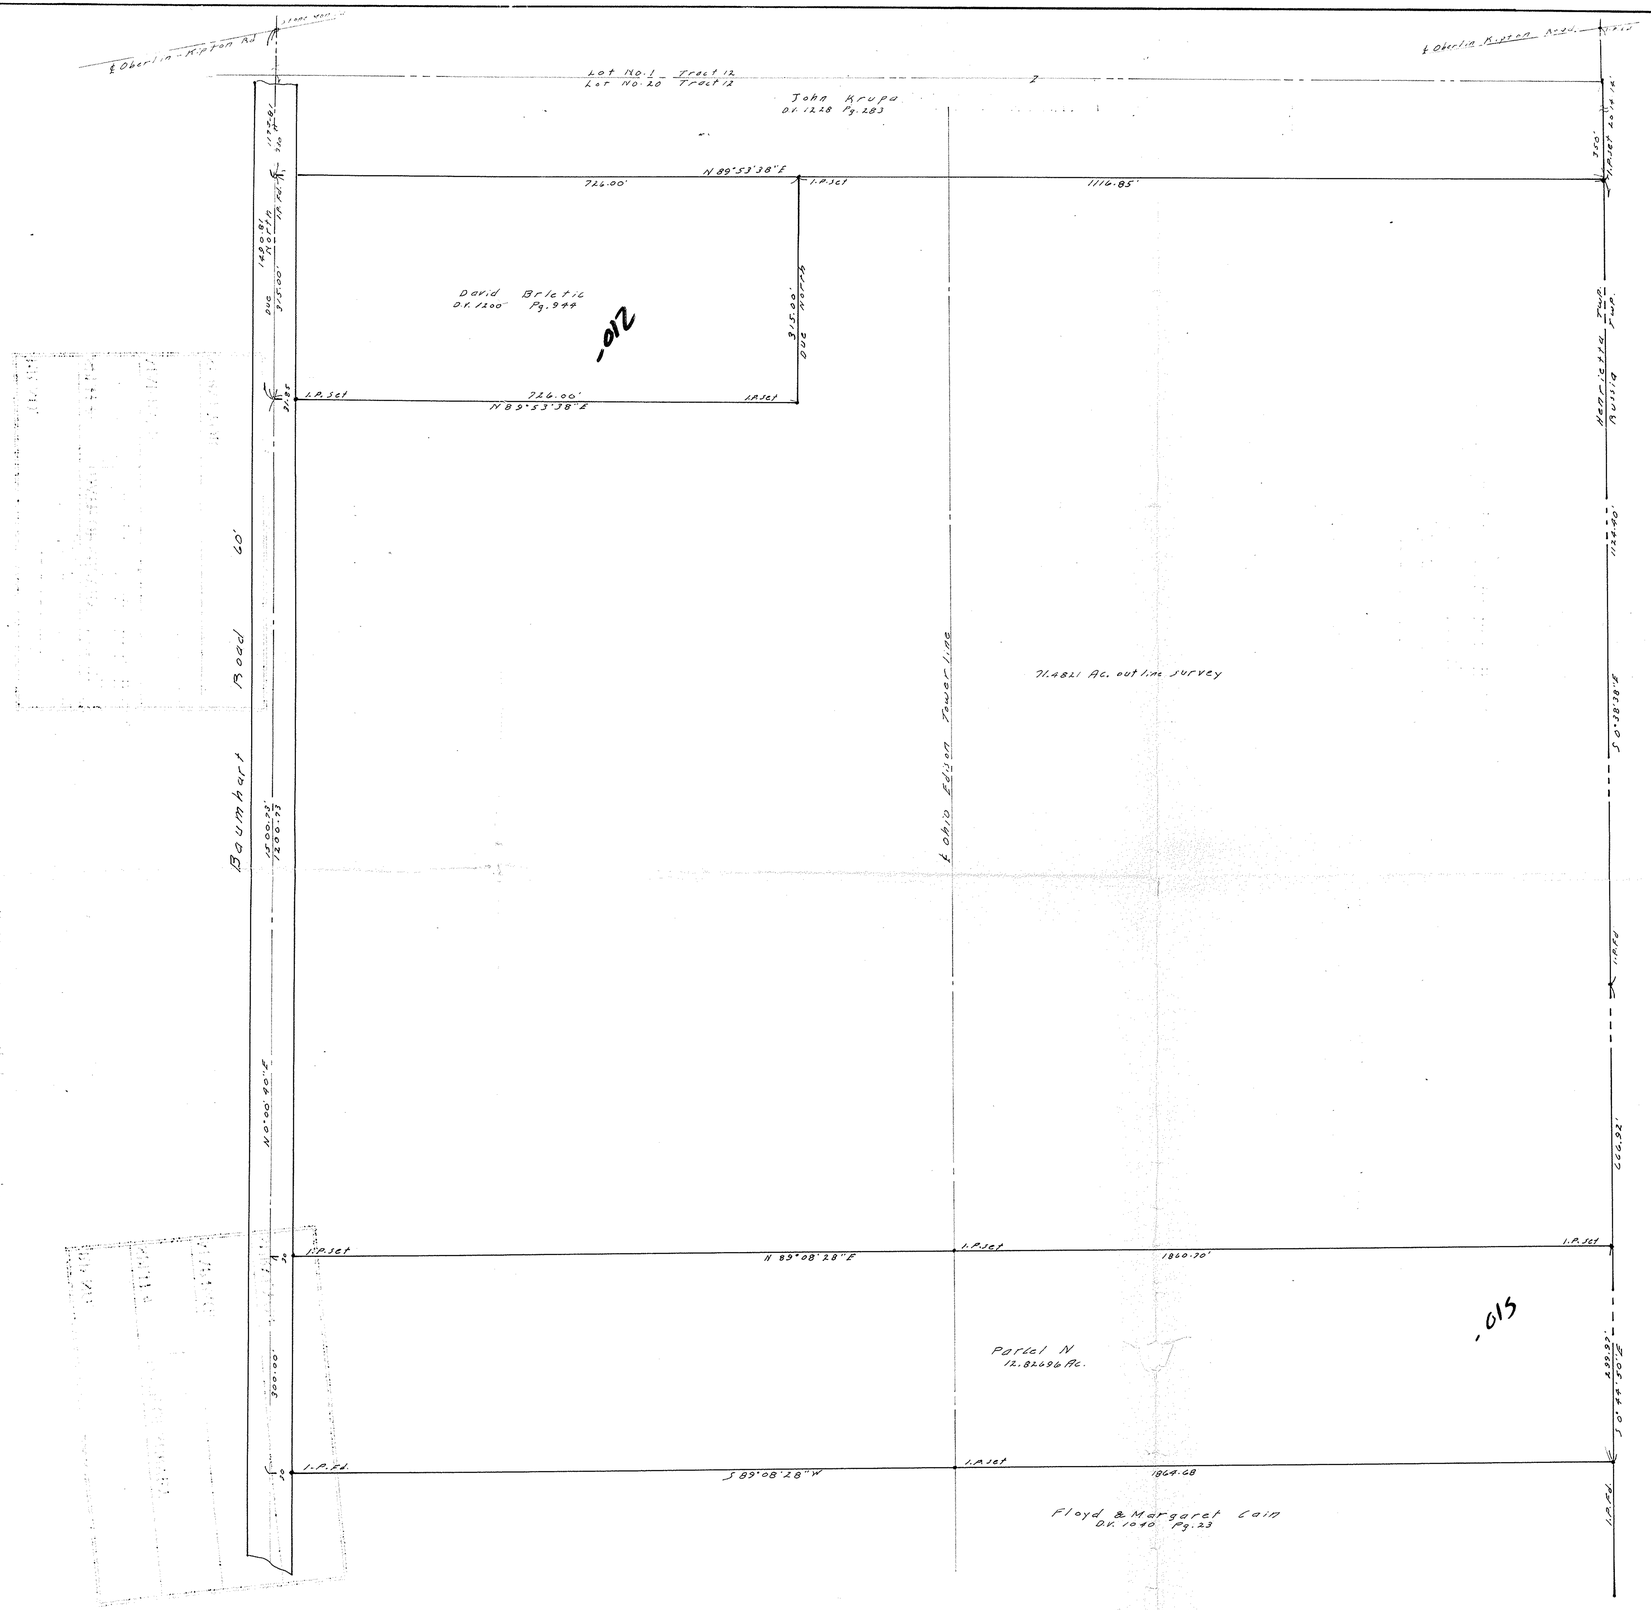

P.P. NO. 08-12-020-000-012,013	
SPLIT # 16550	DATE OF SURVEY Dec. 13, 1985
MAP PAGE 8-H	
SURVEYOR William B. Barton	

SURVEY
of
Part of Lot No. 20 Tract No. 12 of Henrietta Township, Lorain County Ohio By William B. Barton Reg. Surveyor No. 4438. December 13, 1985.
Scale 1" = 100'

N.

#16550
APPROVED
LORAIN CO.
MAP DEPT.
DATE 1-16-86
PAGE 8-H
BY T. McNair
VOID

STATE OF OHIO
WILLIAM B. BARTON
4438
REGISTERED
SURVEYOR

2-062