P.P. NO. 07-00-028-161-090	
SPLIT # 19621	**DATE OF SURVEY**
MAP PAGE 07-00-028-A	
SURVEYOR Dane A. Haponek	

SURVEY

OF PART OF

ORIGINAL RIDGEVILLE TWP

LOT Nº 28

CITY OF N RIDGEVILLE COUNTY OF LORAIN

STATE OF OHIO

PREPARED FOR:

ARGENE CARR
6744 STONEY RIDGE RD.
N RIDGEVILLE, O

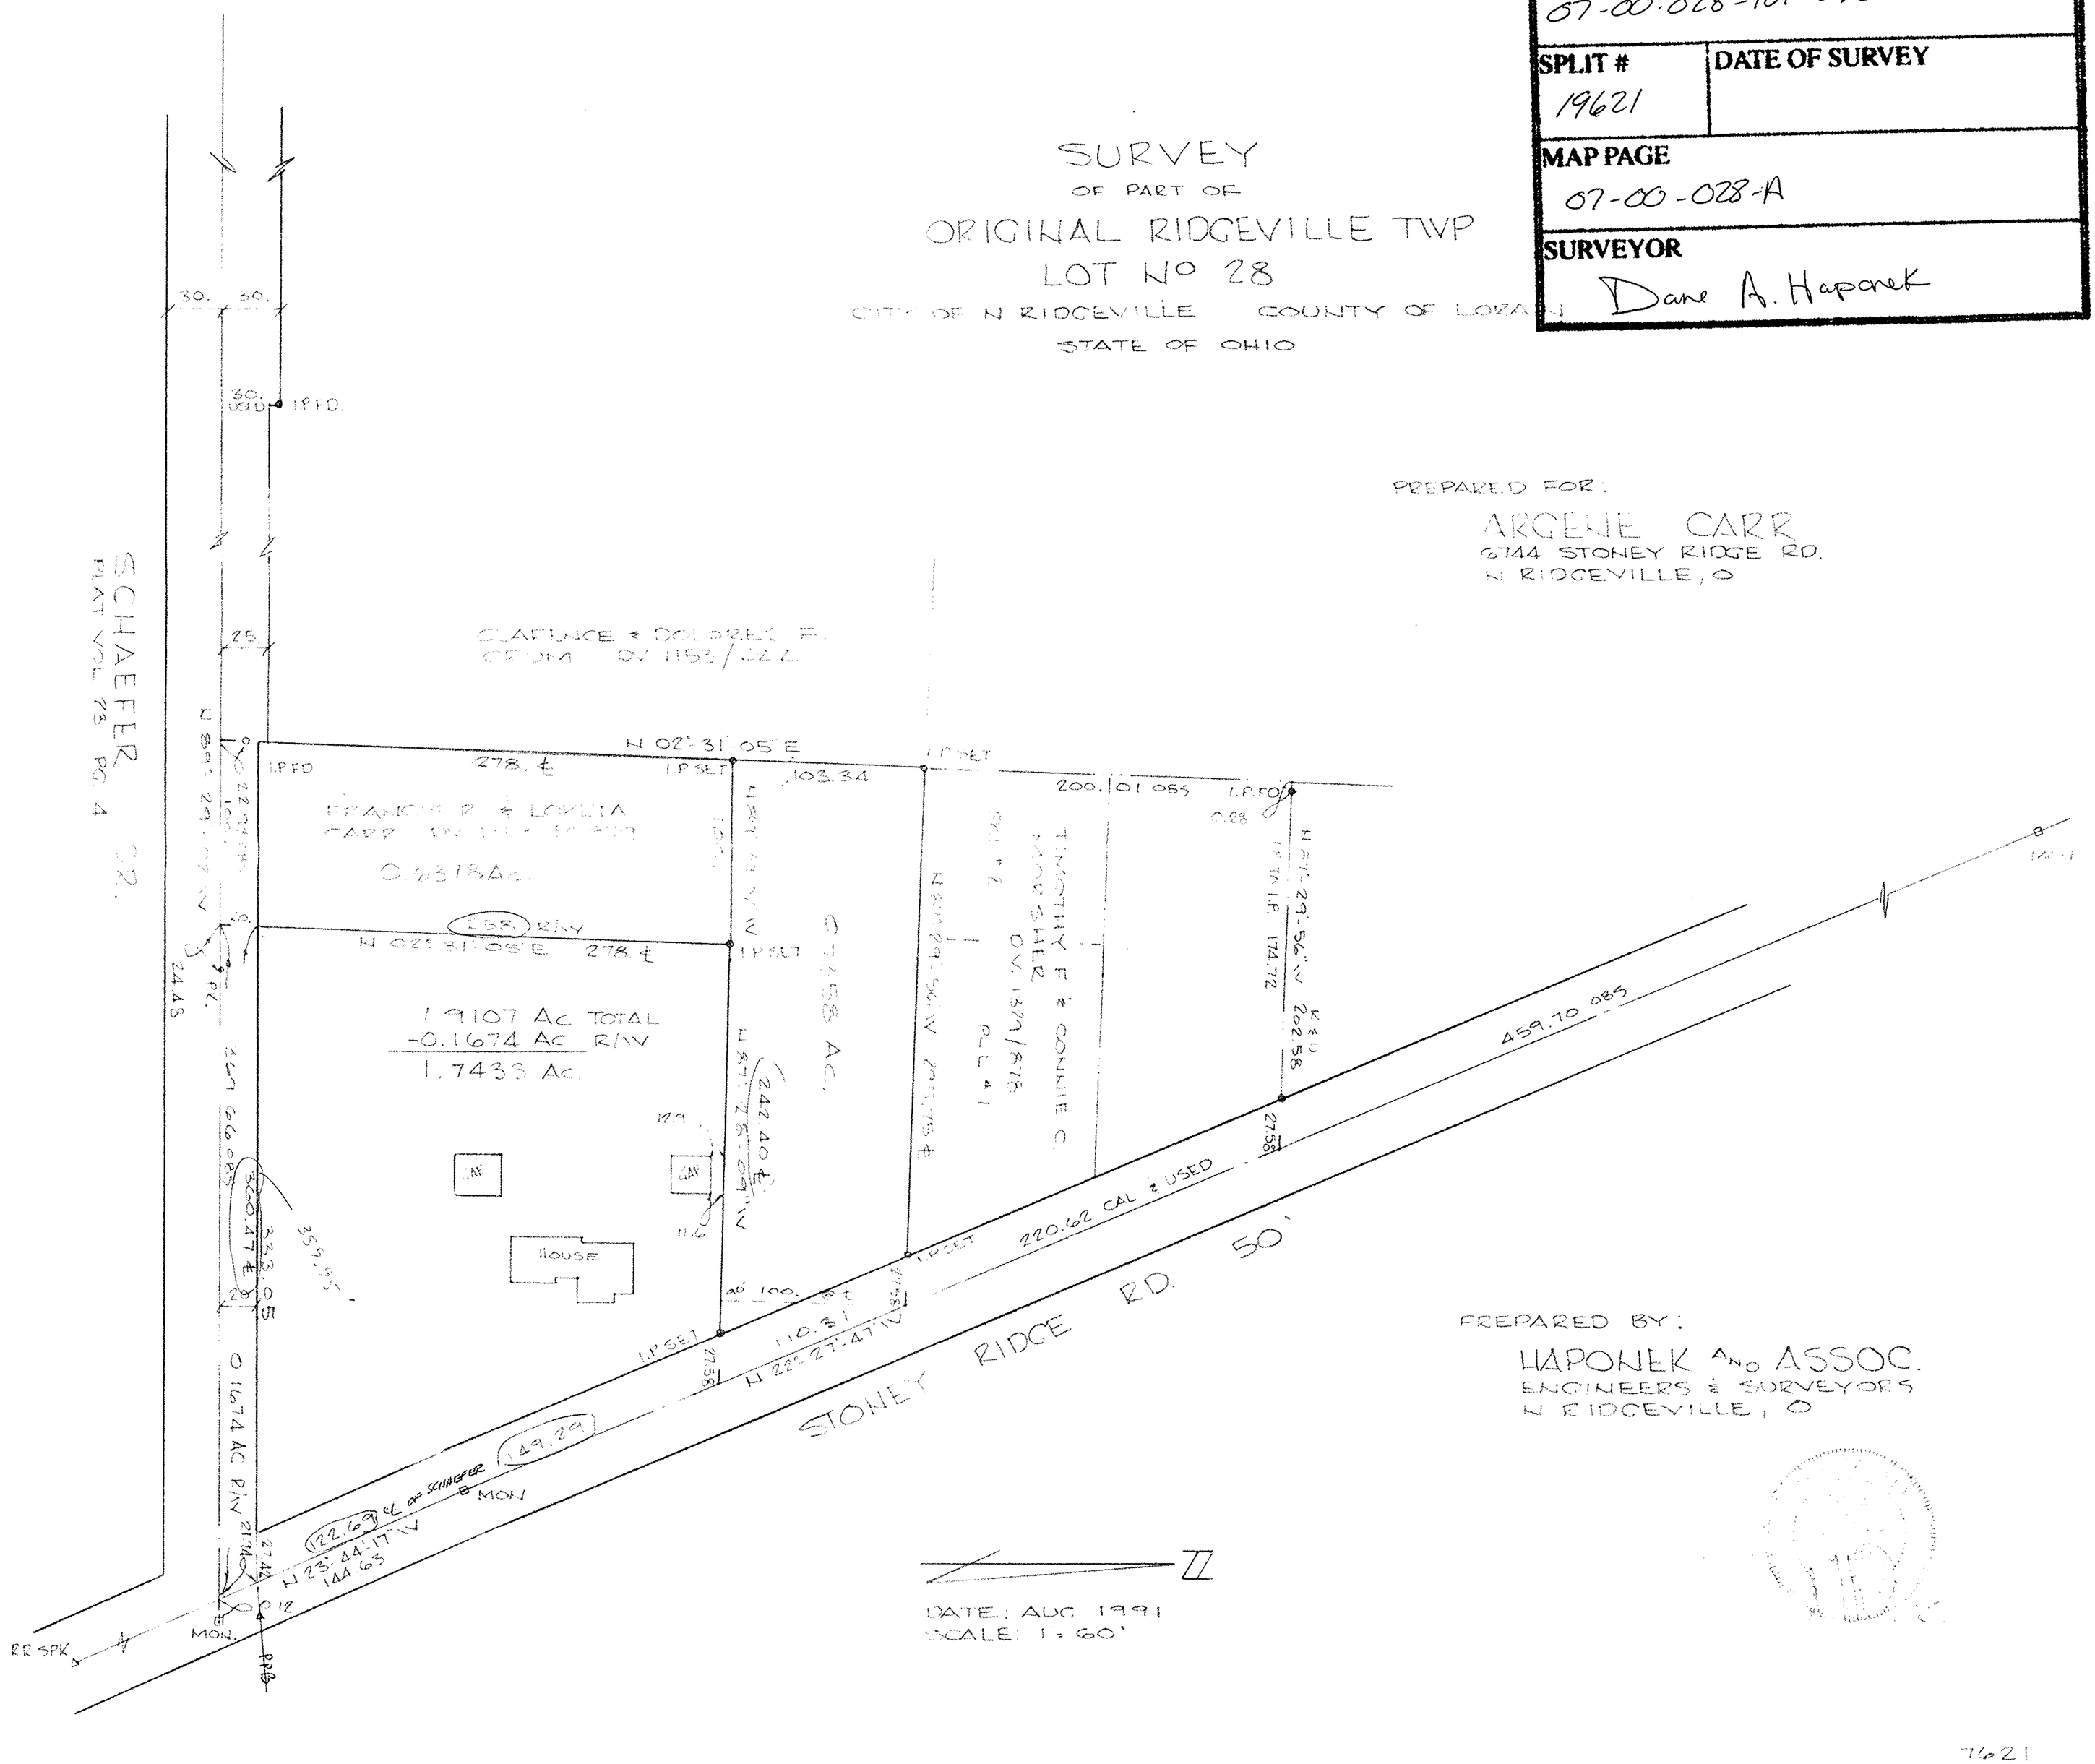

PREPARED BY:

HAPONEK AND ASSOC.
ENGINEERS & SURVEYORS
N RIDGEVILLE, O

DATE: AUG 1991
SCALE: 1" = 60'

19621