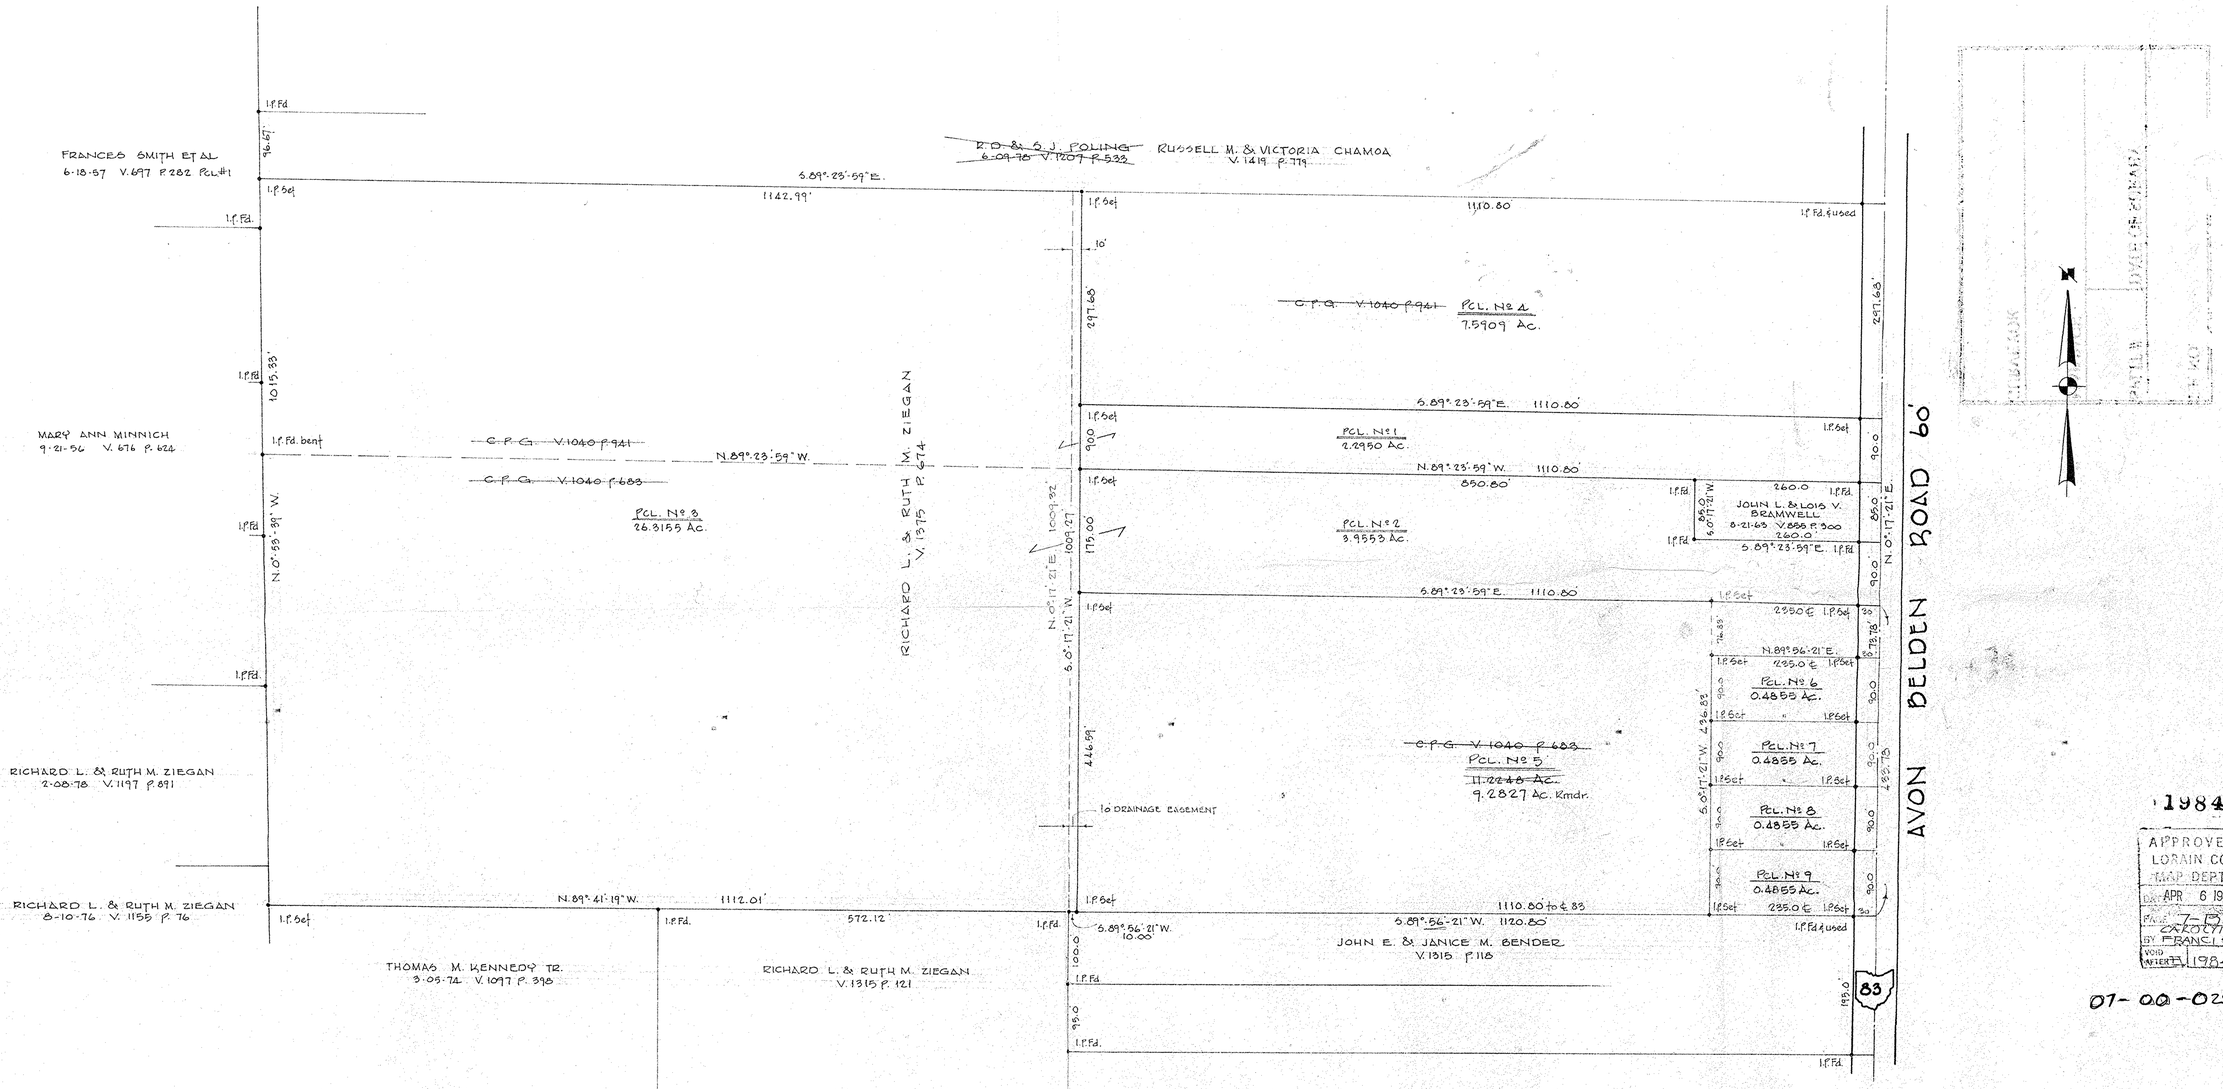

19847

APPROVED
LORAIN CO.
MAP DEPT.
DATE APR 6 1992
PCL. 7-9
CARDYN
BY FRANCIS
VOID AFTER 19847

07-00-029-000-050

SURVEY OF

C. P. GILGENBACH LANDS

PART OF O.L. 29 RIDGEVILLE TWP.
COUNTY OF LORAIN
SCALE 1" = 100'

CITY OF NORTH RIDGEVILLE
STATE OF OHIO
JAN. 9, 1985

LAUNDON • SIMON • CAHL & ASSOC.
ENGINEERS SURVEYORS
JOB Nº 84-1342 F.B. 98 P. 58

REV. 7-5-90 Addn. of Pcl's. 6, 7, 8, 9 — FOR LASZLO AND EVA HORVATH (90-1940) & rev. of Pcl. Nº 5
REV. 7-10-89 Addn. of Pcl's. 4 & 5
REV. 5-23-85 10' DR. EASMT