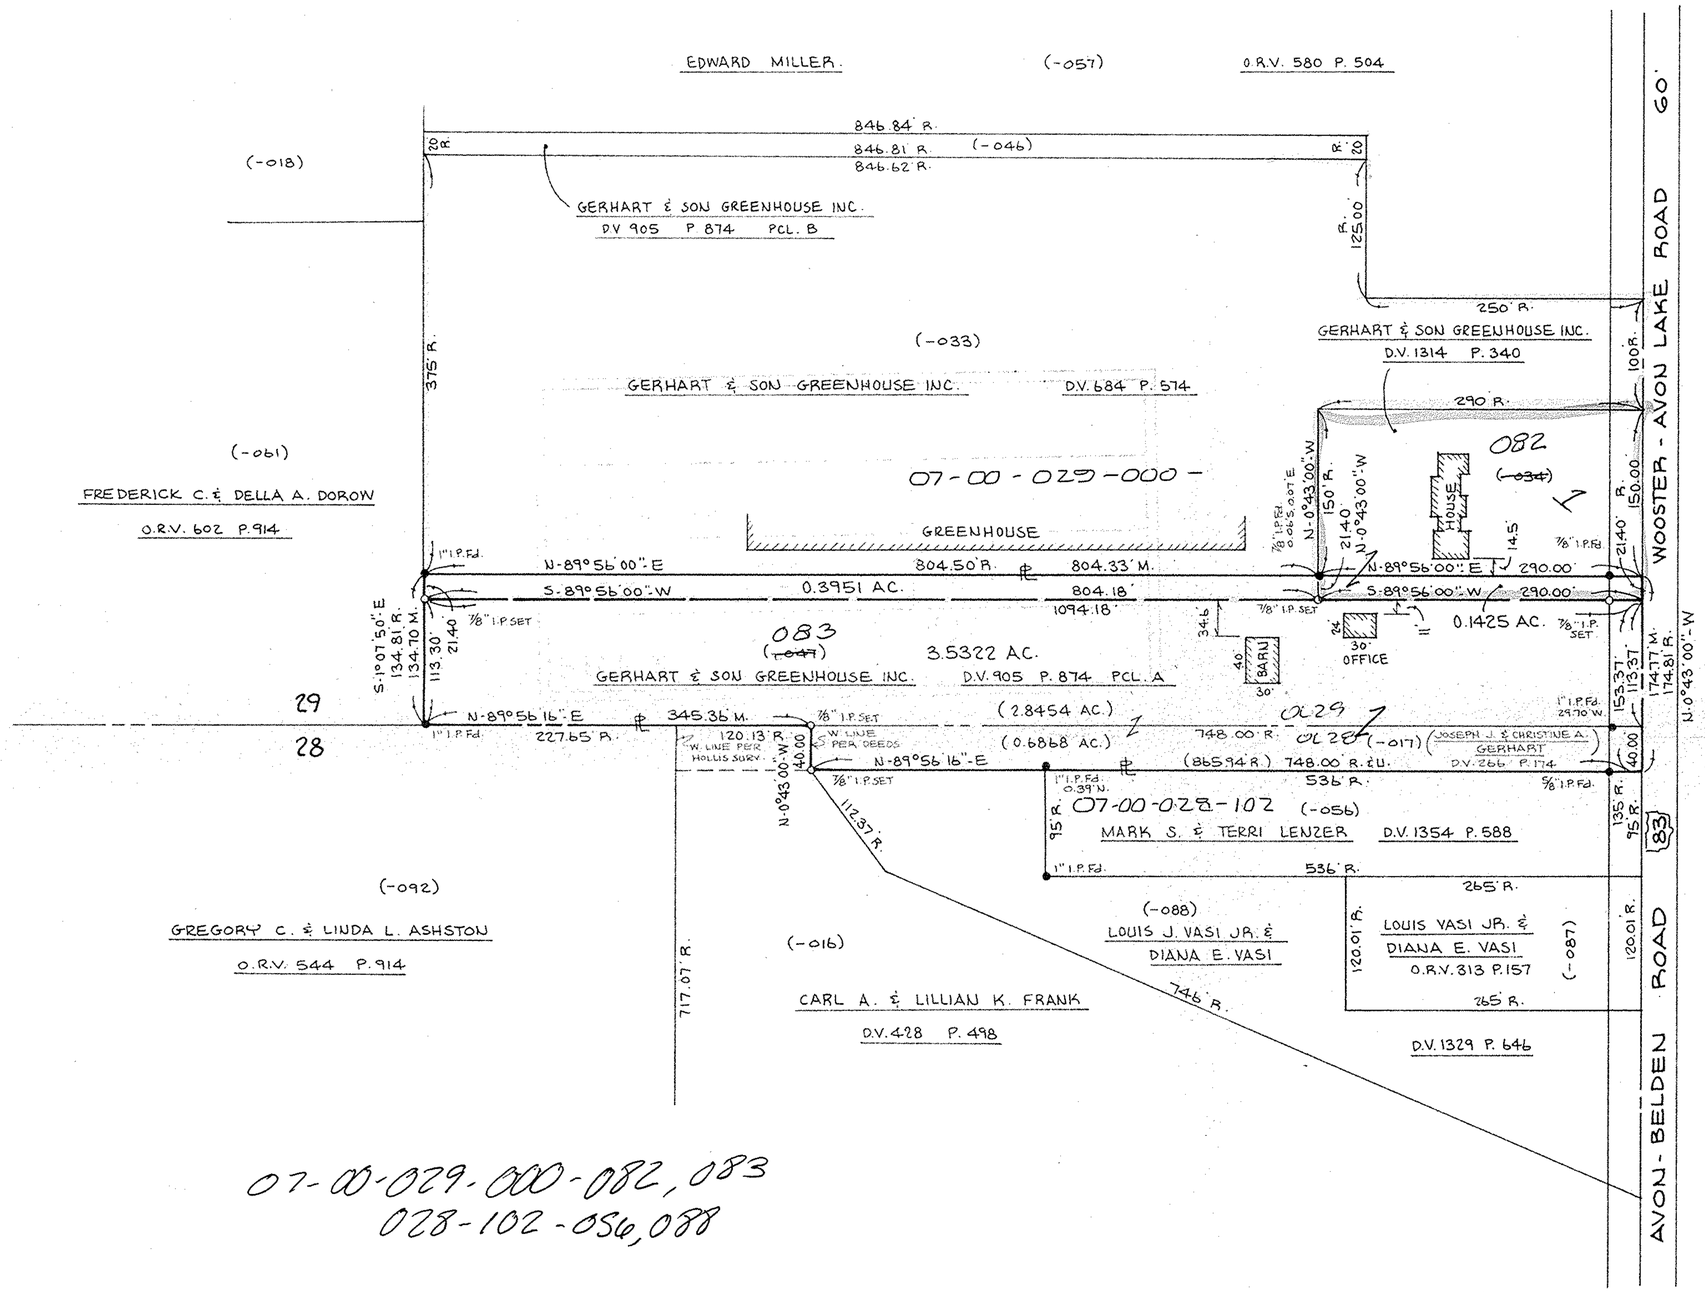

07-00-029-000-082, 083
028-102-056, 088

BOUNDARY SURVEY

PART OF RIDGEVILLE TOWNSHIP ORIG. LOTS Nos 28 & 29

CITY OF NORTH RIDGEVILLE COUNTY OF LORAIN

STATE OF OHIO

STATE OF OHIO
DAVID L. ELWELL
6333
REGISTERED SURVEYOR

PREPARED BY

KS ASSOCIATES INC.

ENGINEERS SURVEYORS

David L. Elwell

DAVID L. ELWELL REG. SURV. NO. 6333

20795

APPROVED
LORAIN CO.
MAP DEPT.

DATE 4-11-94
7-00-028-B
PAGE 7-00-029-D
BY CAROLYN FRANCIS
VOID AFTER # 20795

94-033