07-00-029-000-086,085
028-102-096

SURVEY

OF PART OF

ORIGINAL RIDGEVILLE LOTS 28 & 29

CITY OF N. RIDGEVILLE COUNTY OF LORAIN

STATE OF OHIO

PREPARED BY:
HAPOWEK & ASSOC.
SURVEYORS & ENGINEERS
N. RIDGEVILLE, OH.

PREPARED FOR:
FRED C. & DELLA A. DOROW
6305 STONEY RIDGE ROAD
N. RIDGEVILLE, OH

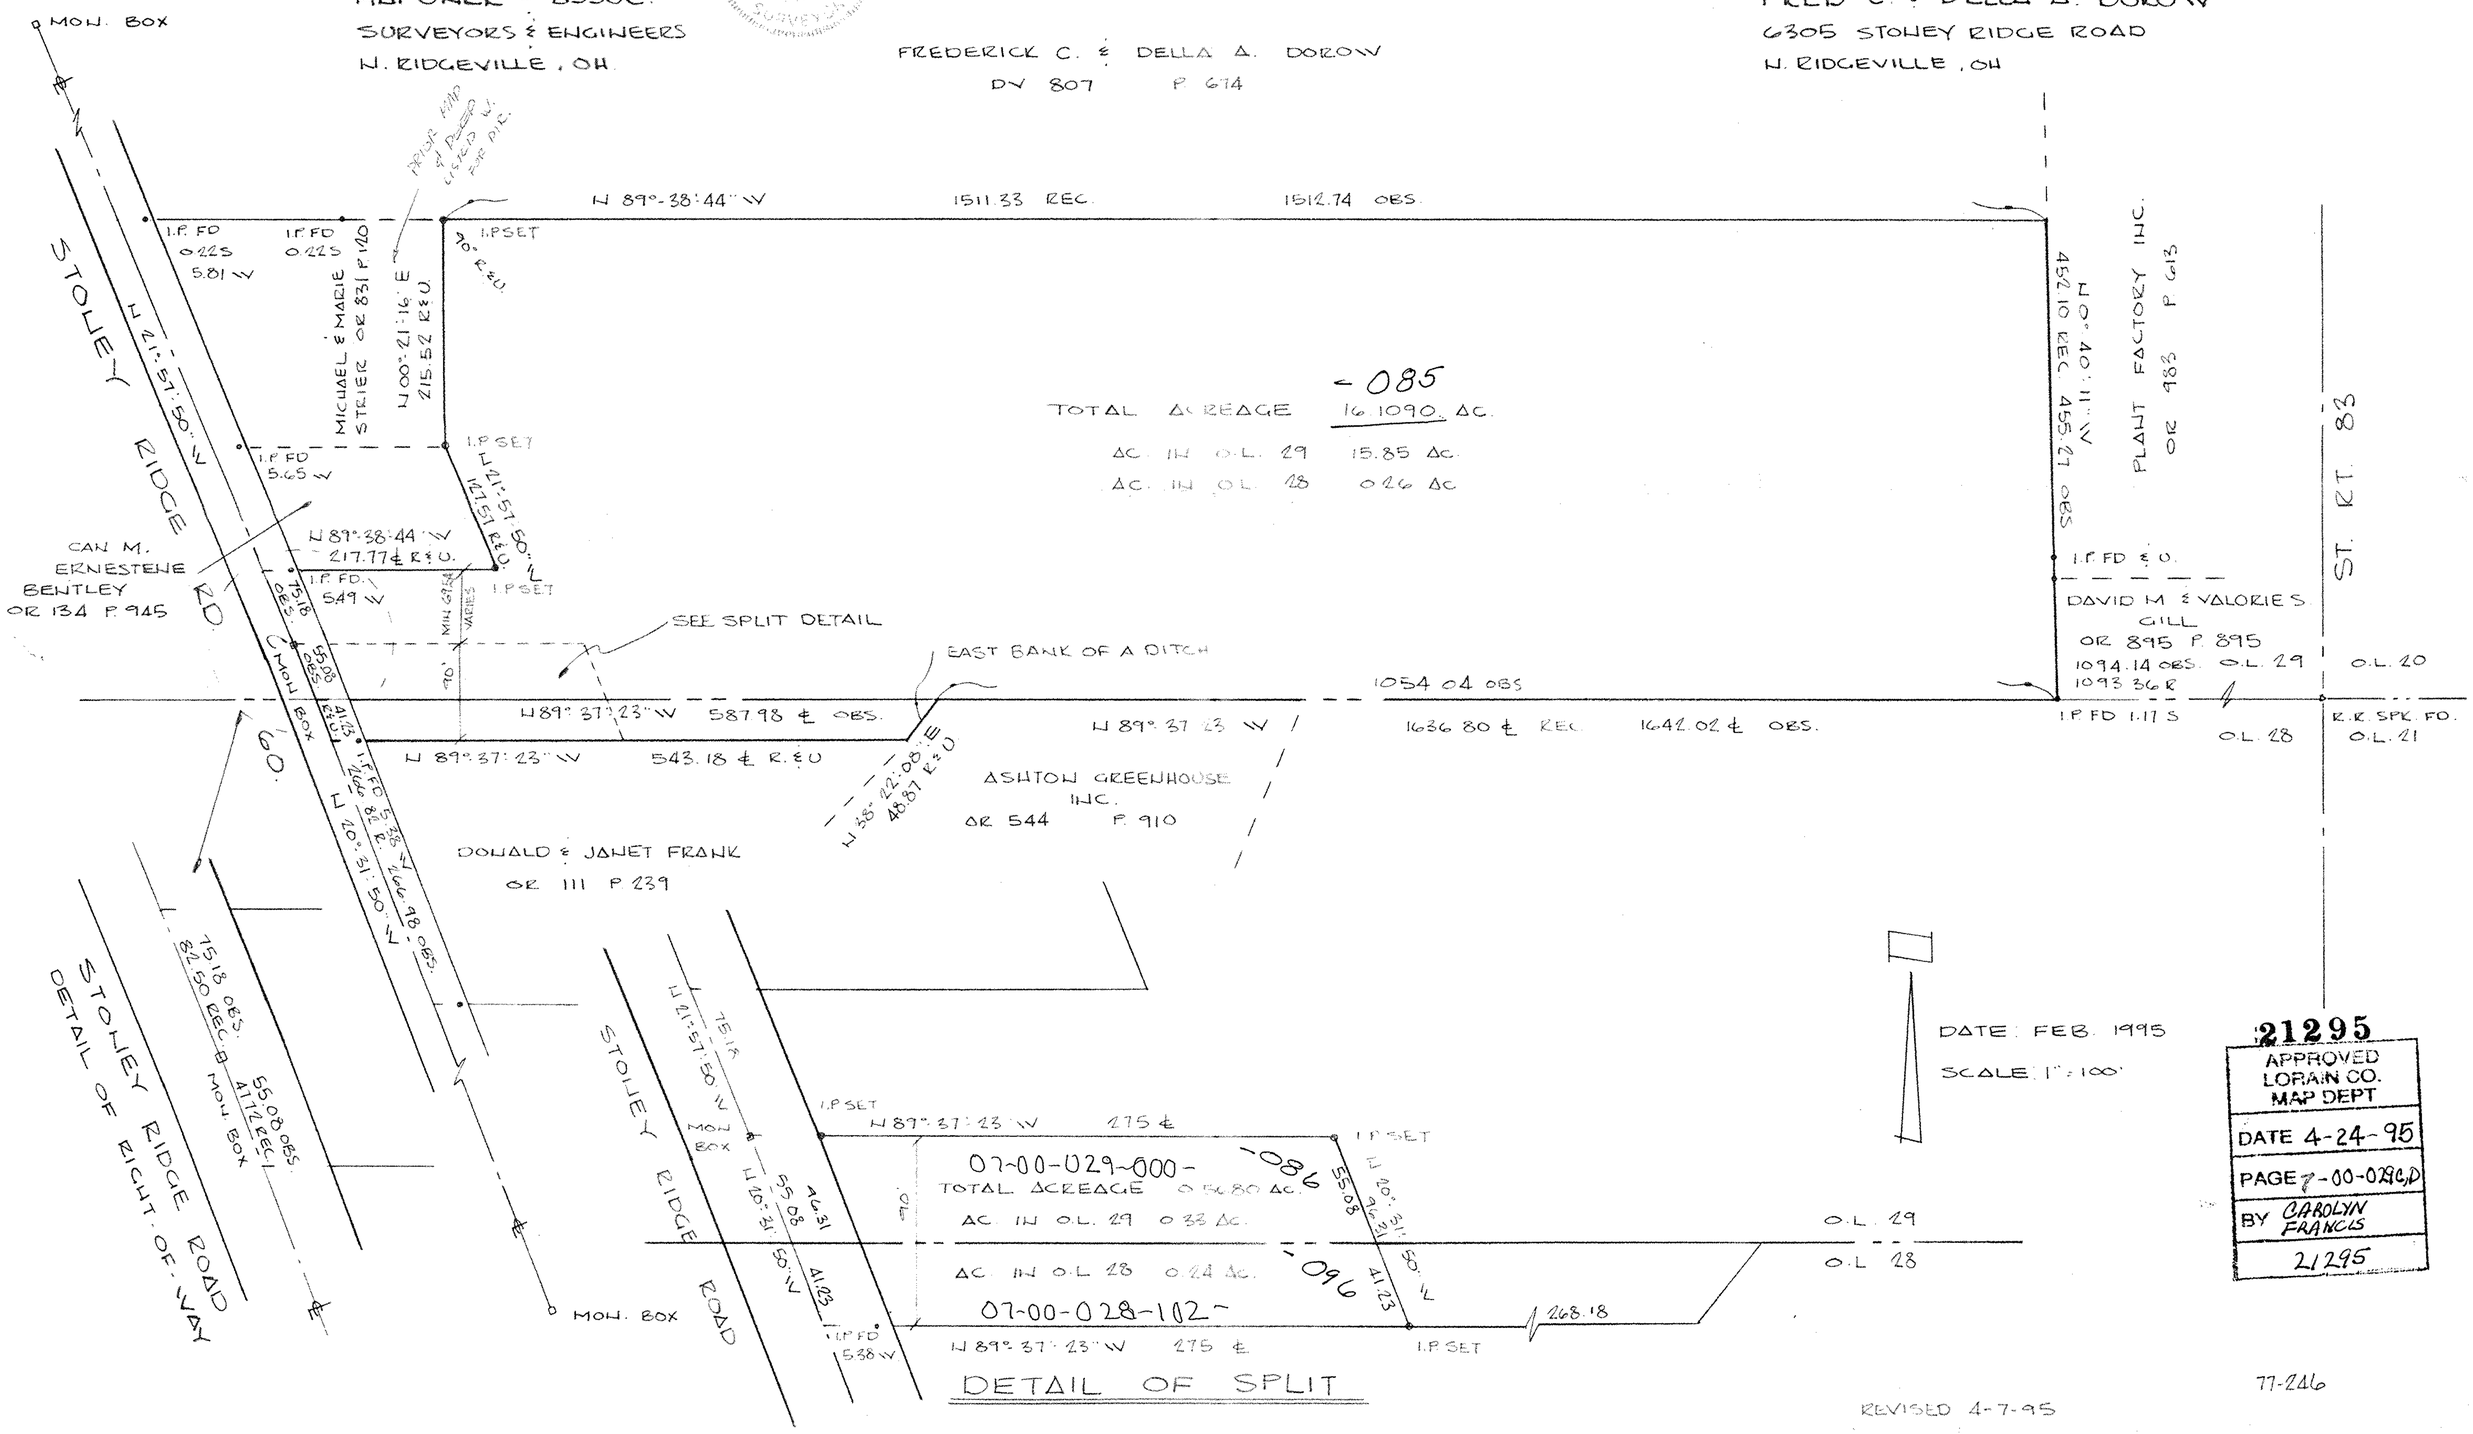

77-246

REVISED 4-7-95