APPROVED
LORAIN CO.
MAP DEPT.
20321
DATE
PAGE
BY
VOID
AFTER
RECEIVED
JAN 13 1993
LORAIN CO. ENGRS. OFFICE
APPROVED
JAN 13 1993
LORAIN CO. ENGRS. OFFICE

FOOR & ASSOCIATES, Inc.
FOOR & ASSOCIATES, INC.
ENGINEERS & SURVEYORS
35836 CENTER RIDGE
N. RIDGEVILLE, OHIO 44039
OFFICE 327-4776
CLEVELAND 779-5788
STATE OF OHIO
DANE A. HAPONEK
REGISTERED SURVEYOR

SURVEY

OF PART OF

ORIGINAL RIDGEVILLE TWP.
LOT No 30
CITY OF N RIDGEVILLE COUNTY OF LORAIN
STATE OF OHIO

DATE: NOV. 1979
SCALE: 1" = 100'

PREPARED FOR:

BEN JANAS
36375 MILLS ROAD
N. RIDGEVILLE, OHIO

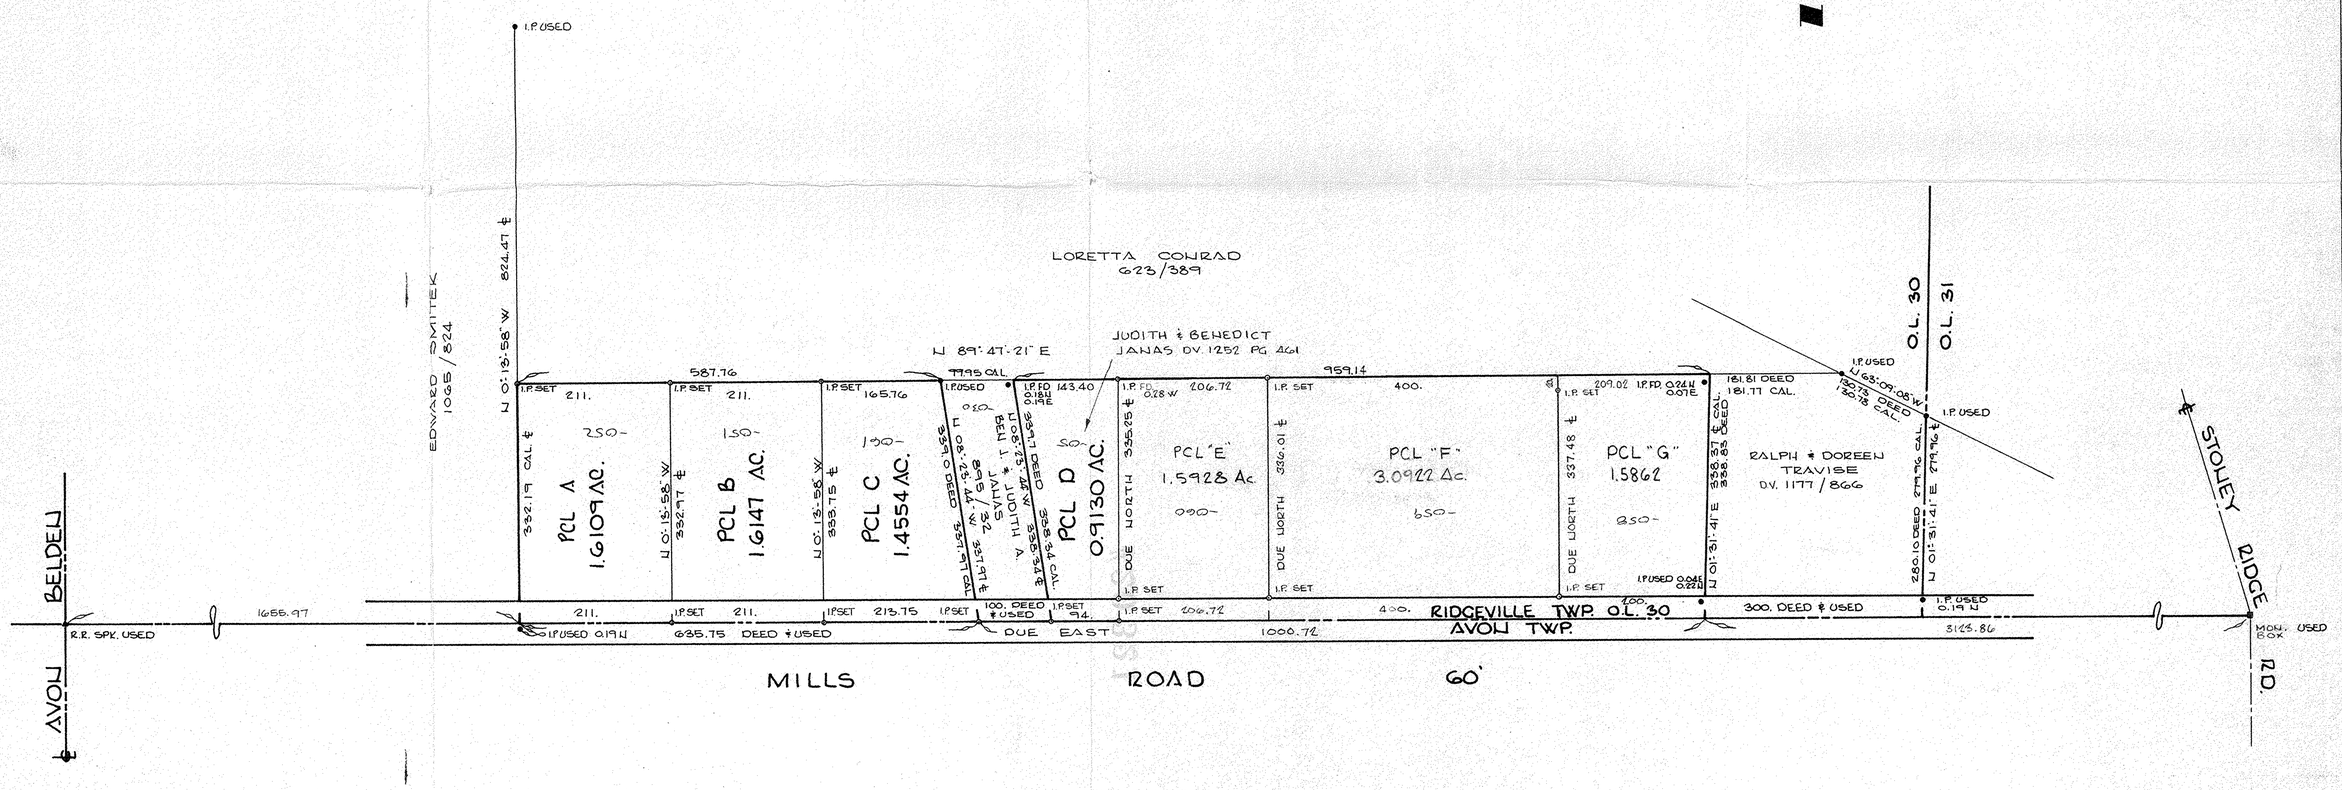

#20321

APPROVED
LORAIN CO.
MAP DEPT.
DATE 4-12-93
PAGE 7-B
BY T. McClain & C.E. Francis
#20321

REVISED NOV. 92

#79-49