07-00-035-101-059, 061 Split # 17904 pg 07-00-035-A

07-00-035-101

#17904

LAUNDON · SIMON · CAHL & ASSOC. INC.
CONSULTING ENGINEERS & SURVEYORS
219 COURT ST ELYRIA, OHIO 44035

Surveyor's Plat

WM. E. & LINDA L. KLOSTERMEYER
R.L. & M.L. SIGSWORTH

Orig. Lot 35	City of NORTH RIDGEVILLE	Date DEC. '87 Scale 1"=100'
Orig. Sec	Village of	Dwn. by R.G.S. Chkd. by C.J.
Tract	County of LORAIN	Job No. 87-1670 F.B.
Township of RIDGEVILLE	State of OHIO	Printed

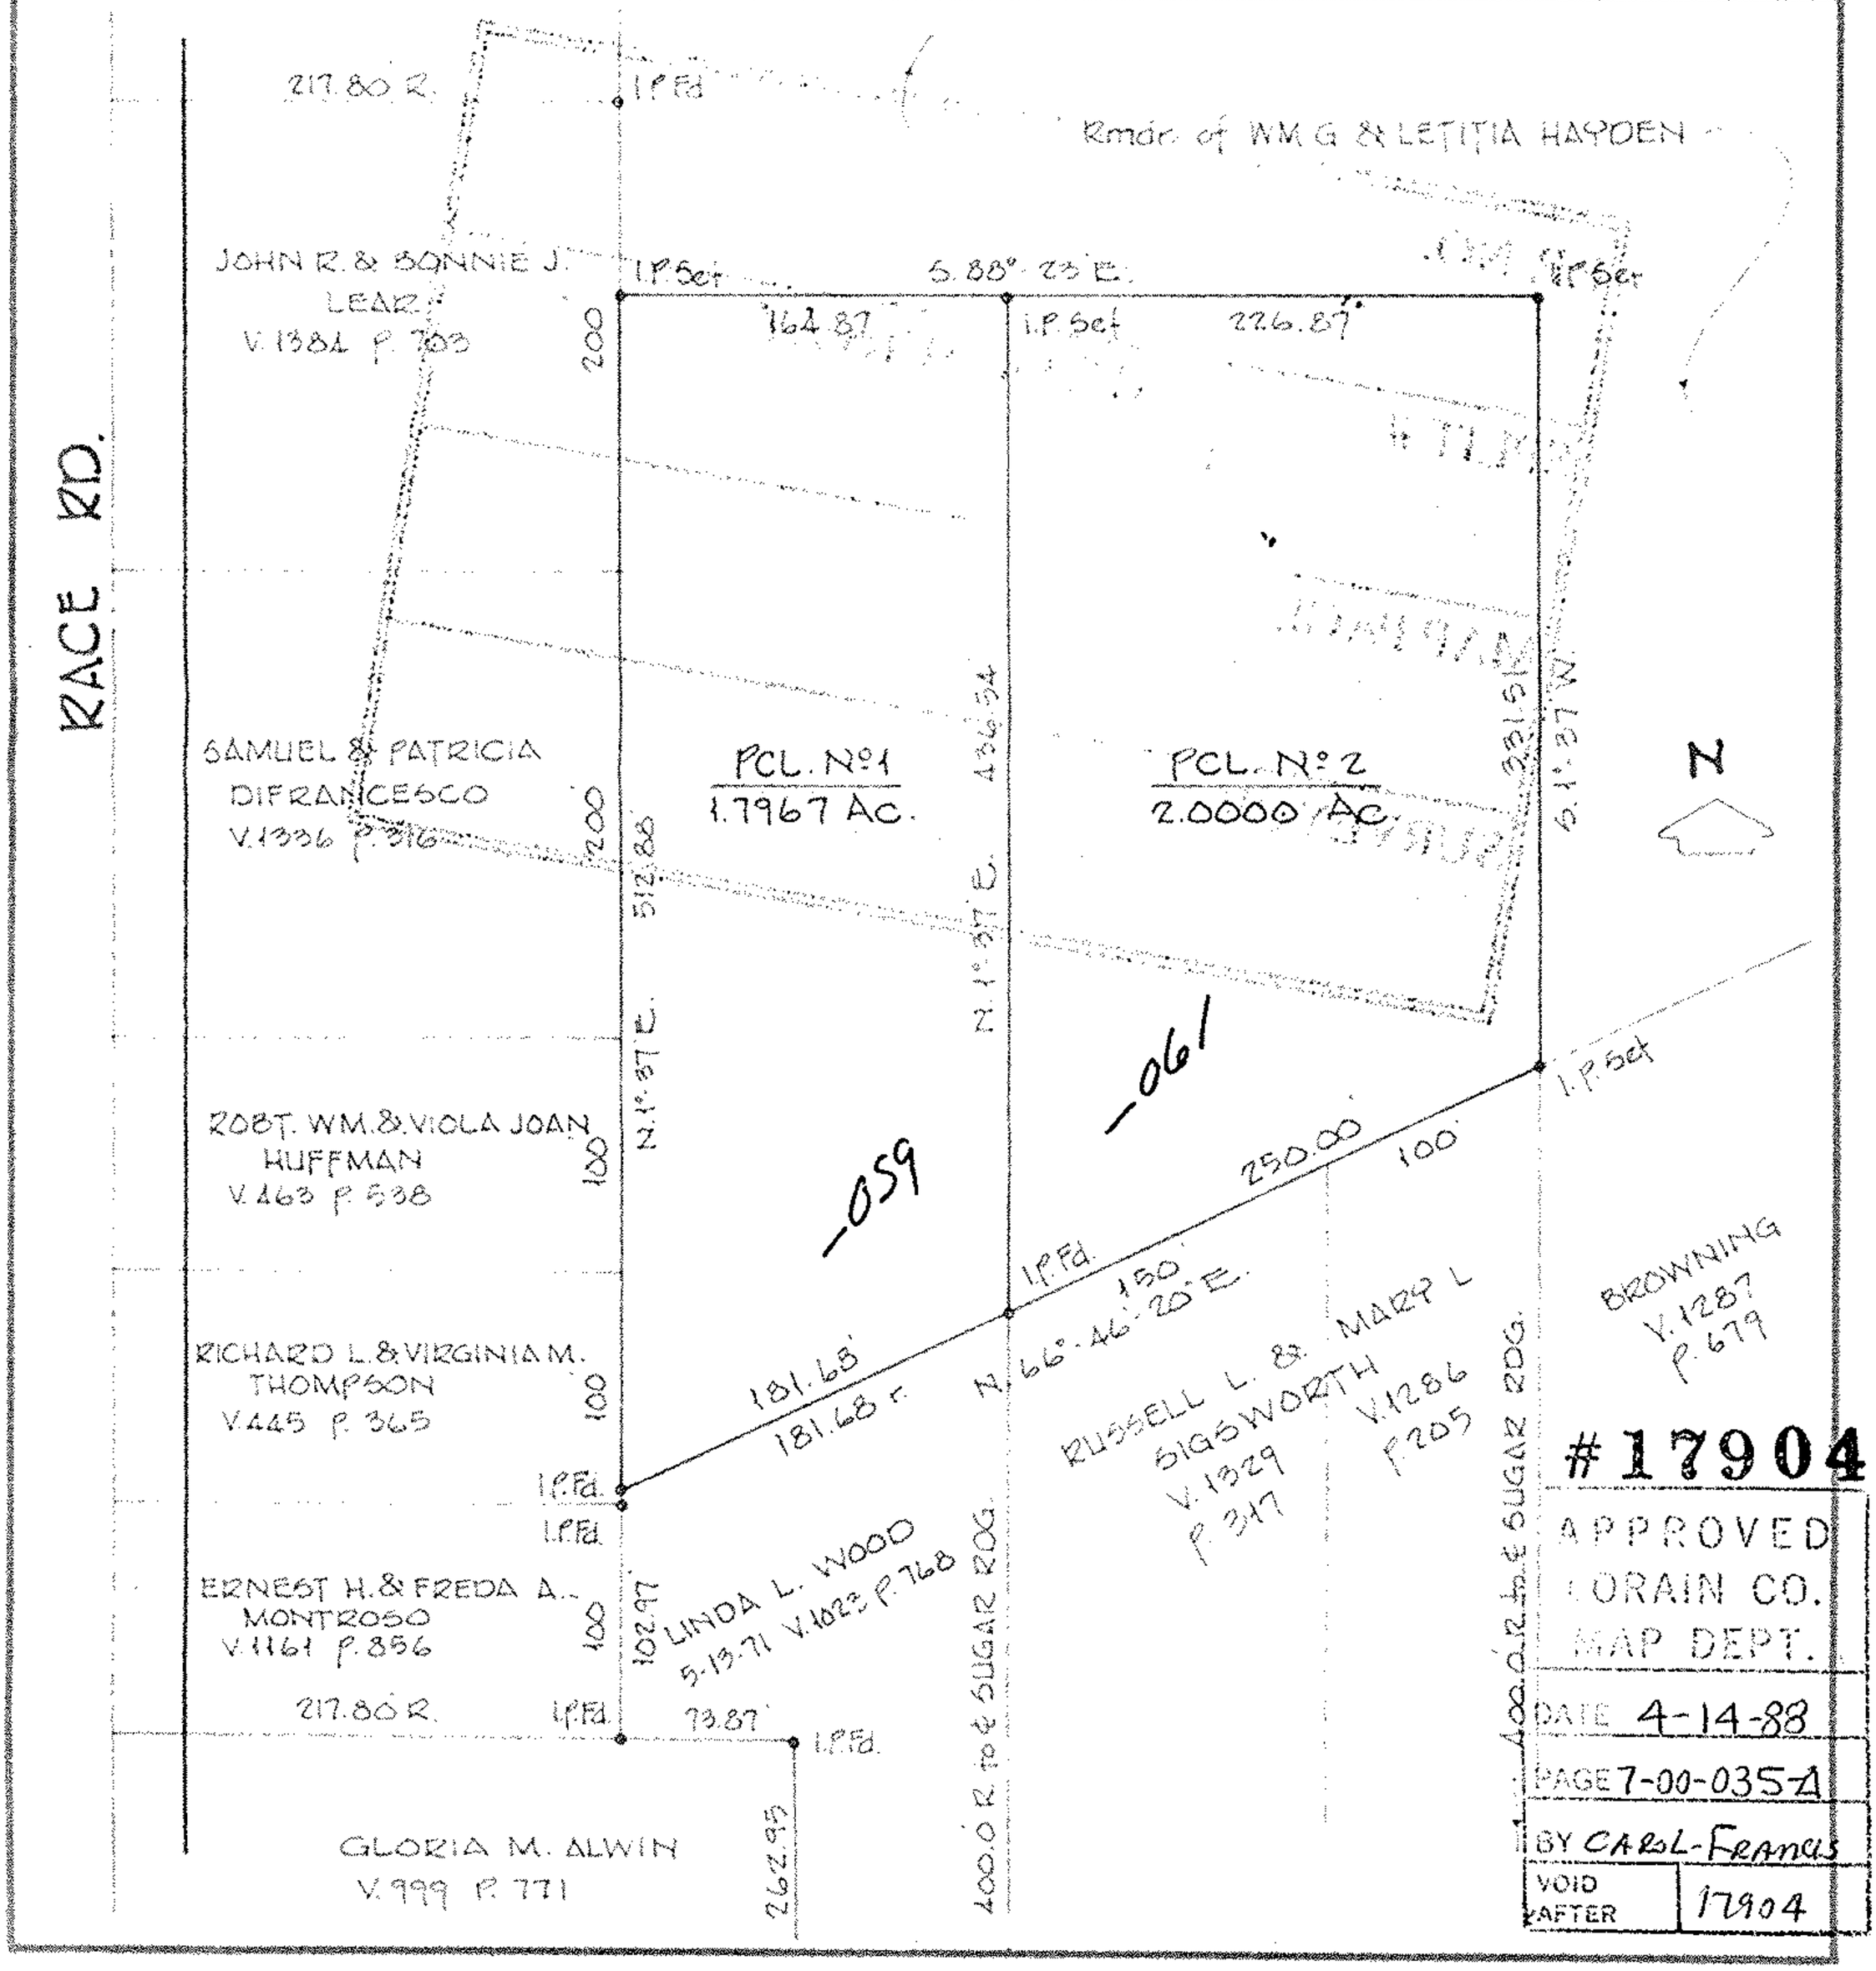

#17904
APPROVED
LORAIN CO.
MAP DEPT.
DATE 4-14-88
PAGE 7-00-035-A
BY CARL-Fernas
VOID AFTER 17904

7-00-035-A