



LAUNDON . SIMON . CAHL & ASSOC. INC.
CONSULTING ENGINEERS & SURVEYORS
219 COURT ST. ELYRIA, OHIO 44035


SURVEY FOR:

DARYL STAINBROOK

Orig. Lot 37	City of NORTH RIDGEVILLE	Date JULY 24, 1987 Scale 1"=200'
Orig. Sec	Village of	Dwn. by R.G.S. Chkd. by D.H.
Tract	County of LORAIN	Job No. 87-1631 F.B.
Township of RIDGEVILLE	State of OHIO	Printed JUL 28 1987

07-00-037-000

#17608

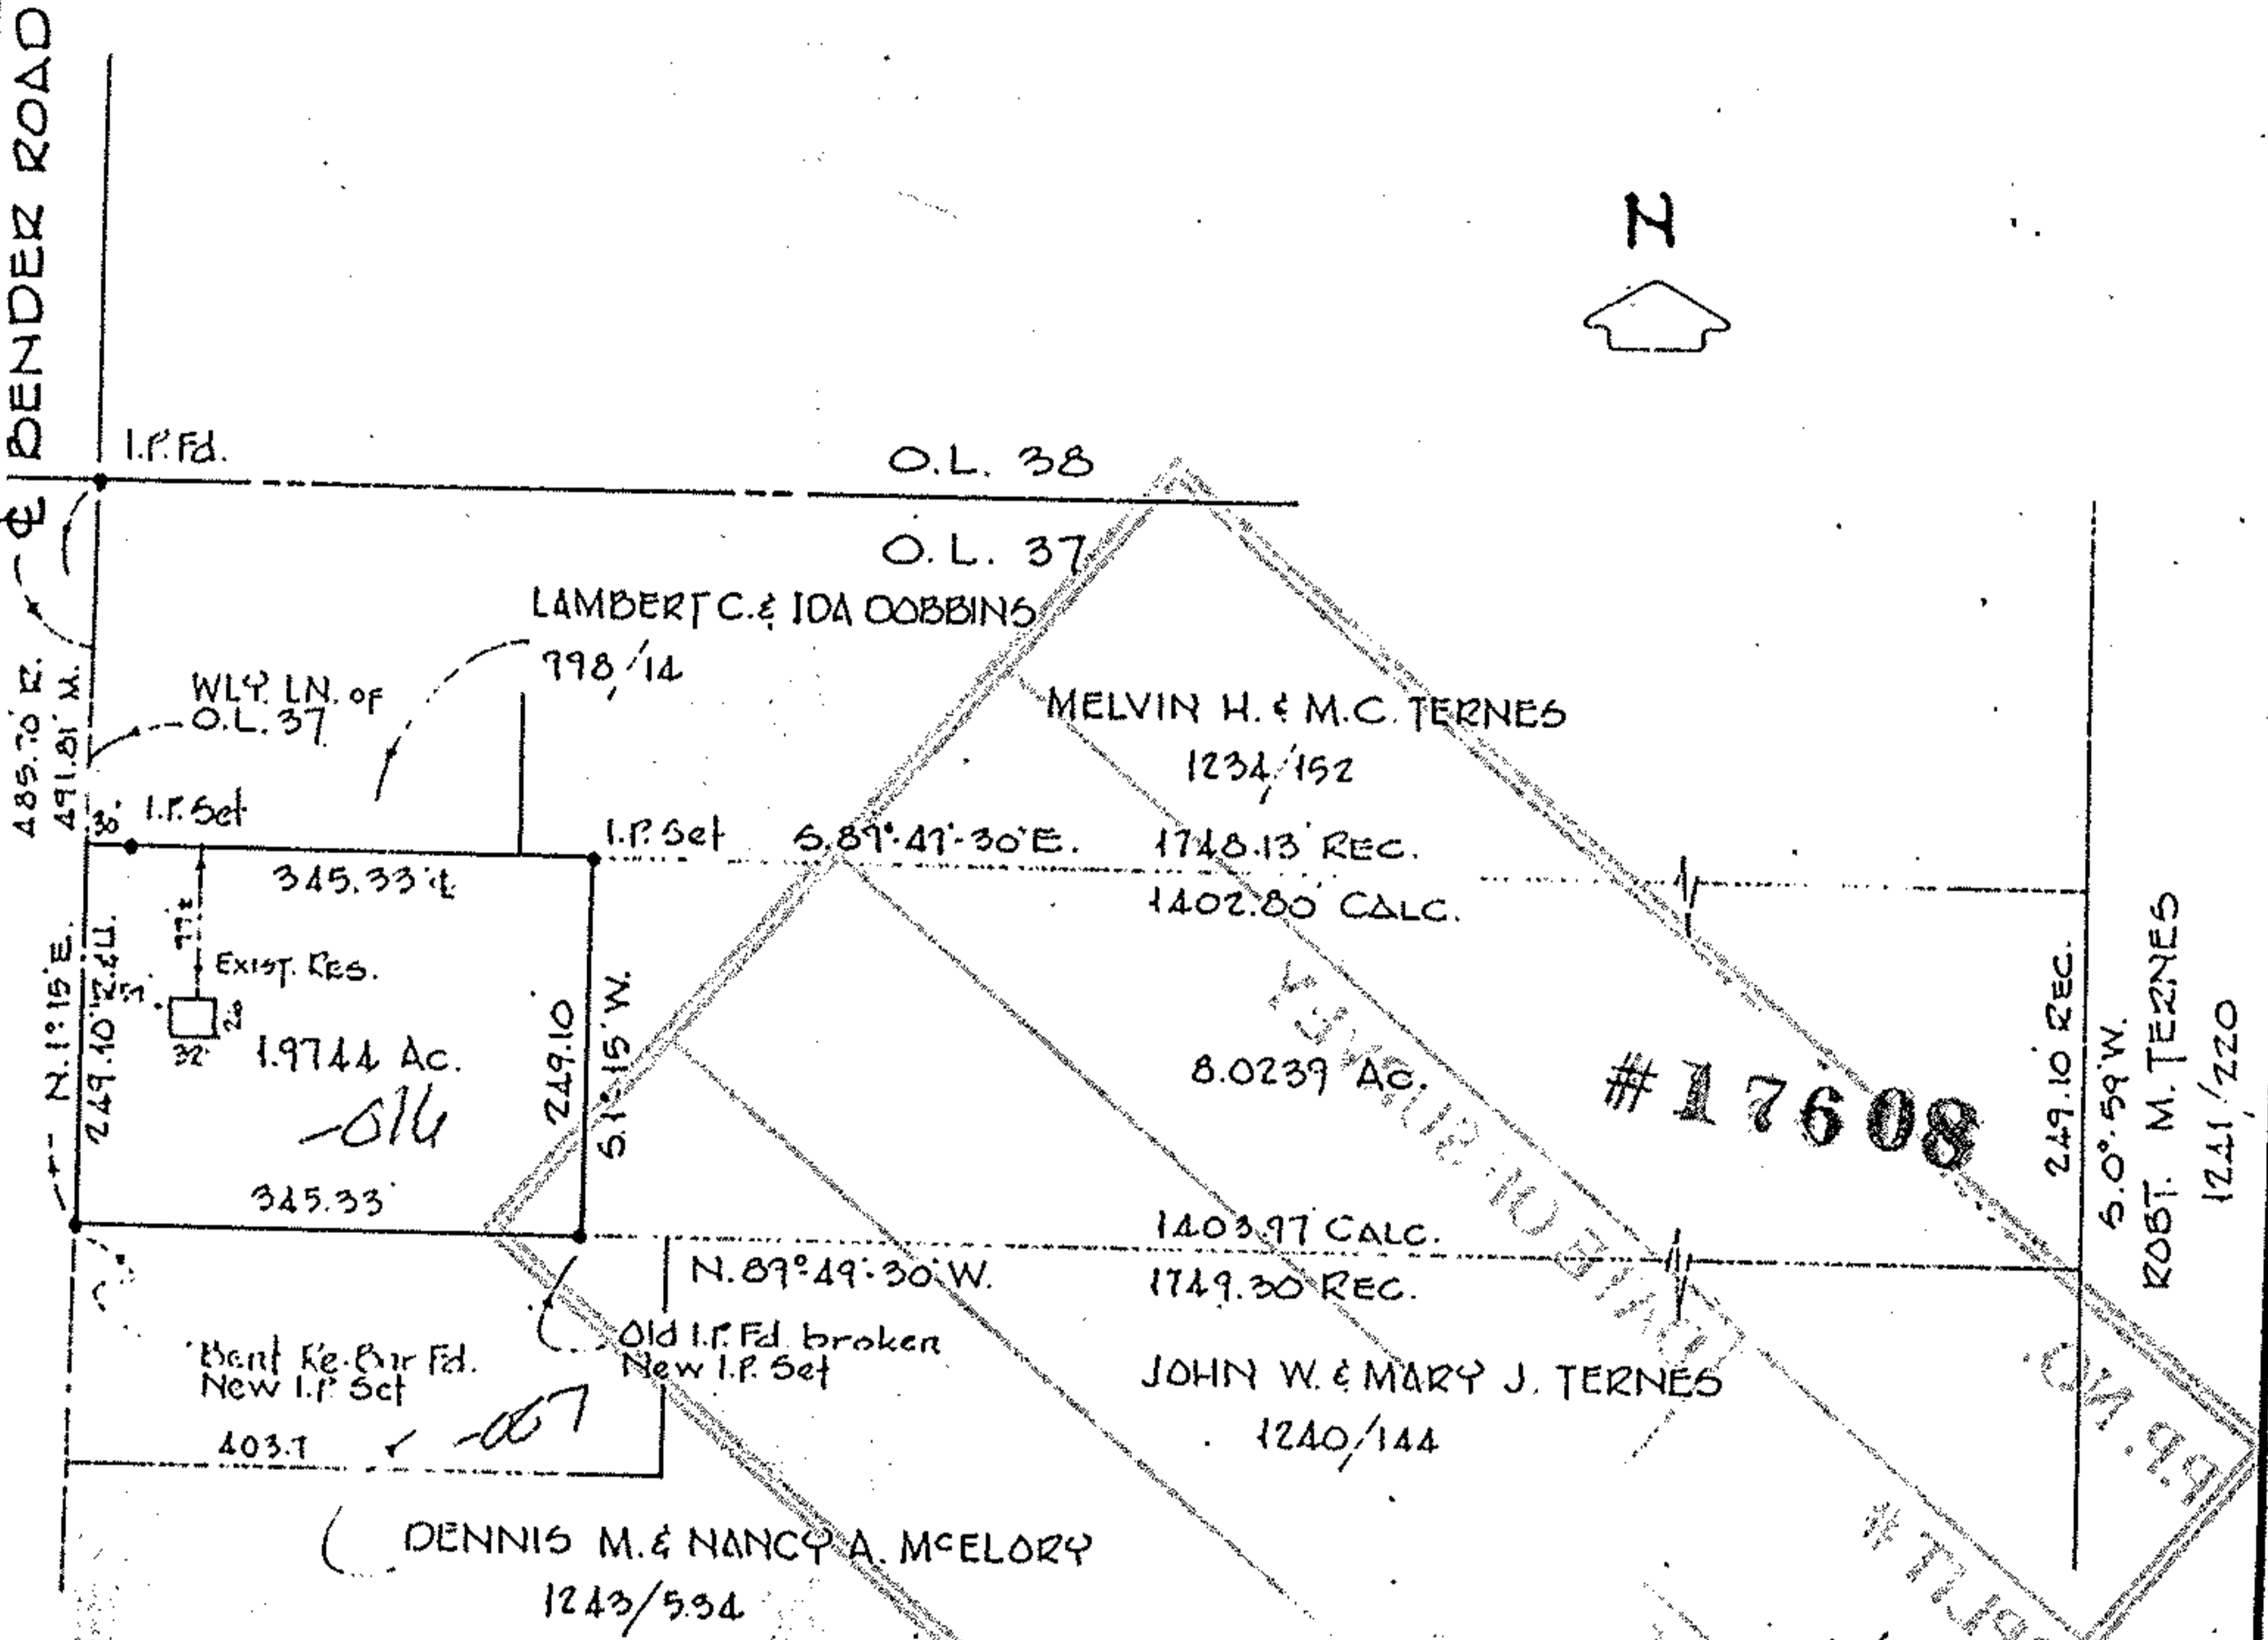

DP# 07-00-037-000-016, 007

#17608

APPROVED LORAIN CO. MAP DEPT.	
DATE 8-18-87	
PAGE 7-E	
BY C. FRANKIS	
VOID AFTER	17608

7-E