7408

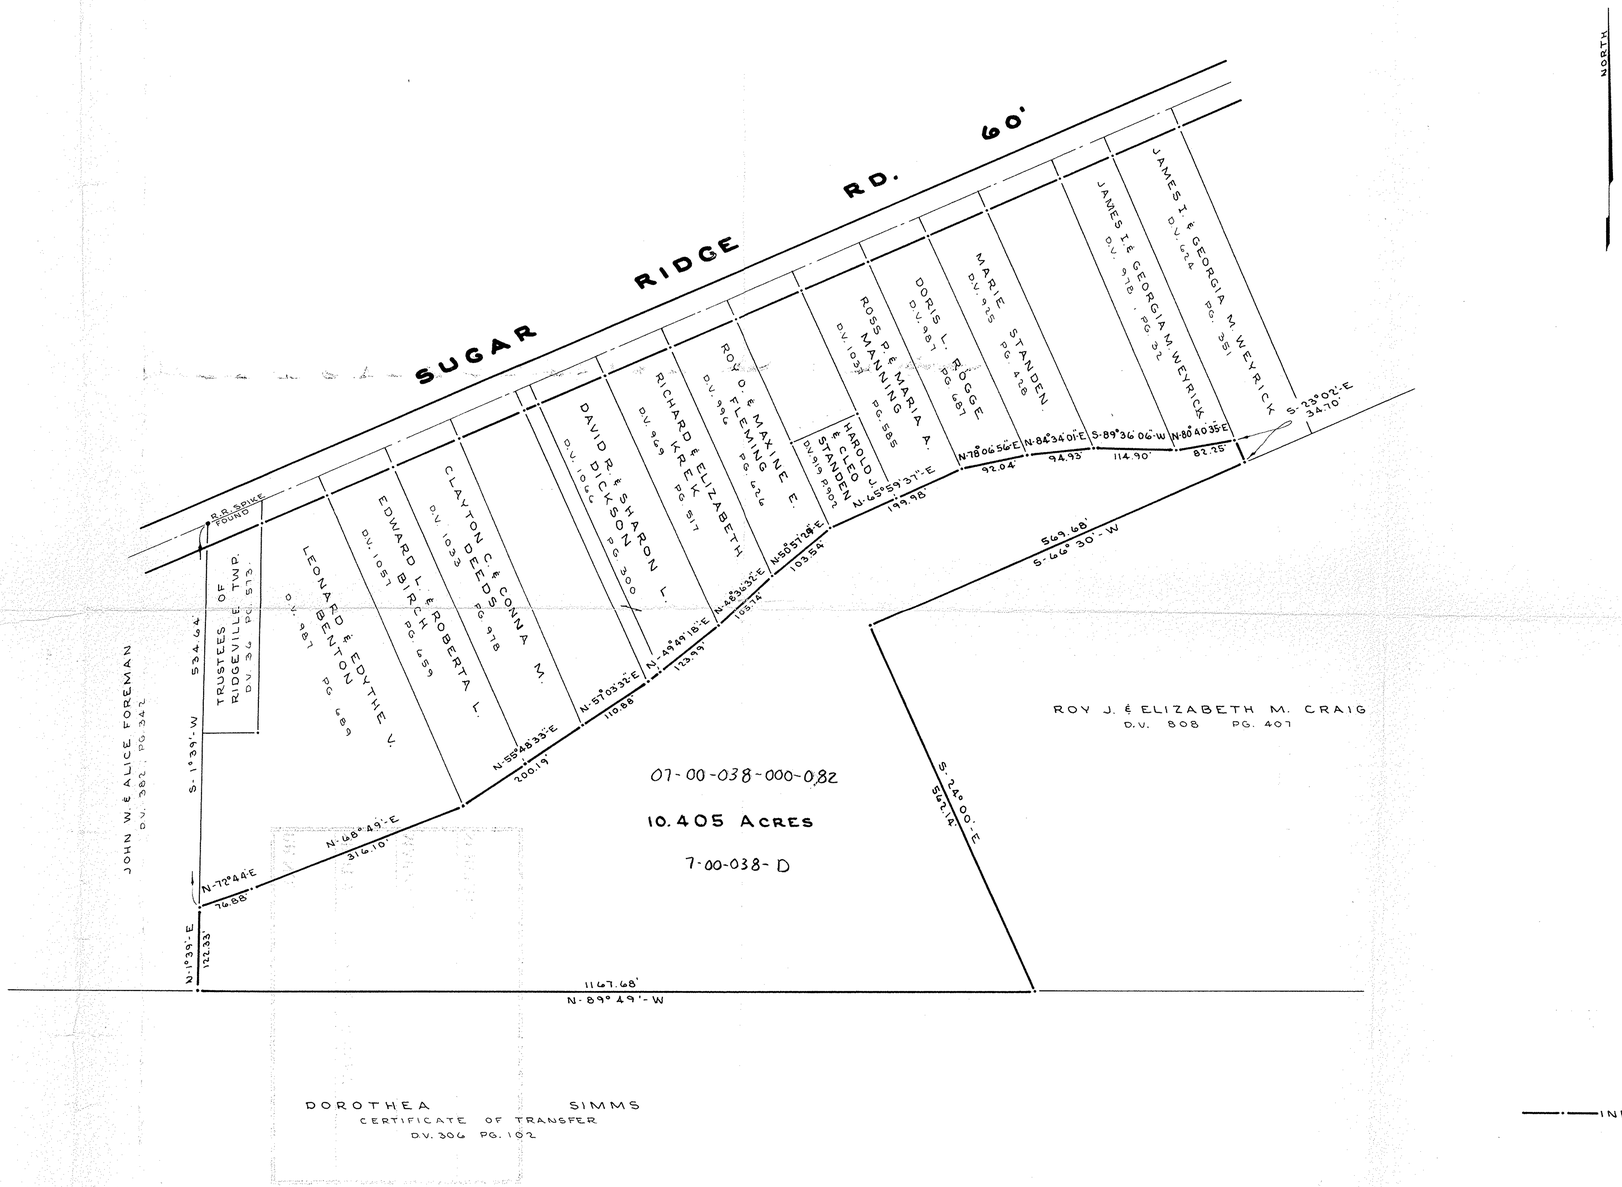

P.P. NO. 07-00-038-000-082	
SPLIT # 7408	DATE OF SURVEY
MAP PAGE 07-00-038-D	
SURVEYOR KSA	

No.	Date	Description	By

REVISIONS

PROJECT

SURVEY
OF PART OF
ORIGINAL RIDGEVILLE TWP. LOT 38
CITY OF N. RIDGEVILLE, CO. OF LORAIN
STATE OF OHIO

PREPARED FOR:

HARRY M. STANDEN

Drawn by: D. SCHROEDER
Checked by:
App. by:
Scale: 1" = 100'
Date: AUGUST, 1973

SCHMIDT and Associates
Elyria, Ohio
Norwalk, Ohio
SURVEYORS and CONSULTANTS in LAND PLANNING

REFERENCES

SHEET NO. 1 of 1

JOB NO. 73-201