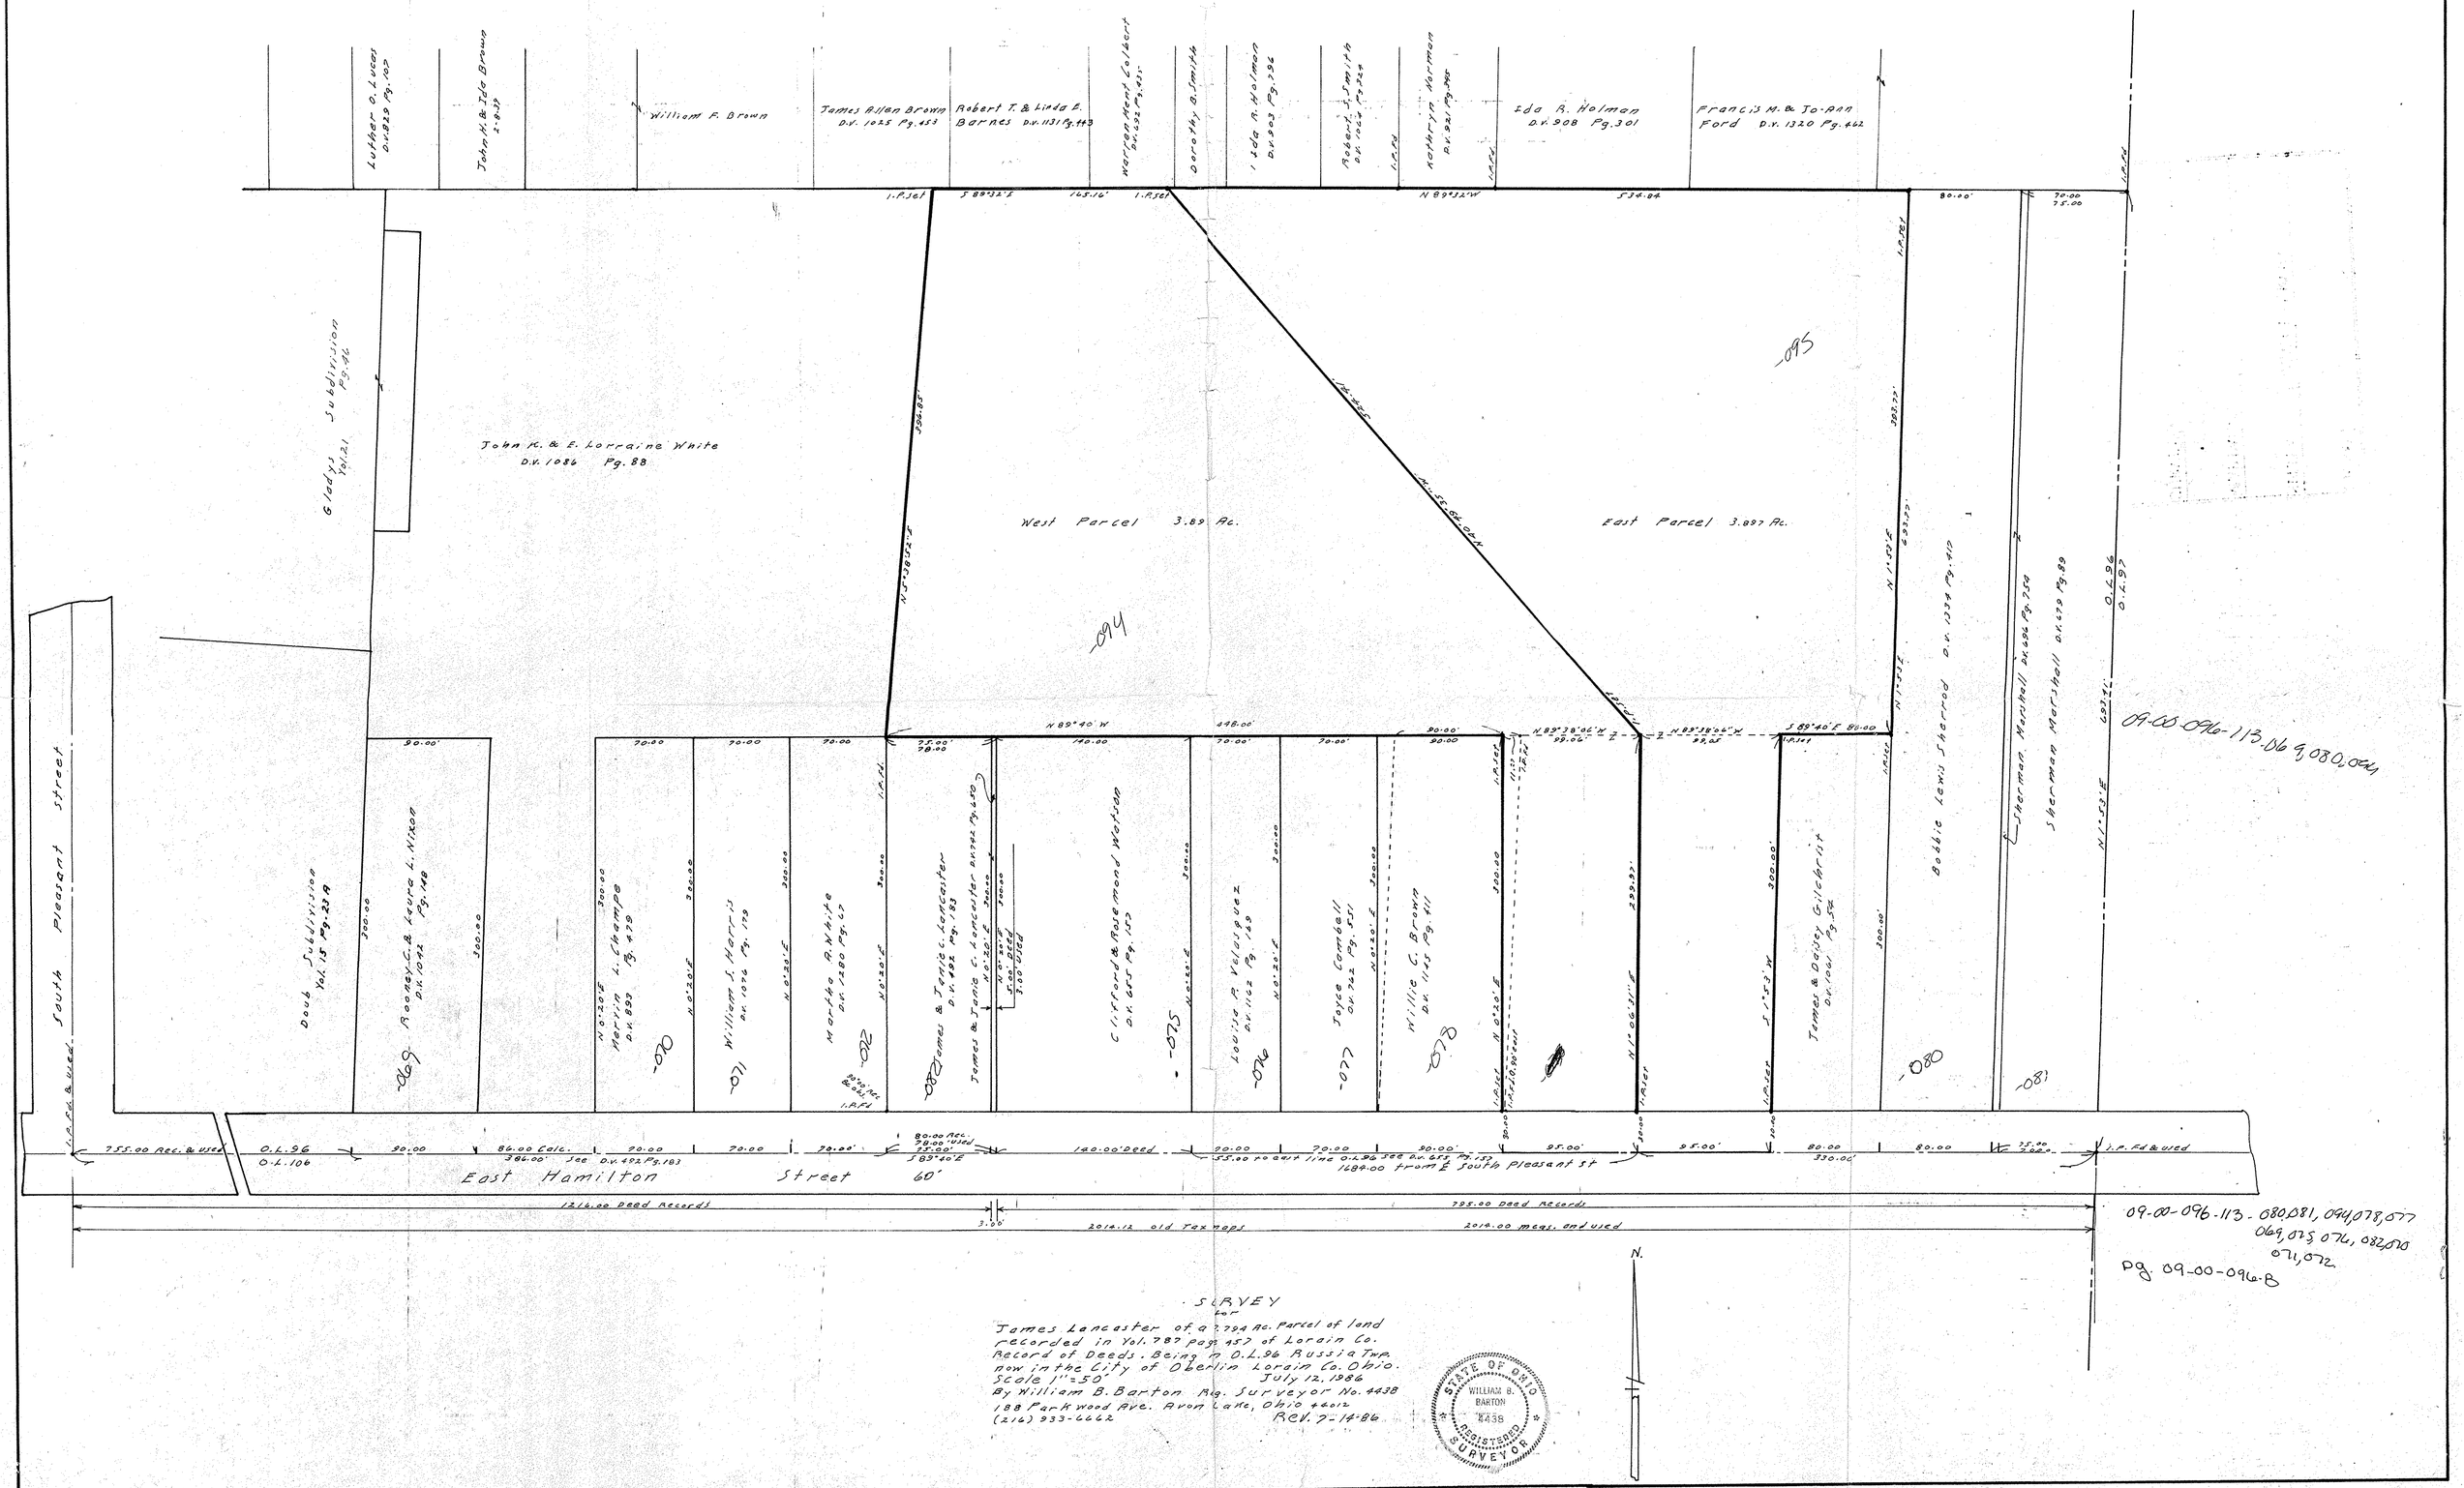
Luther D. Lucas D.V. 829 Pg. 102
John H. & Ida Brown
William F. Brown
James Allan Brown D.V. 1035 Pg. 453
Robert T. & Linda E. Barnes D.V. 1131 Pg. 443
Dorothy B. Smith
Ida R. Holman D.V. 903 Pg. 296
Robert J. Smith
Kathryn Harmon
Ida R. Holman D.V. 908 Pg. 301
Francis H. & Jo-Ann Ford D.V. 1320 Pg. 462
Gladys Subdivision Pg. 96
Vol. 21
John R. & E. Lorraine White D.V. 1086 Pg. 88
West Parcel 3.89 Ac.
East Parcel 3.897 Ac.
094
095
S 89°32'E 165.16'
N 89°32'W 534.84
N 89°40'W 498.00'
S 89°40'E 80.00'
N 1°53'E 633.72'
S 1°53'W 633.72'
N 1°53'E
South Pleasant Street
Doub Subdivision Vol. 15 Pg. 239
Rodney C. & Laura L. Nixon D.V. 1042 Pg. 148
Marvin L. Champe D.V. 893 Pg. 429
William S. Harris D.V. 1076 Pg. 179
Martha A. White D.V. 1280 Pg. 63
James & Janice C. Lancaster D.V. 492 Pg. 183
Clifford & Rosemond Watson D.V. 655 Pg. 153
Louisa A. Velazquez D.V. 1162 Pg. 149
Joyce Cordell D.V. 721 Pg. 551
Willie C. Brown D.V. 1145 Pg. 411
James & Daisy Gilchrist D.V. 1061 Pg. 556
Bobbie Lewis Sherrod D.V. 1334 Pg. 410
Sherman Marshall D.V. 686 Pg. 754
Sherman Marshall D.V. 679 Pg. 89
O.L. 96
O.L. 97
09-00-096-113-06 9,080,081
755.00 Rec. & used
O.L. 96
O.L. 106
86.00 Calc.
386.00' See D.V. 492 Pg. 183
140.00' Deed
155.00 to Gate line O.L. 96 See D.V. 655 Pg. 153
1684.00 from E. South Pleasant St
East Hamilton Street 60'
1216.00 Deed Records
795.00 Deed Records
2014.12 old Tax map
2014.00 meas. and used
09-00-096-113-080,081, 094,078,077 069,075 076, 082,080 071,072
Pg 09-00-096-B
N.
SURVEY
for
James Lancaster of a 3.794 Ac. Parcel of land recorded in Vol. 787 page 457 of Lorain Co. Record of Deeds. Being in O.L. 96 Russia Twp. now in the City of Oberlin Lorain Co. Ohio.
Scale 1"=50'
July 12, 1986
By William B. Barton Reg. Surveyor No. 4438
188 Parkwood Ave. Avon Lake, Ohio 44012
(216) 933-6662
REV. 7-14-86
STATE OF OHIO
WILLIAM B. BARTON
4438
REGISTERED
SURVEYOR