15-00-042-000-007, 008

P.P. NO. 19-06-043-003, 005, 006
041-000-009
15-00-091-000-042-003 & 005
004, 006, 007, 018

SPLIT #	DATE OF SURVEY
MAP PAGE	
SURVEYOR	

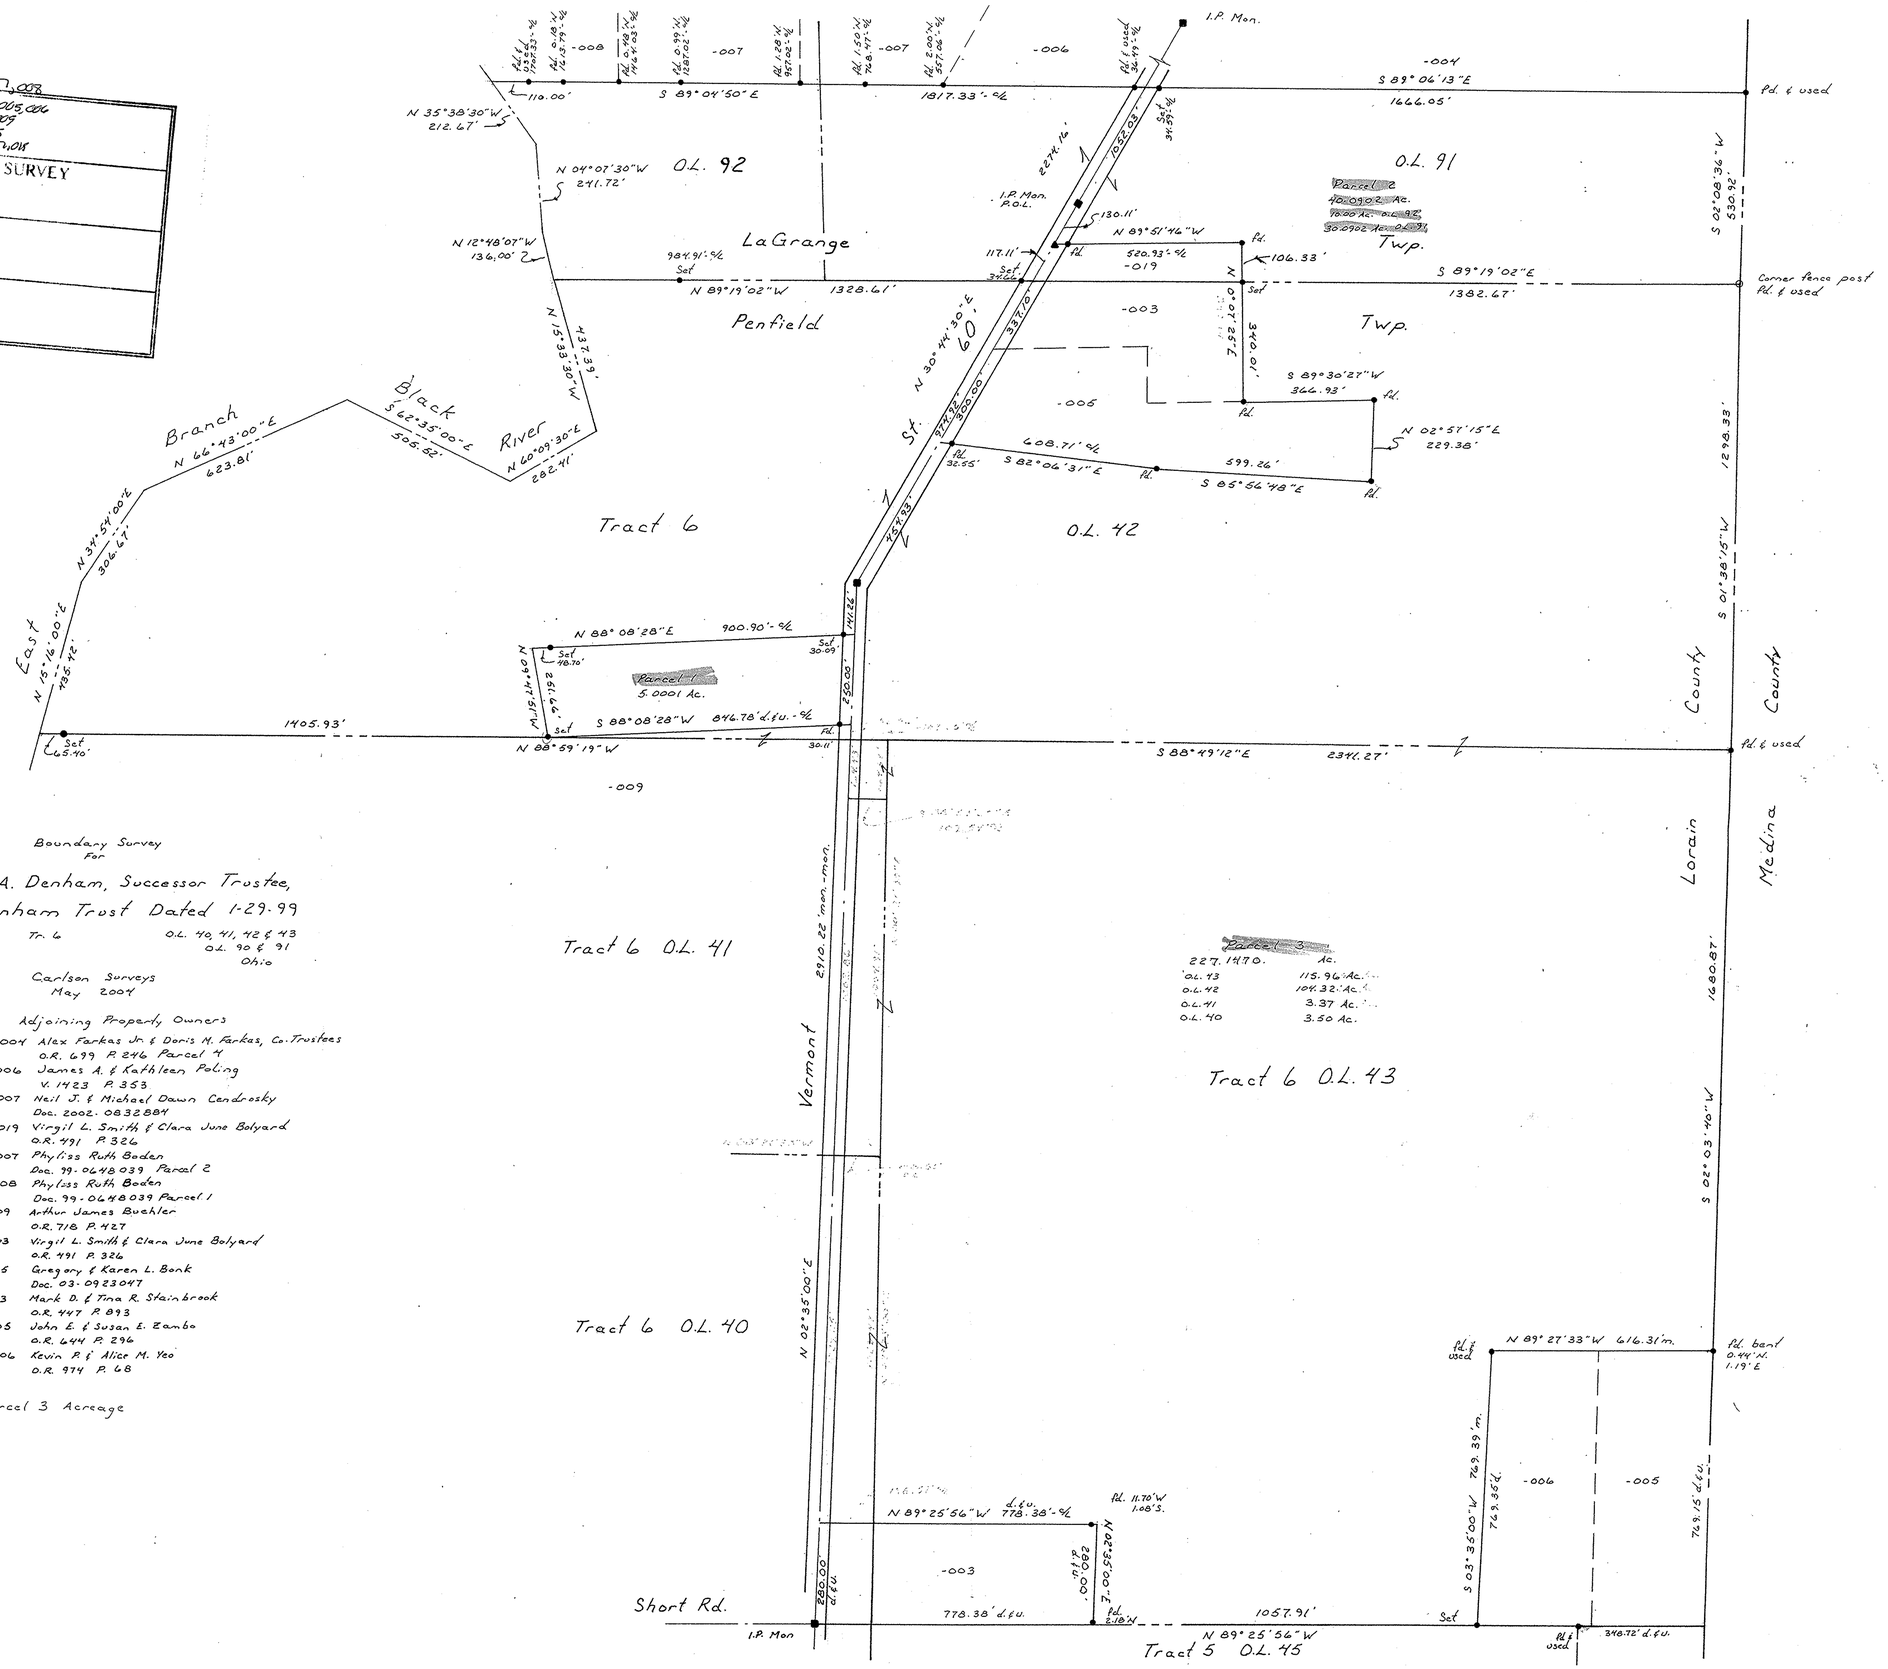

Boundary Survey
For

Raymond A. Denham, Successor Trustee,
Myrle T. Denham Trust Dated 1-29-99

Penfield Twp. Tr. 6 O.L. 40, 41, 42 & 43
LaGrange Twp. O.L. 90 & 91
Lorain Co. Ohio

Carlson Surveys
May 2004

Adjoining Property Owners

15-00-091-000-004	Alex Farkas Jr. & Doris M. Farkas, Co-Trustees O.R. 699 P. 246 Parcel 4
15-00-091-000-006	James A. & Kathleen Poling V. 1423 P. 353
15-00-091-000-007	Neil J. & Michael Dawn Cendrosky Doc. 2002-0832884
15-00-091-000-019	Virgil L. Smith & Clara June Bolyard O.R. 491 P. 326
15-00-092-000-007	Phyliss Ruth Boden Doc. 99-0648039 Parcel 2
15-00-092-000-008	Phyliss Ruth Boden Doc. 99-0648039 Parcel 1
19-06-041-000-009	Arthur James Buehler O.R. 718 P. 427
19-06-042-000-003	Virgil L. Smith & Clara June Bolyard O.R. 491 P. 326
19-06-042-000-005	Gregory & Karen L. Bank Doc. 03-0923047
19-06-043-000-003	Mark D. & Tina R. Stainbrook O.R. 447 P. 893
19-06-043-000-005	John E. & Susan E. Zambo O.R. 644 P. 296
19-06-043-000-006	Kevin R. & Alice M. Yeo O.R. 974 P. 68

Rev. 9-1-04 Parcel 3 Acreage

N

Assumed
0 100 200 400
Scale: 1" = 200'

STATE OF OHIO REGISTERED CARL A. CARLSON 7450 PROFESSIONAL SURVEYOR

9-3-04