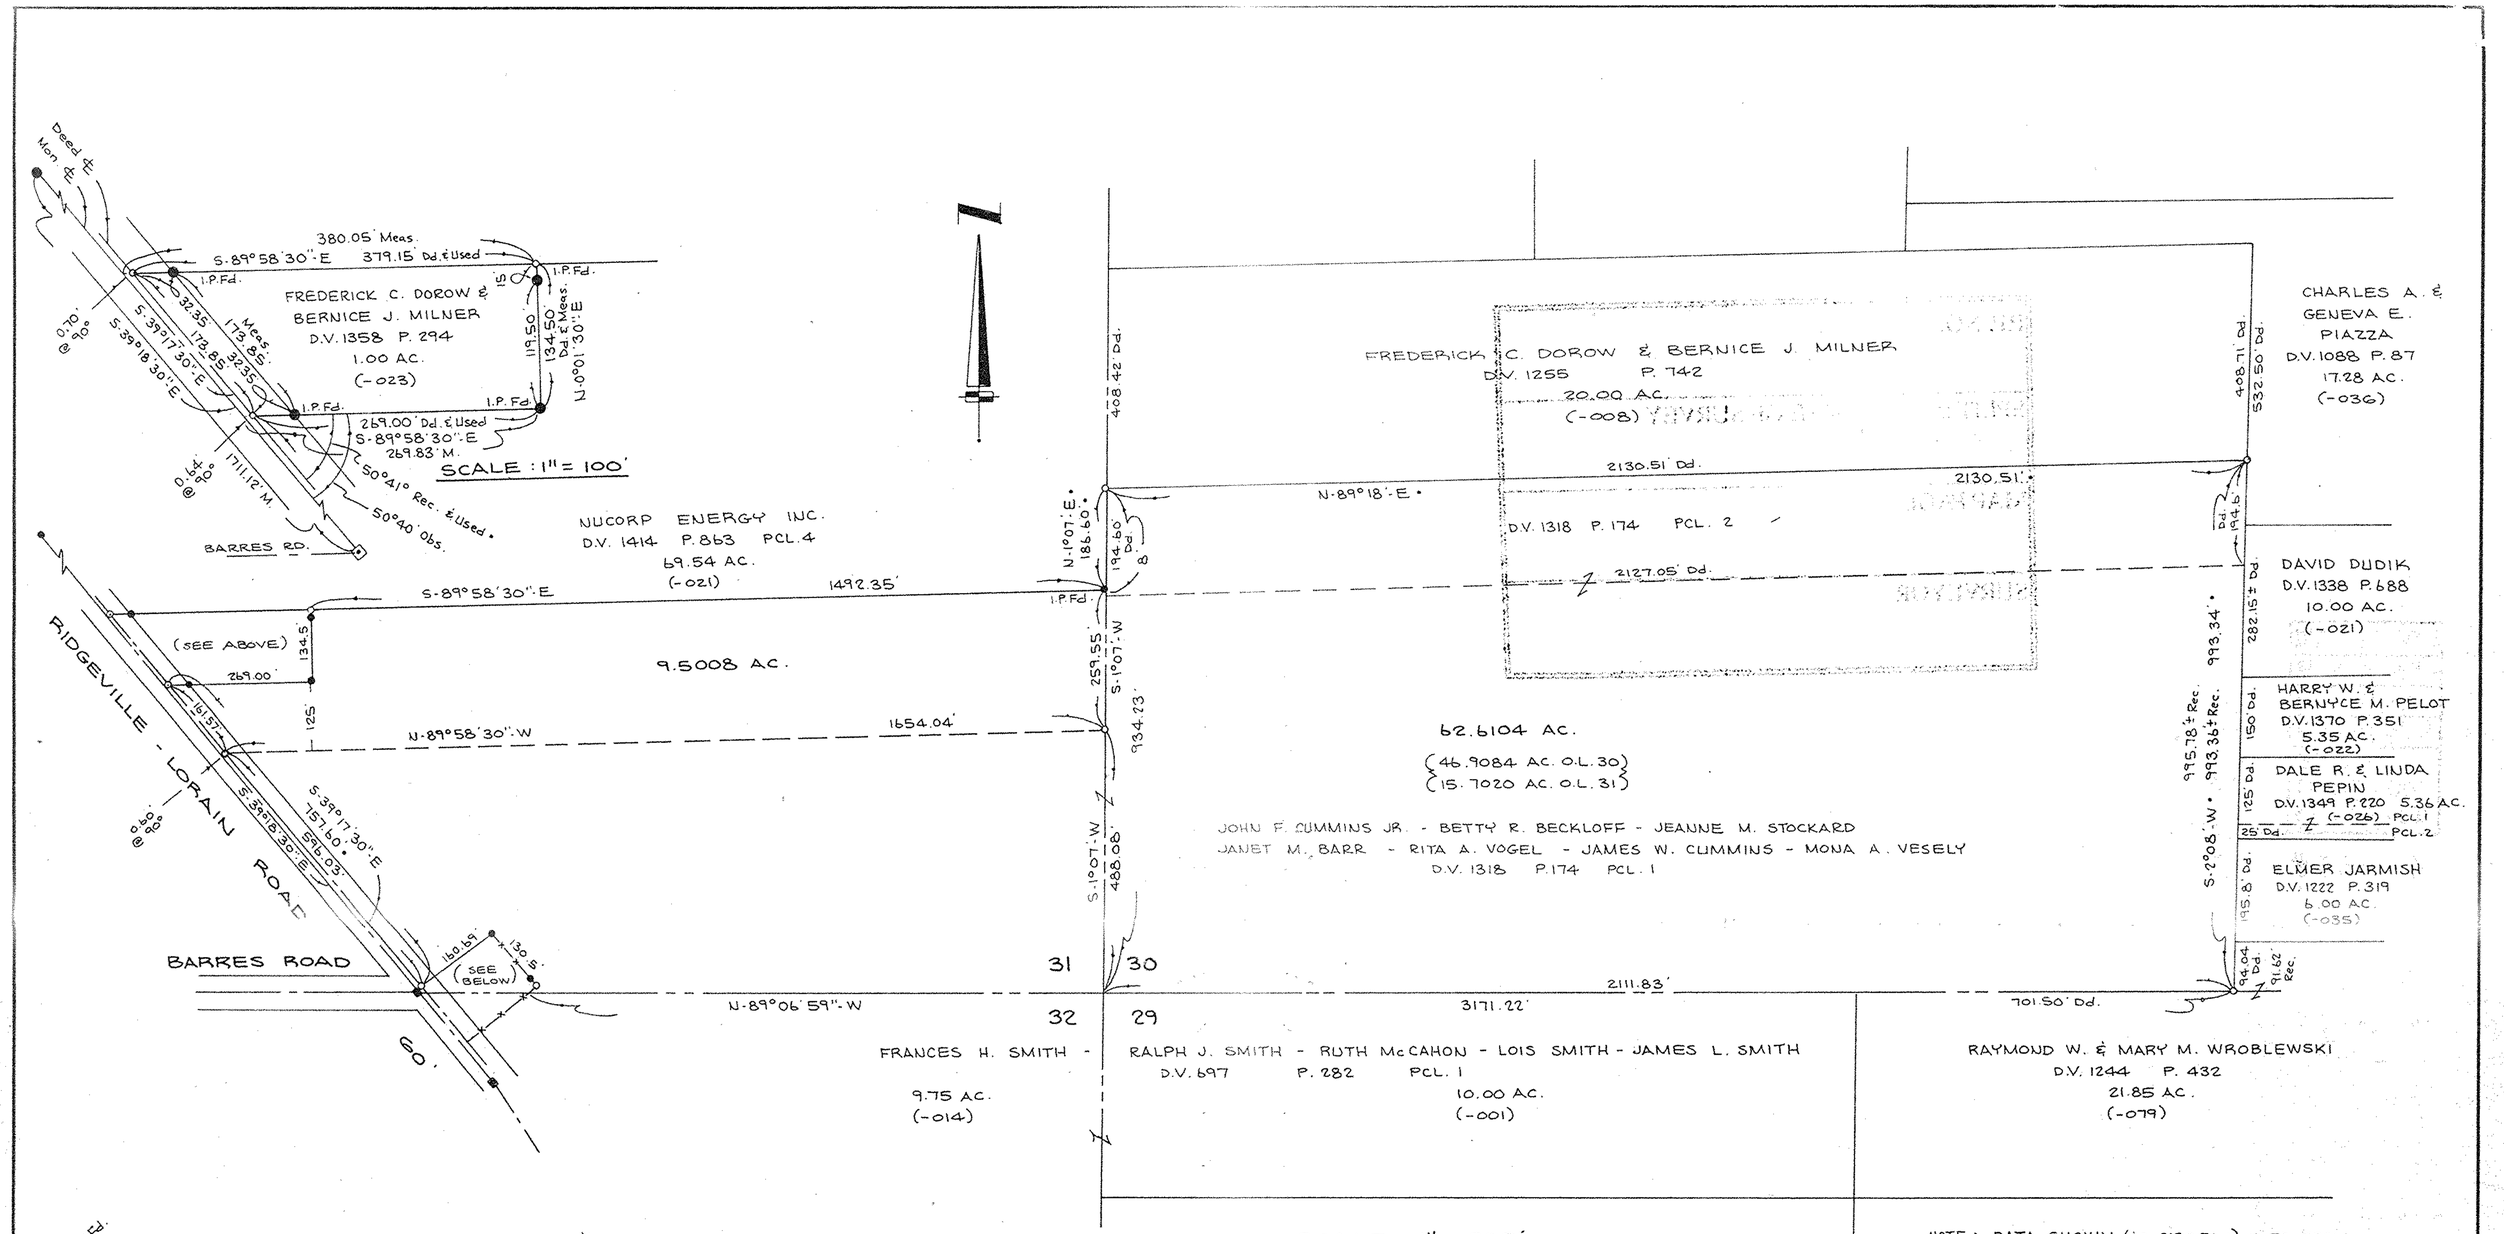

NOTE: DATA SHOWN (i.e. 2130.51 •) USED FROM SURVEYS BY J.W. WARDEN DATED FEB. 1, 1929 & WARDEN & LAUNDON DATED FEB. 27, 1942 RIDGEVILLE LORAIN RD. FRONTAGE PARCELS & 9.5008 AC. PCL. FROM SURVEYS BY KLEINOEDER-SCHMIDT & ASSOC. IN AUGUST 1986 & KS ASSOC. FEB. 18, 1988.

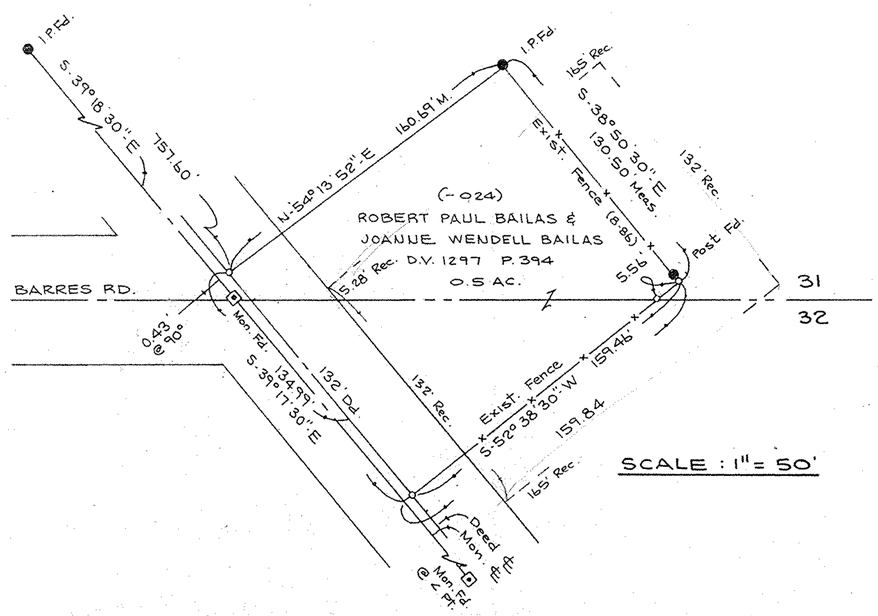

P.P. NO.	029-000-001 07-00-030-000-008 31-000-023
SPLIT #	DATE OF SURVEY
17889	
MAP PAGE	
07-B	
SURVEYOR	David L. Elwell

BOUNDARY SURVEY

PART OF RIDGEVILLE TOWNSHIP ORIGINAL LOTS 30 & 31

CITY OF NORTH RIDGEVILLE COUNTY OF LORAIN

STATE OF OHIO

PREPARED BY

KS ASSOCIATES

ENGINEERS SURVEYORS

David L. Elwell

REG. SURVEYOR NO. 6333

FEB. 18, 1988

Rev. 4-13-88 (Bailas Pcl. Rec. IBs)

#17889

APPROVED LORAIN CO. MAP DEPT.

DATE 4.18.88

PAGE 7-B

BY T. Malair

VOID AFTER 17889

STATE OF OHIO DAVID L. ELWELL 6333 REGISTERED SURVEYOR

4/13

86-151