




LAUNDON . SIMON . CAHL & ASSOC. INC.
 CONSULTING ENGINEERS & SURVEYORS
 219 COURT ST. ELYRIA, OHIO 44035

SURVEY FOR:

DARYL STAINBROOK

Orig. Lot 37	City of NORTH RIDGEVILLE	Date JULY 24, 1987 Scale 1"=200'
Orig. Sec	Village of	Dwn. by R.G.S. Chkd. by D.H.
Tract	County of LORAIN	Job No. 87-1631 F.B.
Township of RIDGEVILLE	State of OHIO	Printed

DENDER ROAD

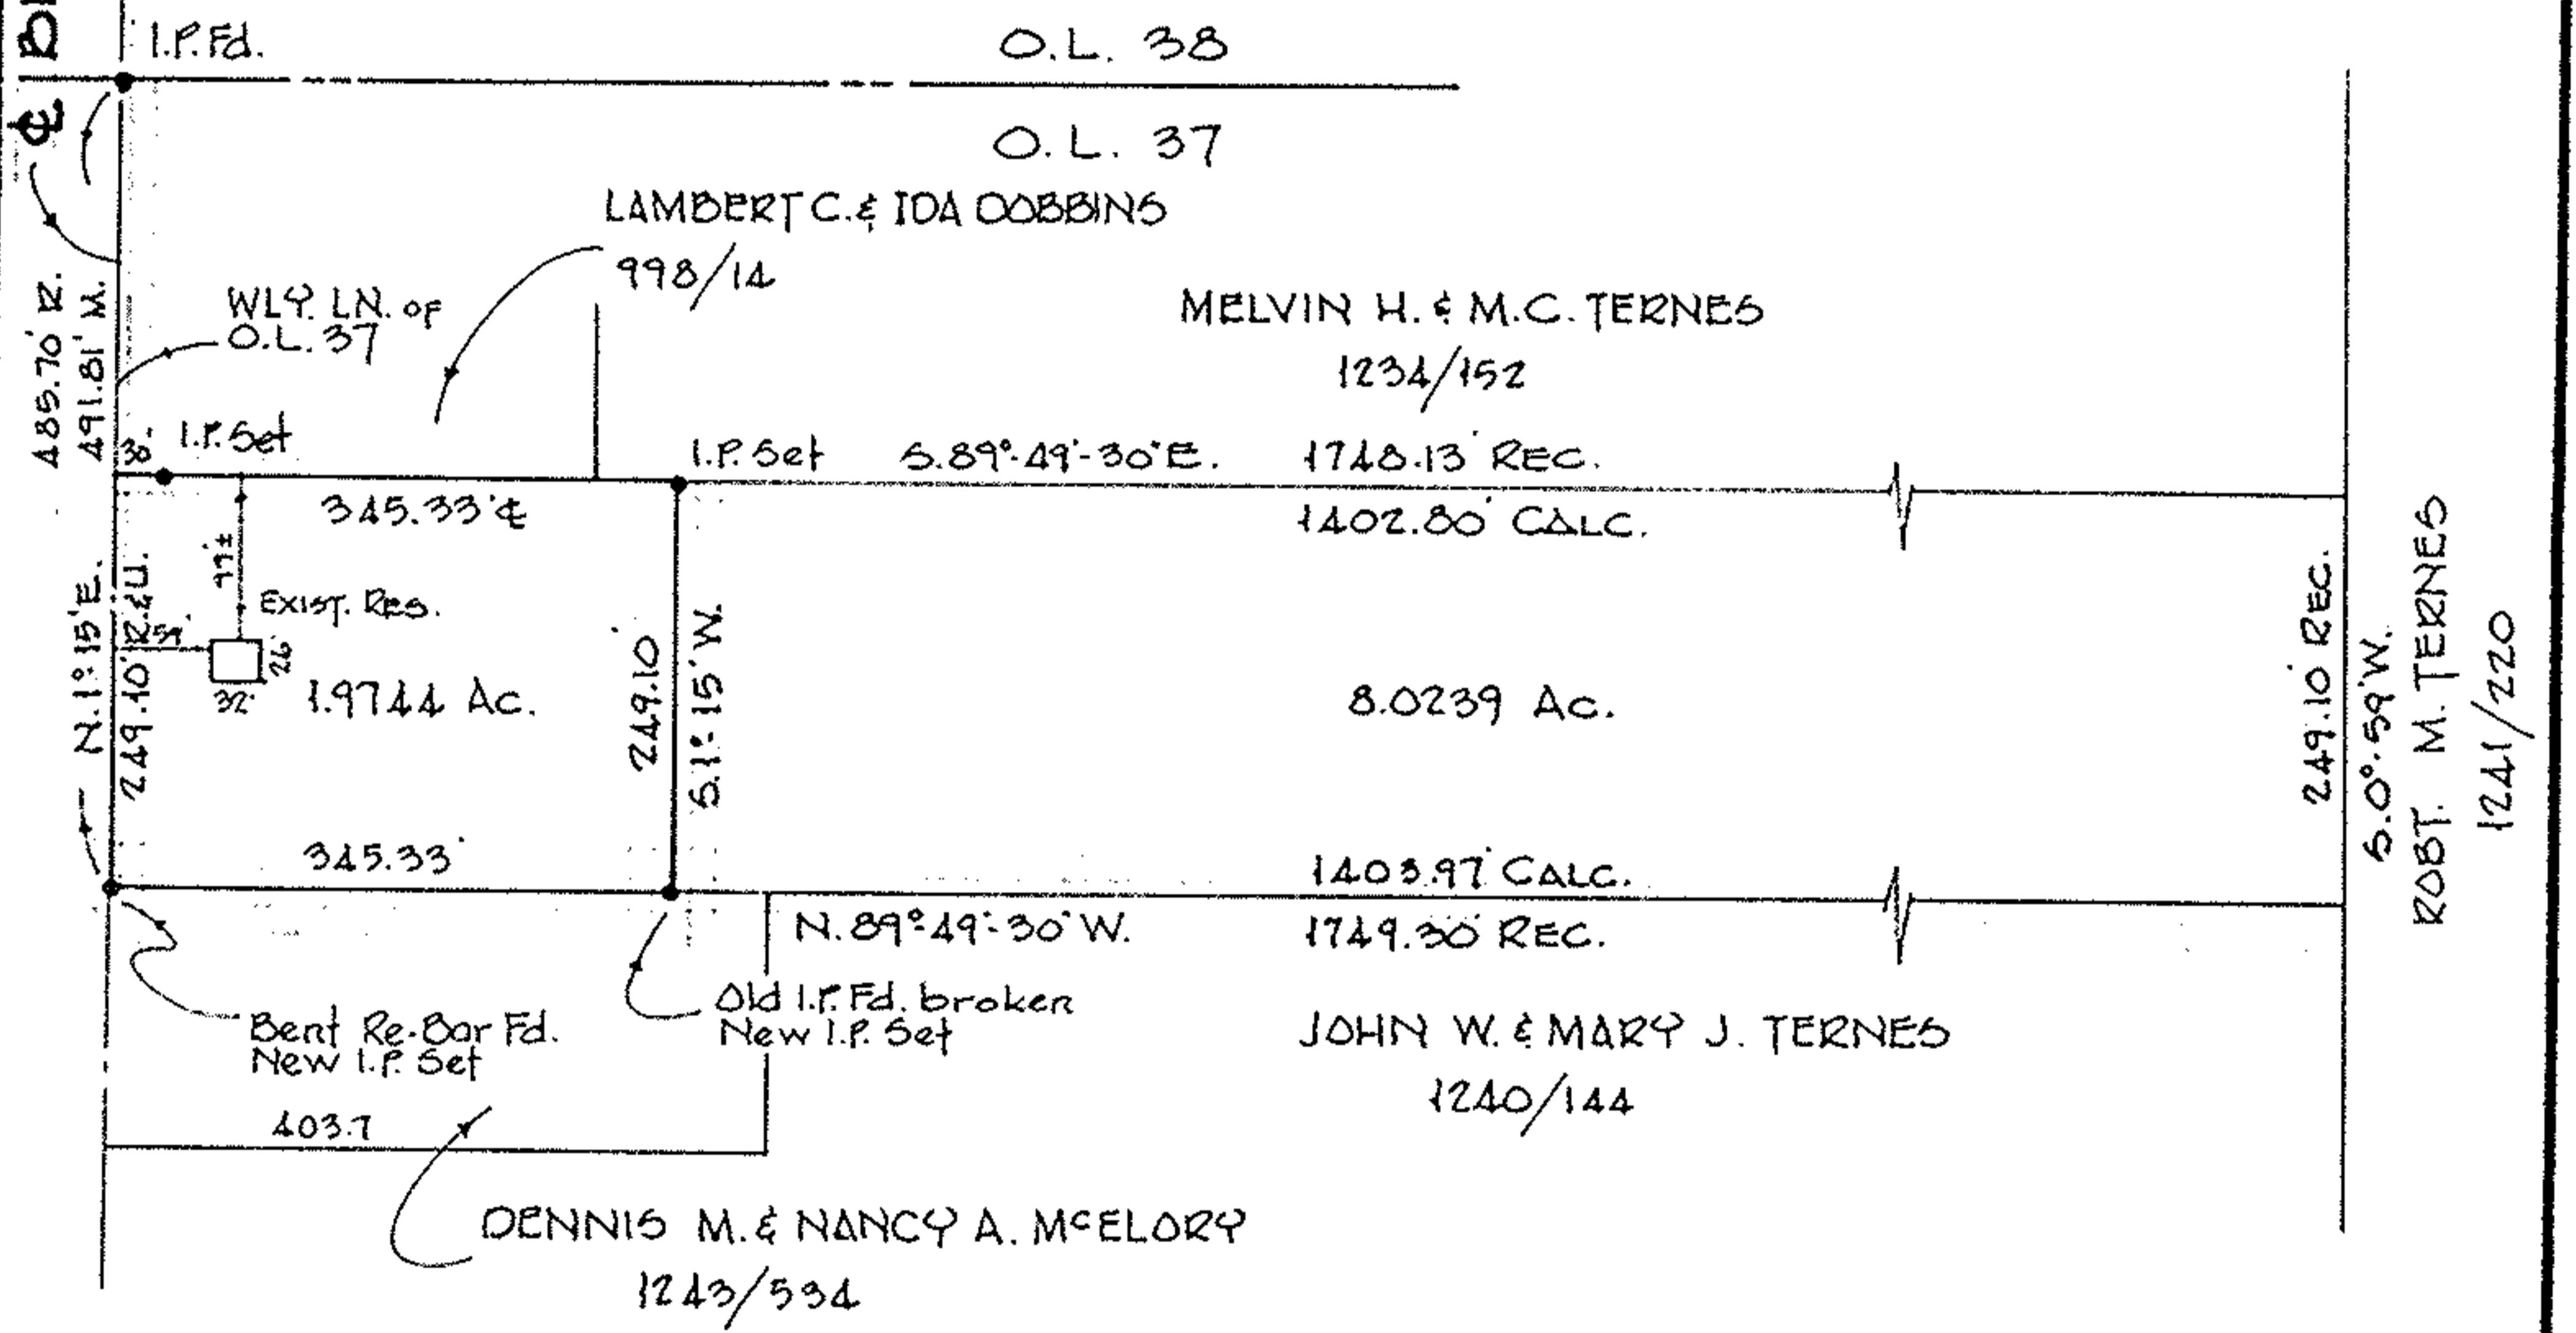

P.P. NO 07-00-037-000-016, 007, 004
 Map 0 7-E