


08-20-024-000
08-14-011-000

#19104

08-26-024-000-056

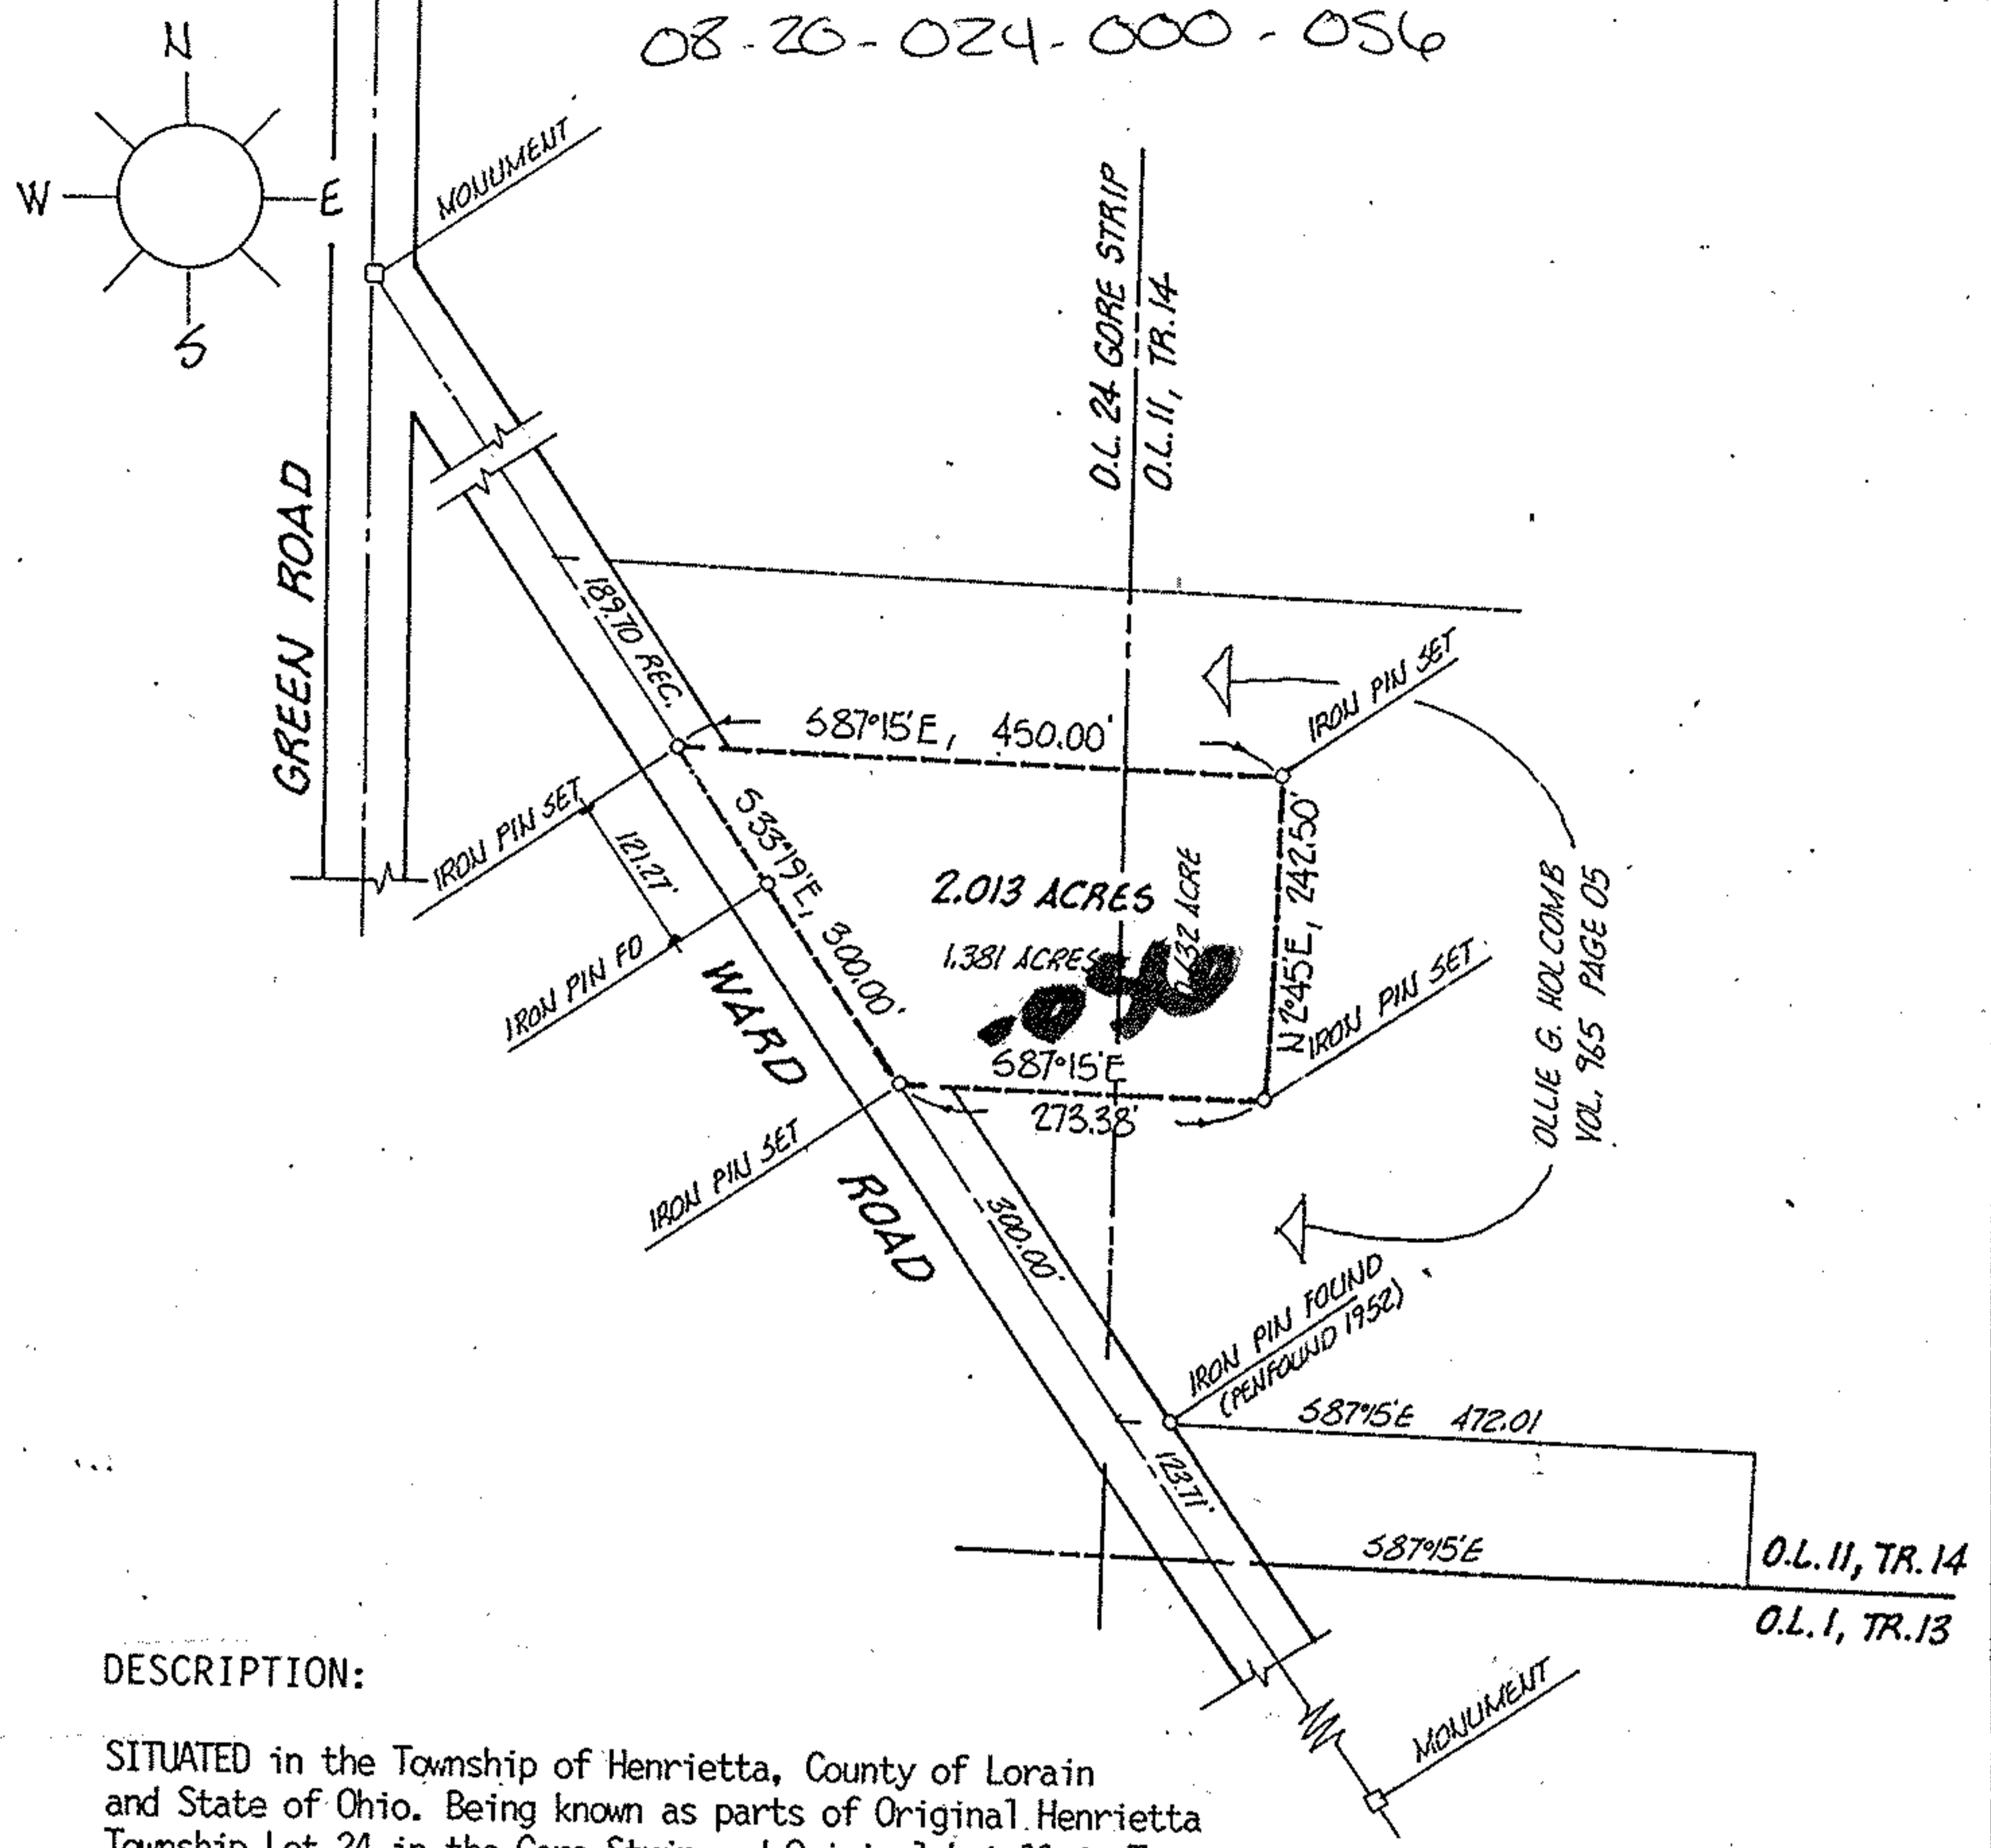

DESCRIPTION:

SITUATED in the Township of Henrietta, County of Lorain and State of Ohio. Being known as parts of Original Henrietta Township Lot 24 in the Gore Strip and Original Lot 11 in Tract 14 of said Township, bounded and described as follows;

BEGINNING at an iron pin set in the centerline of Ward Road being North 33°19' West a distance of 423.71 feet from its intersection with the south line of Original Lot 11. THENCE North 33°19' West along said centerline, a distance of 300.00 feet to an iron pin set. THENCE South 87°15' East in a line parallel to the south line of Original Lot 11, a distance of 450.00 feet to an iron pin set. THENCE South 2°45' West, a distance of 242.50 feet to an iron pin set. THENCE North 87°15' West in a line parallel to the south line of Original Lot 11, a distance of 273.38 feet to the place of beginning, embracing 2.013 acres of land, but being subject to all legal highways, as surveyed by Michael G. Hura. Said parcel embraces 0.632 acres in Original Lot 11 and 1.381 acres in Original Lot 24.

#19104

APPROVED
LORAIN CO.
MAP DEPT.

DATE 10-4-90
PAGE 8-E
BY CAROLYN FRANCIS
VOID AFTER #19104

ACREAGE 2.013	PREPARED FOR MRS. BERNARD BUCHS
DATE JULY 90	
DRAWN MGH	
SCALE 1" = 200 ft.	
	<p>MICHAEL G. HURA registered surveyor 12706 MASON ROAD, VERMILION, OHIO [216] 965-4040</p>
	<p>PERIMETER SURVEY</p>
	<p>SUBLOT _____ OF _____ Volume _____ Page _____ of PLATS PART OF O.L. 11-24 TRACT 14 SECTION _____ OF HENRIETTA TOWNSHIP LORAIN CO., OHIO Perm. Parcel No _____ Ref. deed: VOL 965 PG 05</p>

CITY OF

8-E