MAP OF SURVEY AND LOT SPLIT

PREPARED FOR

CAROL E. AND MARIANN L. RODGERS

SITUATED IN THE TOWNSHIP OF HENRIETTA, COUNTY OF LORAIN, STATE OF OHIO
AND BEING PART OF ORIGINAL HENRIETTA TOWNSHIP LOT NO. 1, TRACT 14 AND THE GORE STRIP SECTION 25

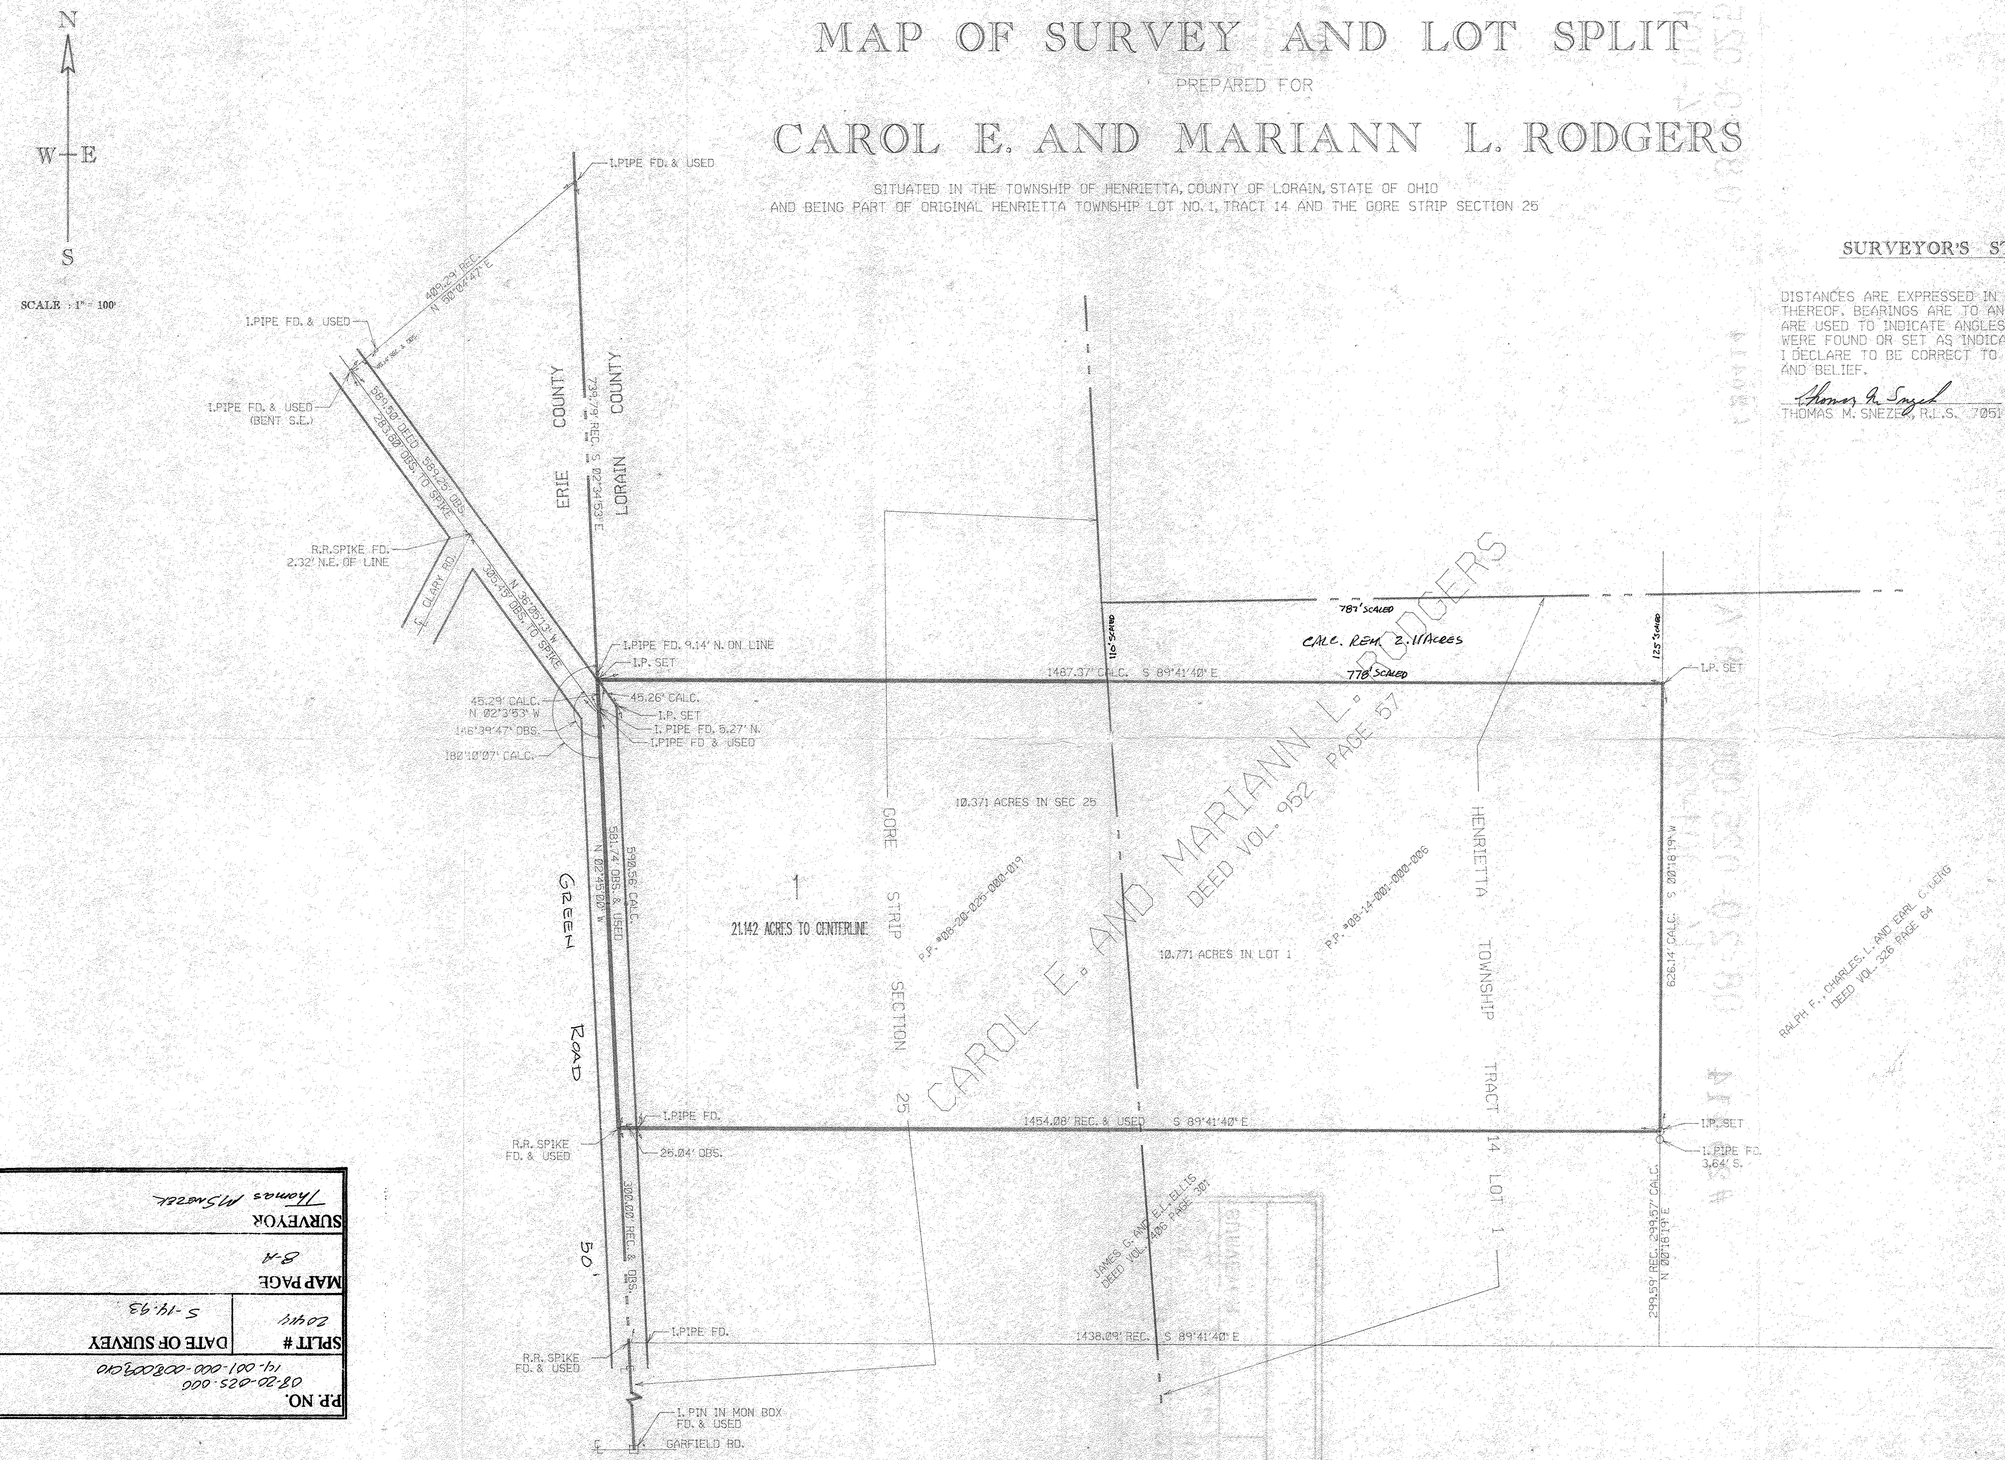

SURVEYOR'S STATEMENT

DISTANCES ARE EXPRESSED IN FEET AND DECIMALL PARTS THEREOF. BEARINGS ARE TO AN ASSUMED MERIDIAN AND ARE USED TO INDICATE ANGLES ONLY. PERMANENT MONUMENTS WERE FOUND OR SET AS INDICATED HEREON. ALL OF WHICH I DECLARE TO BE CORRECT TO THE BEST OF MY ABILITIES AND BELIEF.

Thomas M. Snezek — 5-14-93

THOMAS M. SNEZEK, P.L.S. 7051 — DATE

STATE OF OHIO — THOMAS M. SNEZEK S-7051 — SURVEYOR

P.P. NO. 02-20-025-000 14-001-000-006	
SPLIT # 20414	DATE OF SURVEY 5-14-93
MAP PAGE 8-A	
SURVEYOR Thomas M Snezek	

9307