


08-00-092-000

NORTH

J.R.L.

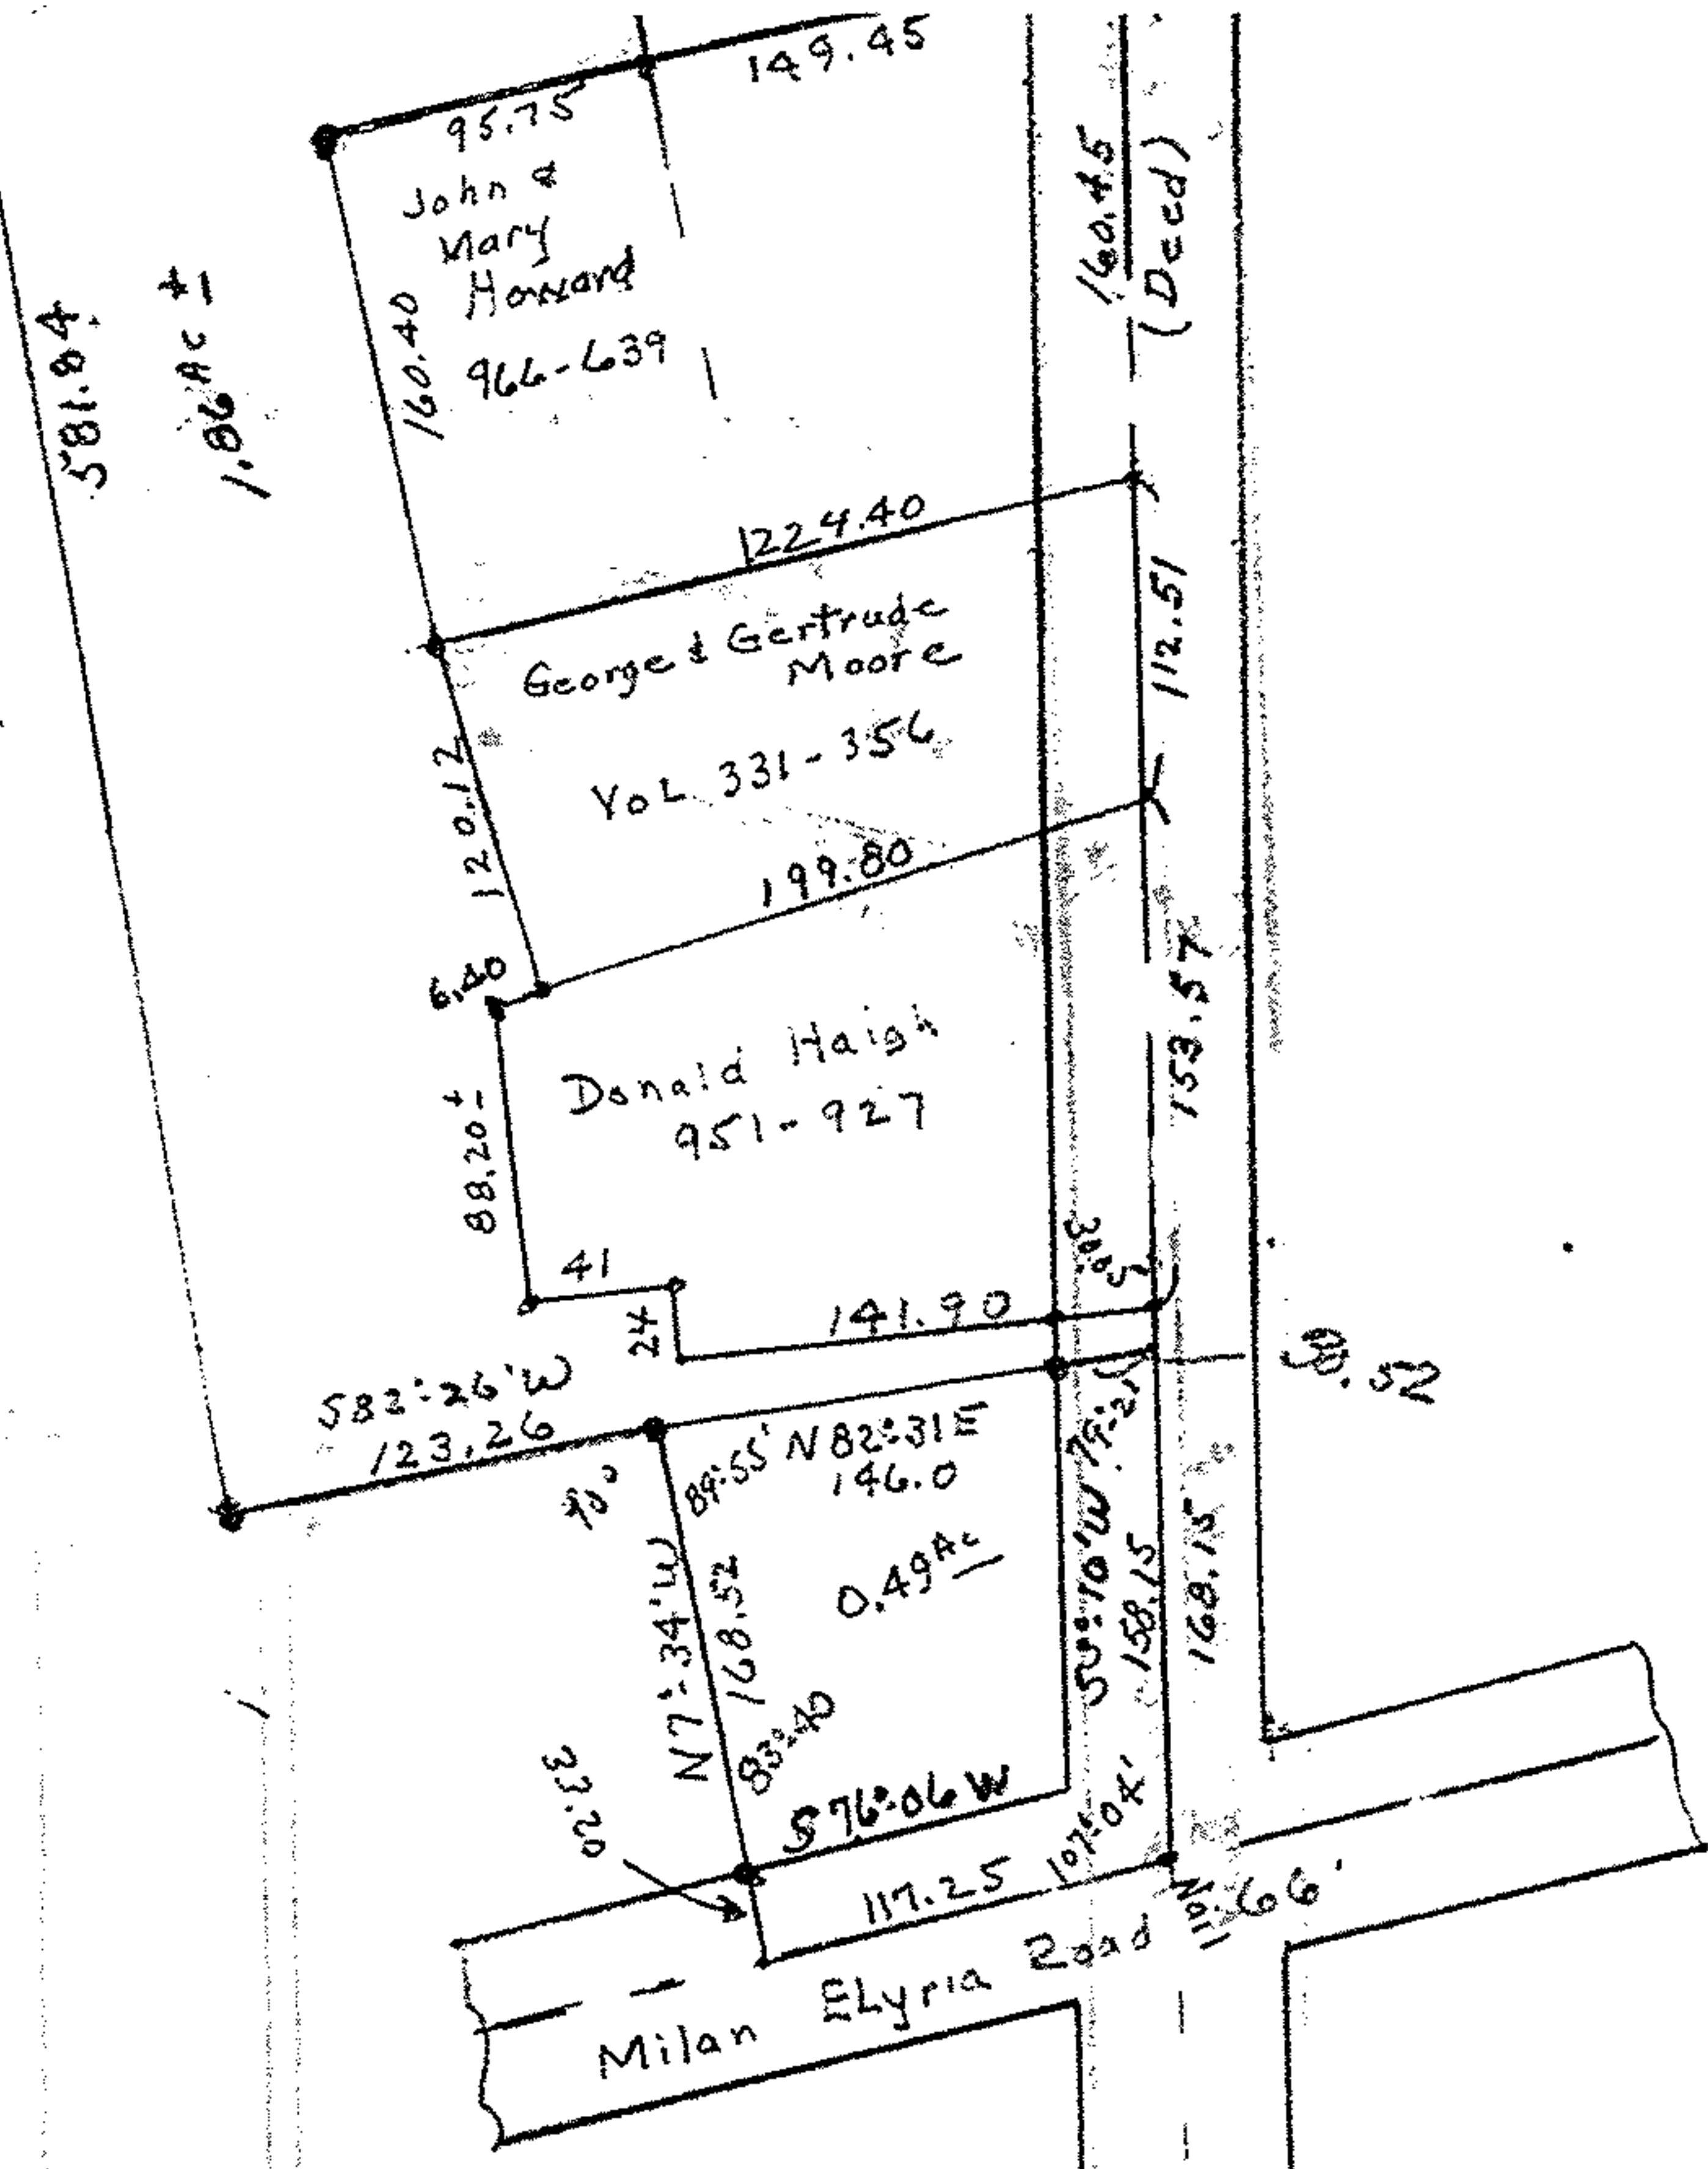


08-00-092-101-011,003

20248 A
 APPROVED
 LORAIN CO.
 MAP DEPT.
 DATE 4-28-93
 PAGE 8-00-092-B
 BY CAROLYN FRANCIS
 VOID AFTER # 20248-A

08-00-092-101-20248-A

CALL WHEN DONE → 965-8949

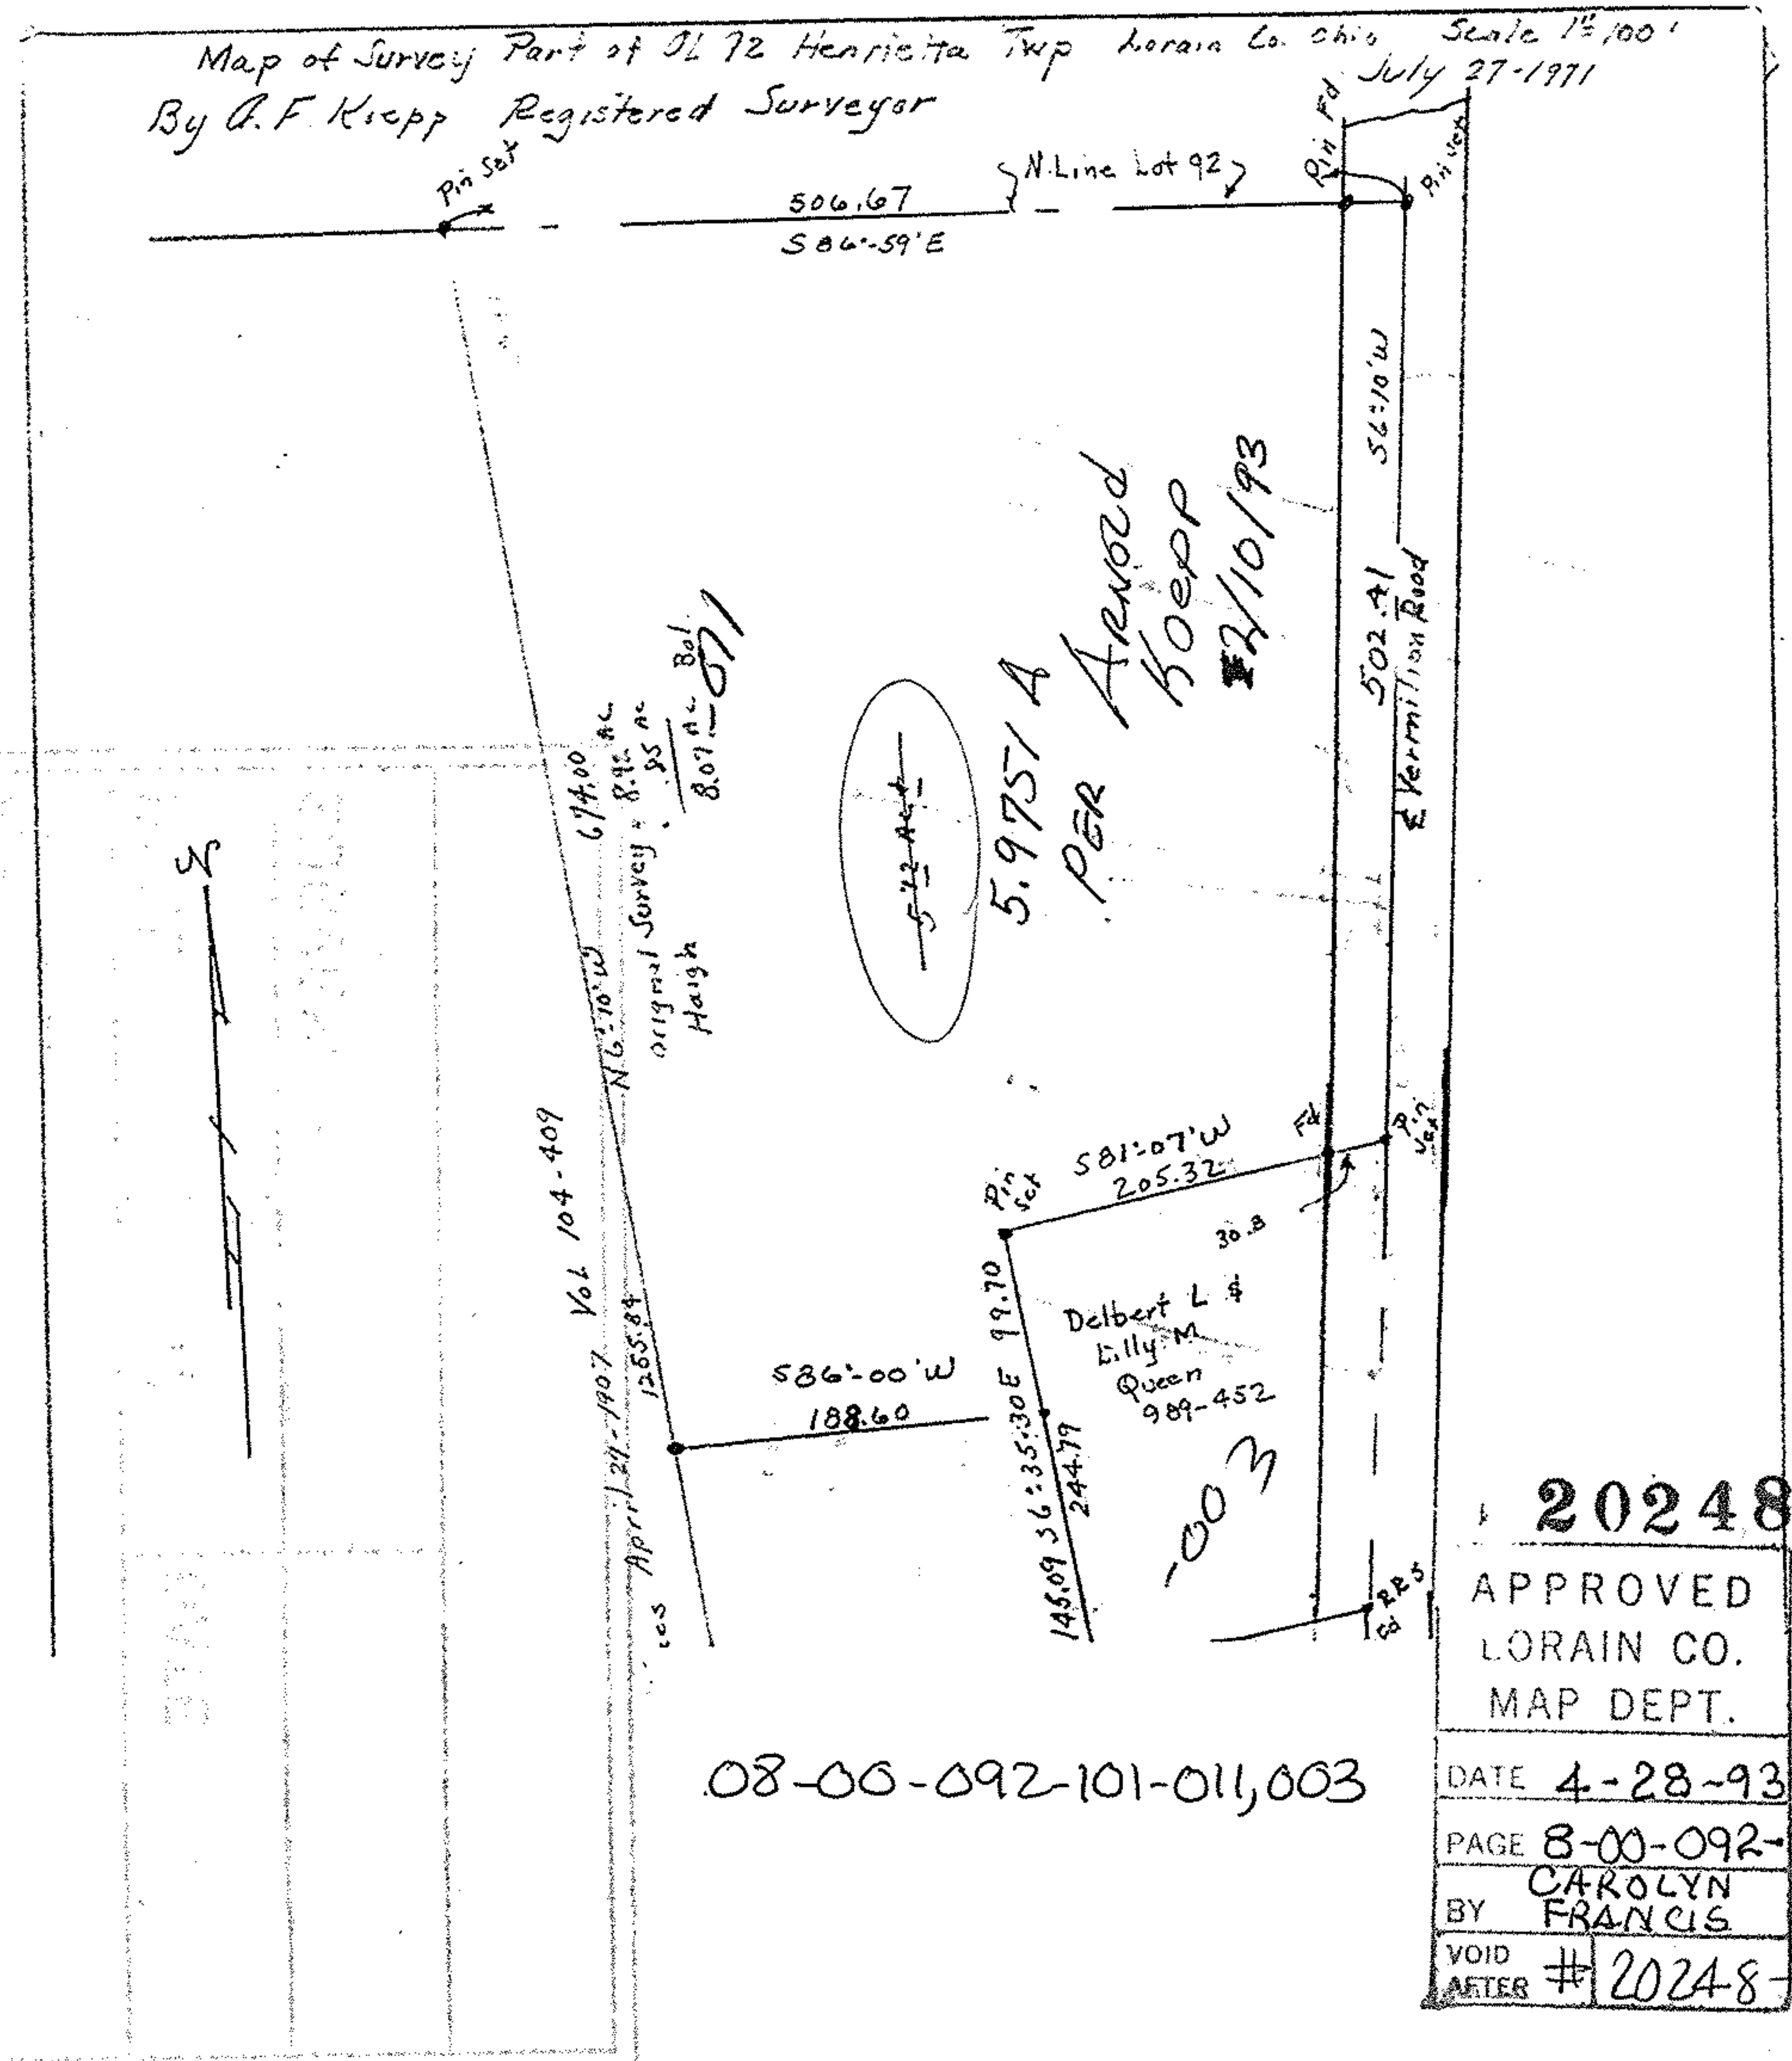

08-00-092-101-011,003

20248 A
 APPROVED
 LORAIN CO.
 MAP DEPT.
 DATE 4-28-93
 PAGE 8-00-092-B
 BY CAROLYN FRANCIS
 VOID AFTER # 20248-A