


8-E  
#19052  
CITY OF 08-12-013-000

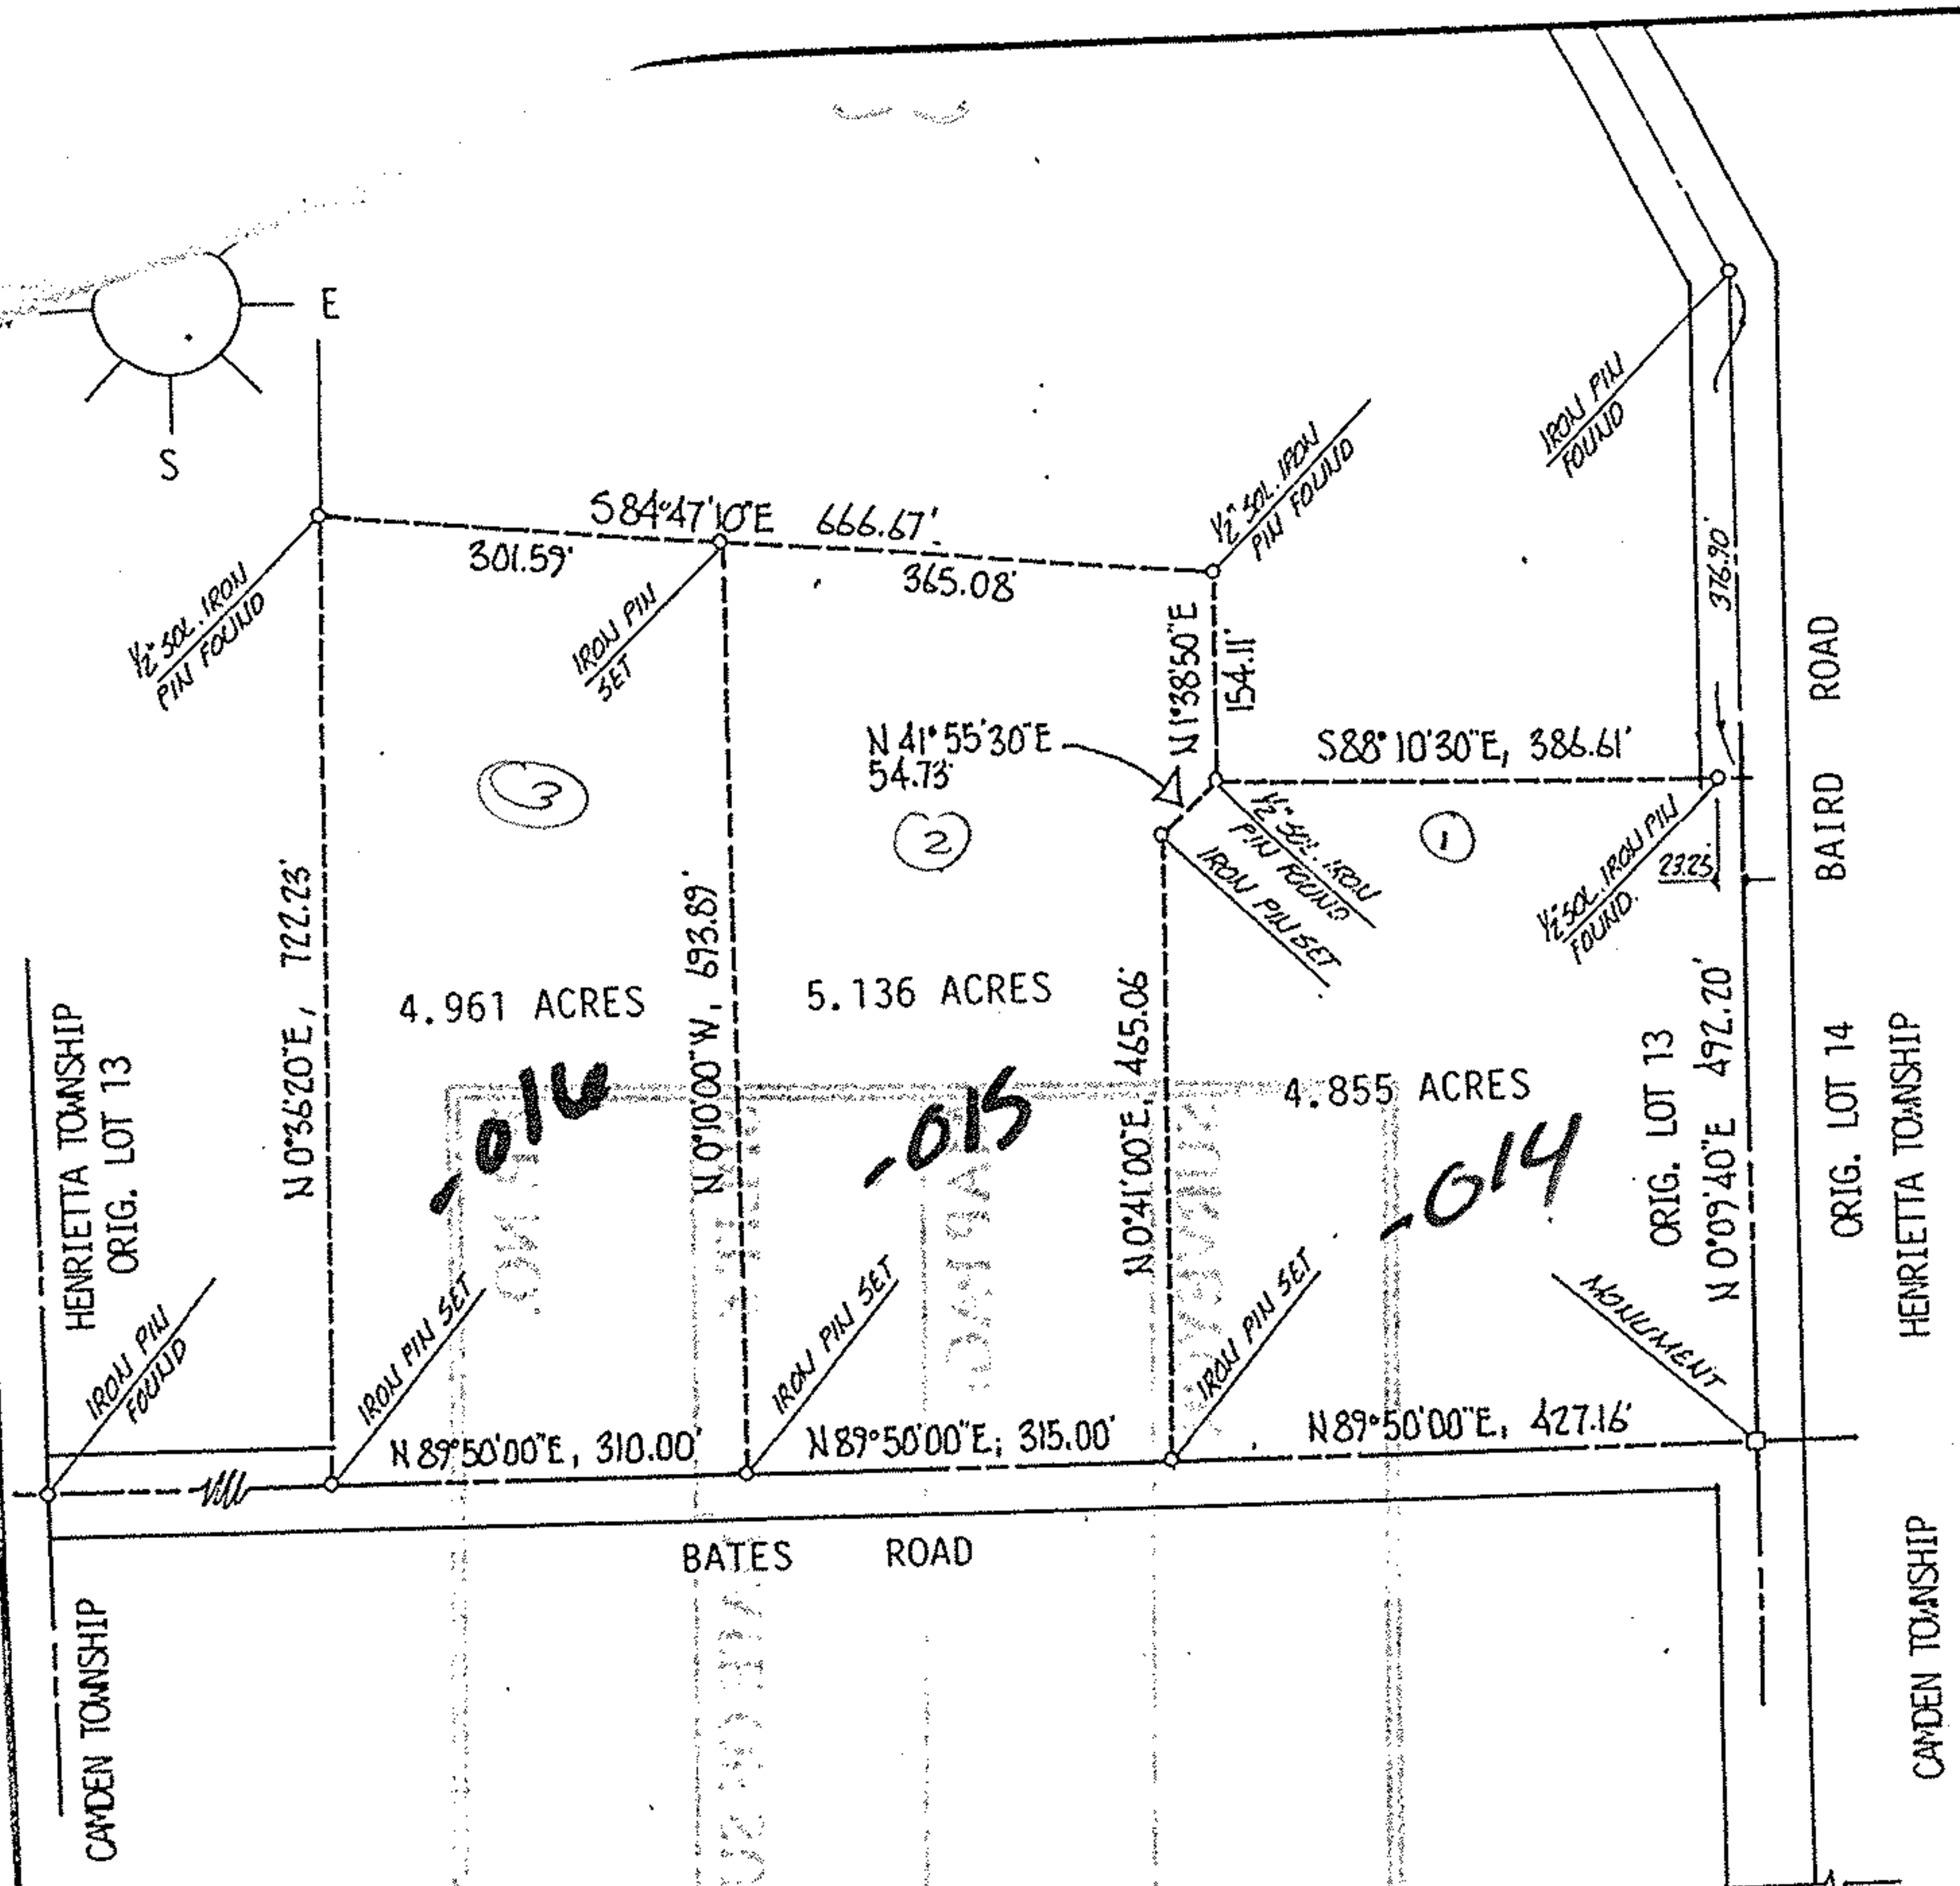

**DESCRIPTION, 4.855 ACRES:**

SITUATED in the Township of Henrietta, County of Lorain and State of Ohio. Being known as part of Original Henrietta Township Lot 13 in Tract 12, bounded and described as follows:  
 BEGINNING at a monument found at the southeast corner of Original Lot 13. THENCE South 89°50'00" West along the centerline of Bates Road, being also the south line of Original Lot 13, a distance of 427.16 feet to an iron pin set. THENCE North 0°41'00" East, a distance of 465.06 feet to an iron pin set. THENCE North 41°55'30" East, a distance of 54.73 feet to an iron pin found. THENCE South 88°10'30" East, a distance of 386.61 feet to the centerline of Baird Road, being also the east line of Original Lot 13. THENCE South 0°09'40" West along said centerline, a distance of 492.20 feet to the place of beginning, embracing 4.855 acres of land, but being subject to all legal highways.

P.P #  
08-12-013-000-014, 015, 016

#19052

APPROVED LORAIN CO. MAP DEPT.	
DATE 7-29-90	
PAGE 8-E	
BY T. McVair	
VOID AFTER	19052

ACREAGE	MISC
DATE	JULY '90
DRAWN	MGH
SCALE	1" = 200 ft.

PREPARED FOR SWANZER AGENCY

MICHAEL G. HURA registered surveyor  
12706 MASON ROAD, VERMILION, OHIO [216] 965-4040



**PERIMETER SURVEY**

SUBLOT \_\_\_\_\_ OF \_\_\_\_\_  
 Volume \_\_\_\_\_ Page \_\_\_\_\_ of PLATS  
 PART OF O.L. 13 TRACT 12 SECTION \_\_\_\_\_ OF  
HENRIETTA TOWNSHIP LORAIN CO., OHIO  
 Perm. Parcel No \_\_\_\_\_ Ref. deed: