08-00-097-000-039
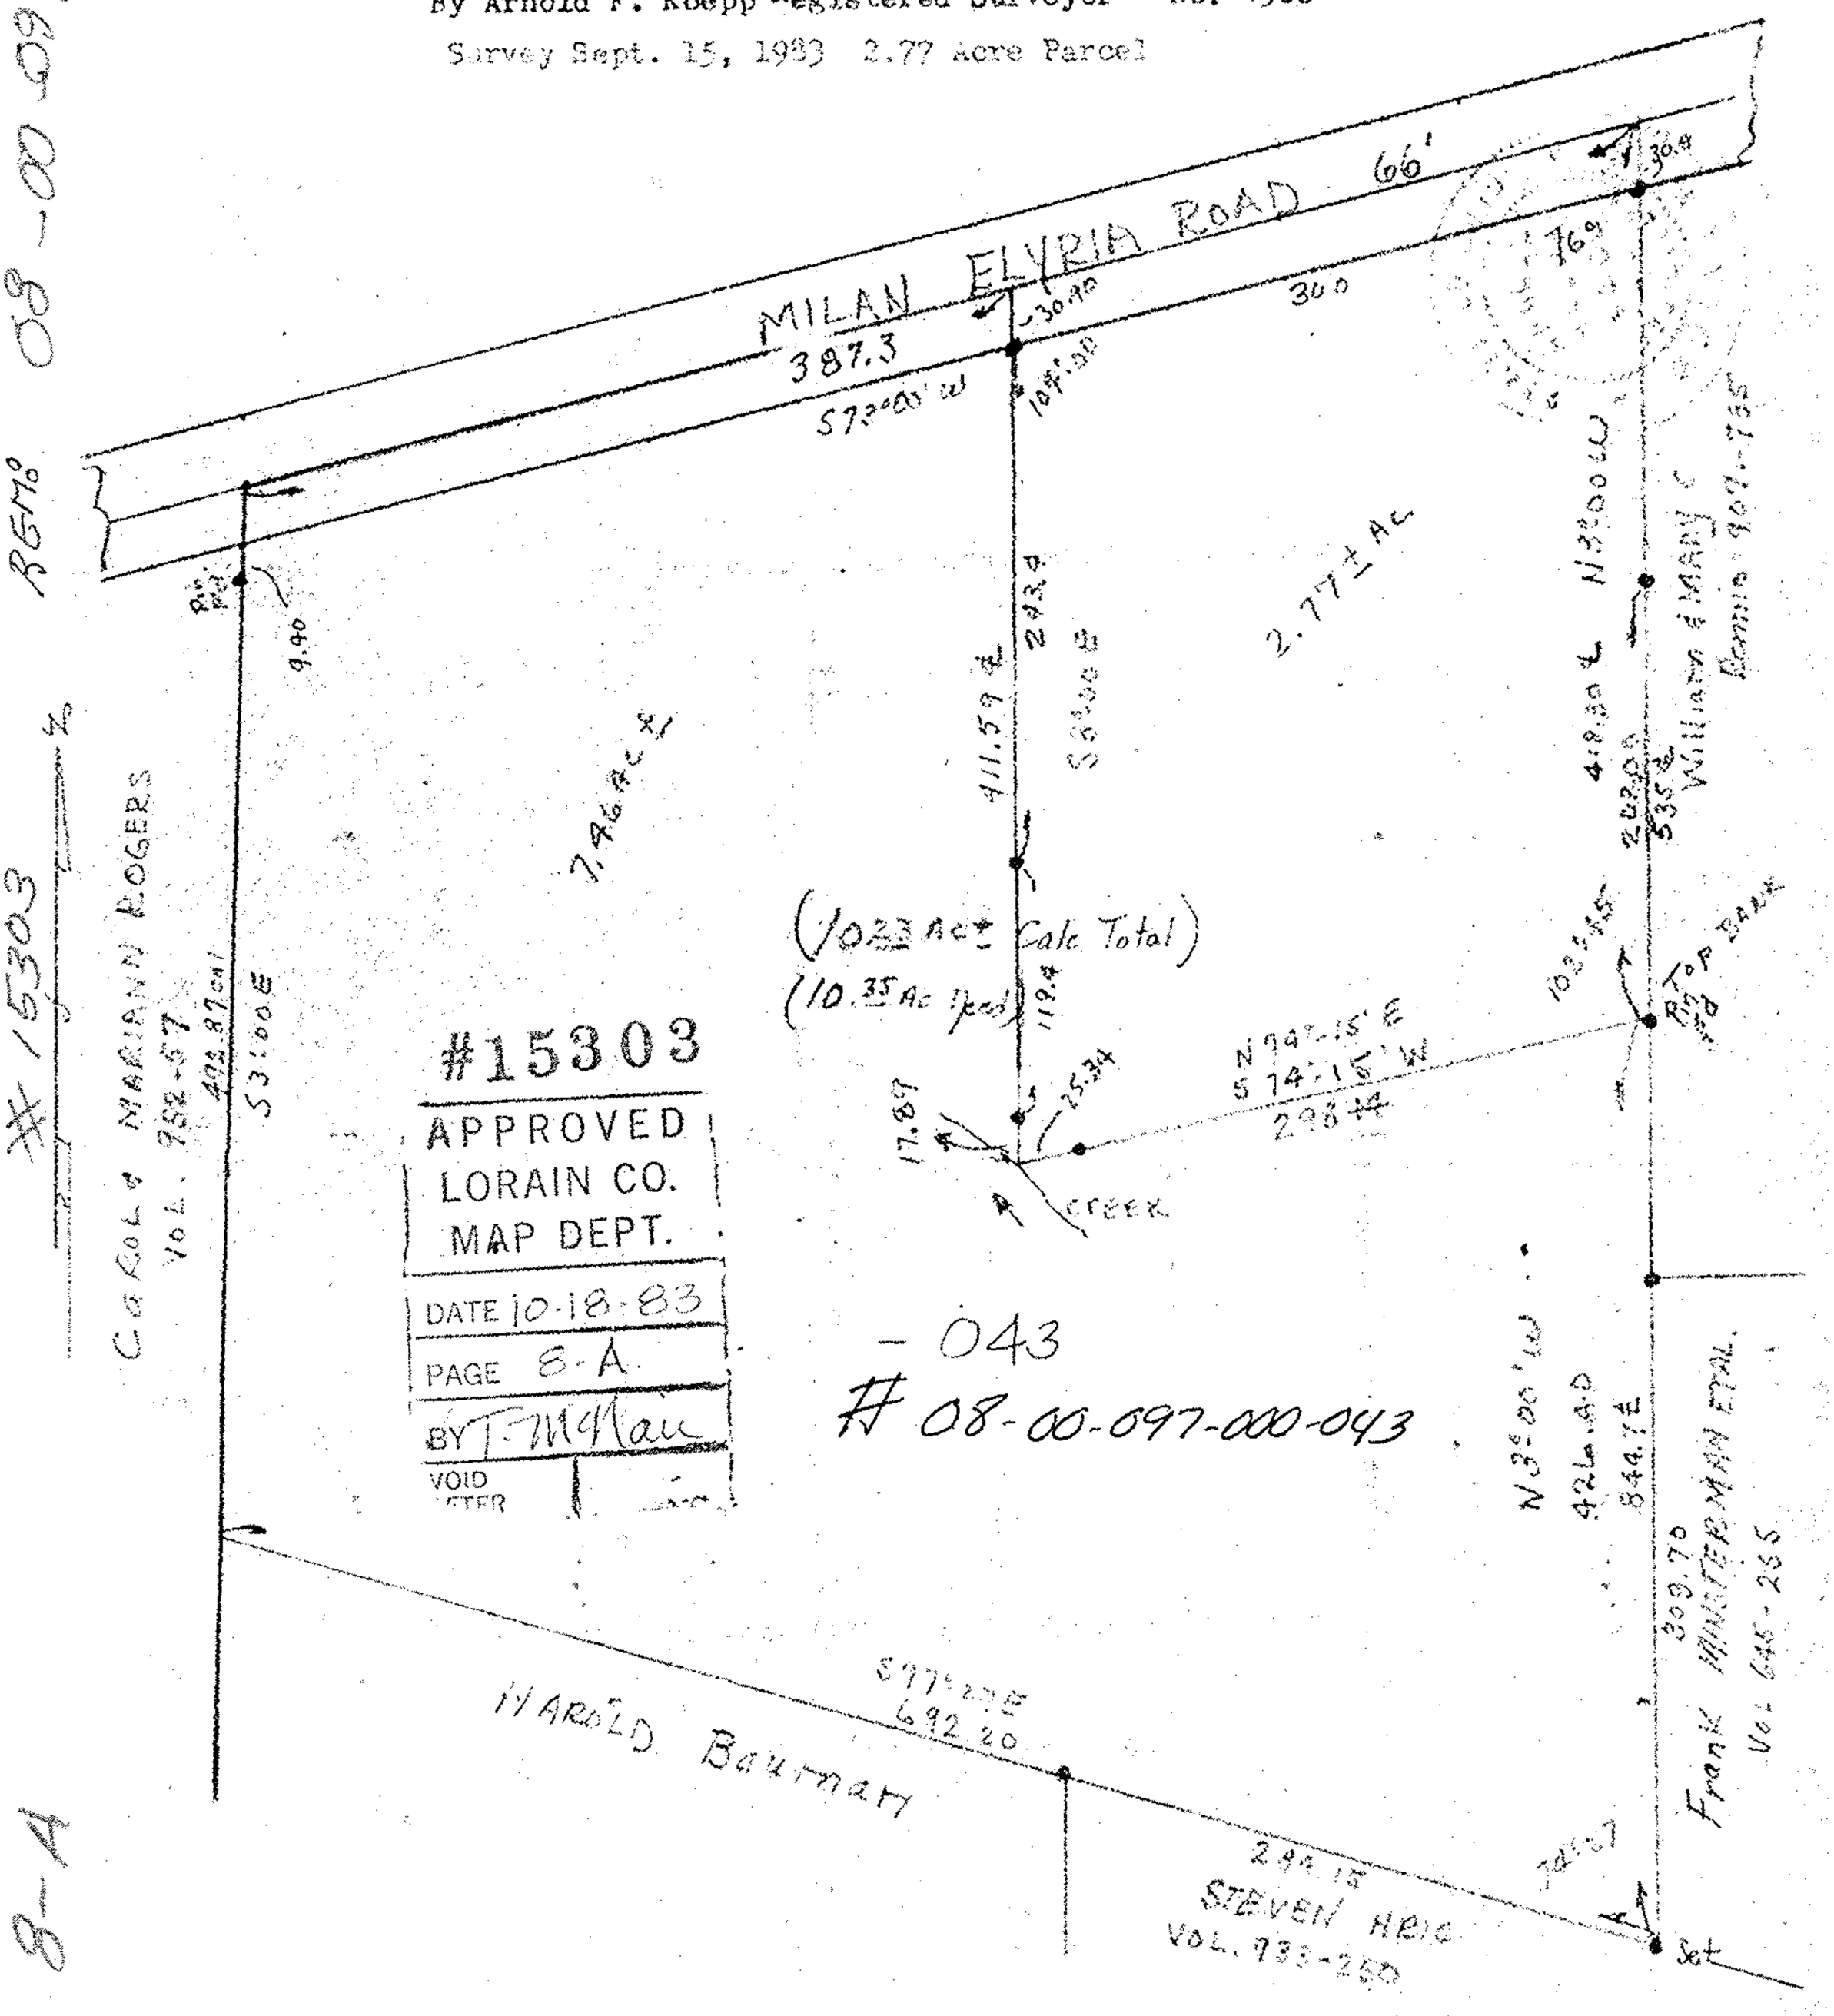
Map of Part of O.L. 97 Henrietta Twp. Lorain Co. Ohio
Scale 1" 100' Nov. 28, 1979
By Arnold F. Koepp Registered Surveyor No. 4306
Survey Sept. 15, 1983 2.77 Acre Parcel