Original Farm: N88°56'45"W, 2755.75', N2°09'00"W, 1,592.41'
S88°56'45"E, 2,777.52', S1°21'40"E, 1,591.33'
Area = 100.9778 Acres By Survey

CENTERLINE DATA
P.I. = 7+97.94 Δ = 16°24'43" D = 0°30'00"
T = 1652.51' L = 3282.39' R = 11,459.16'

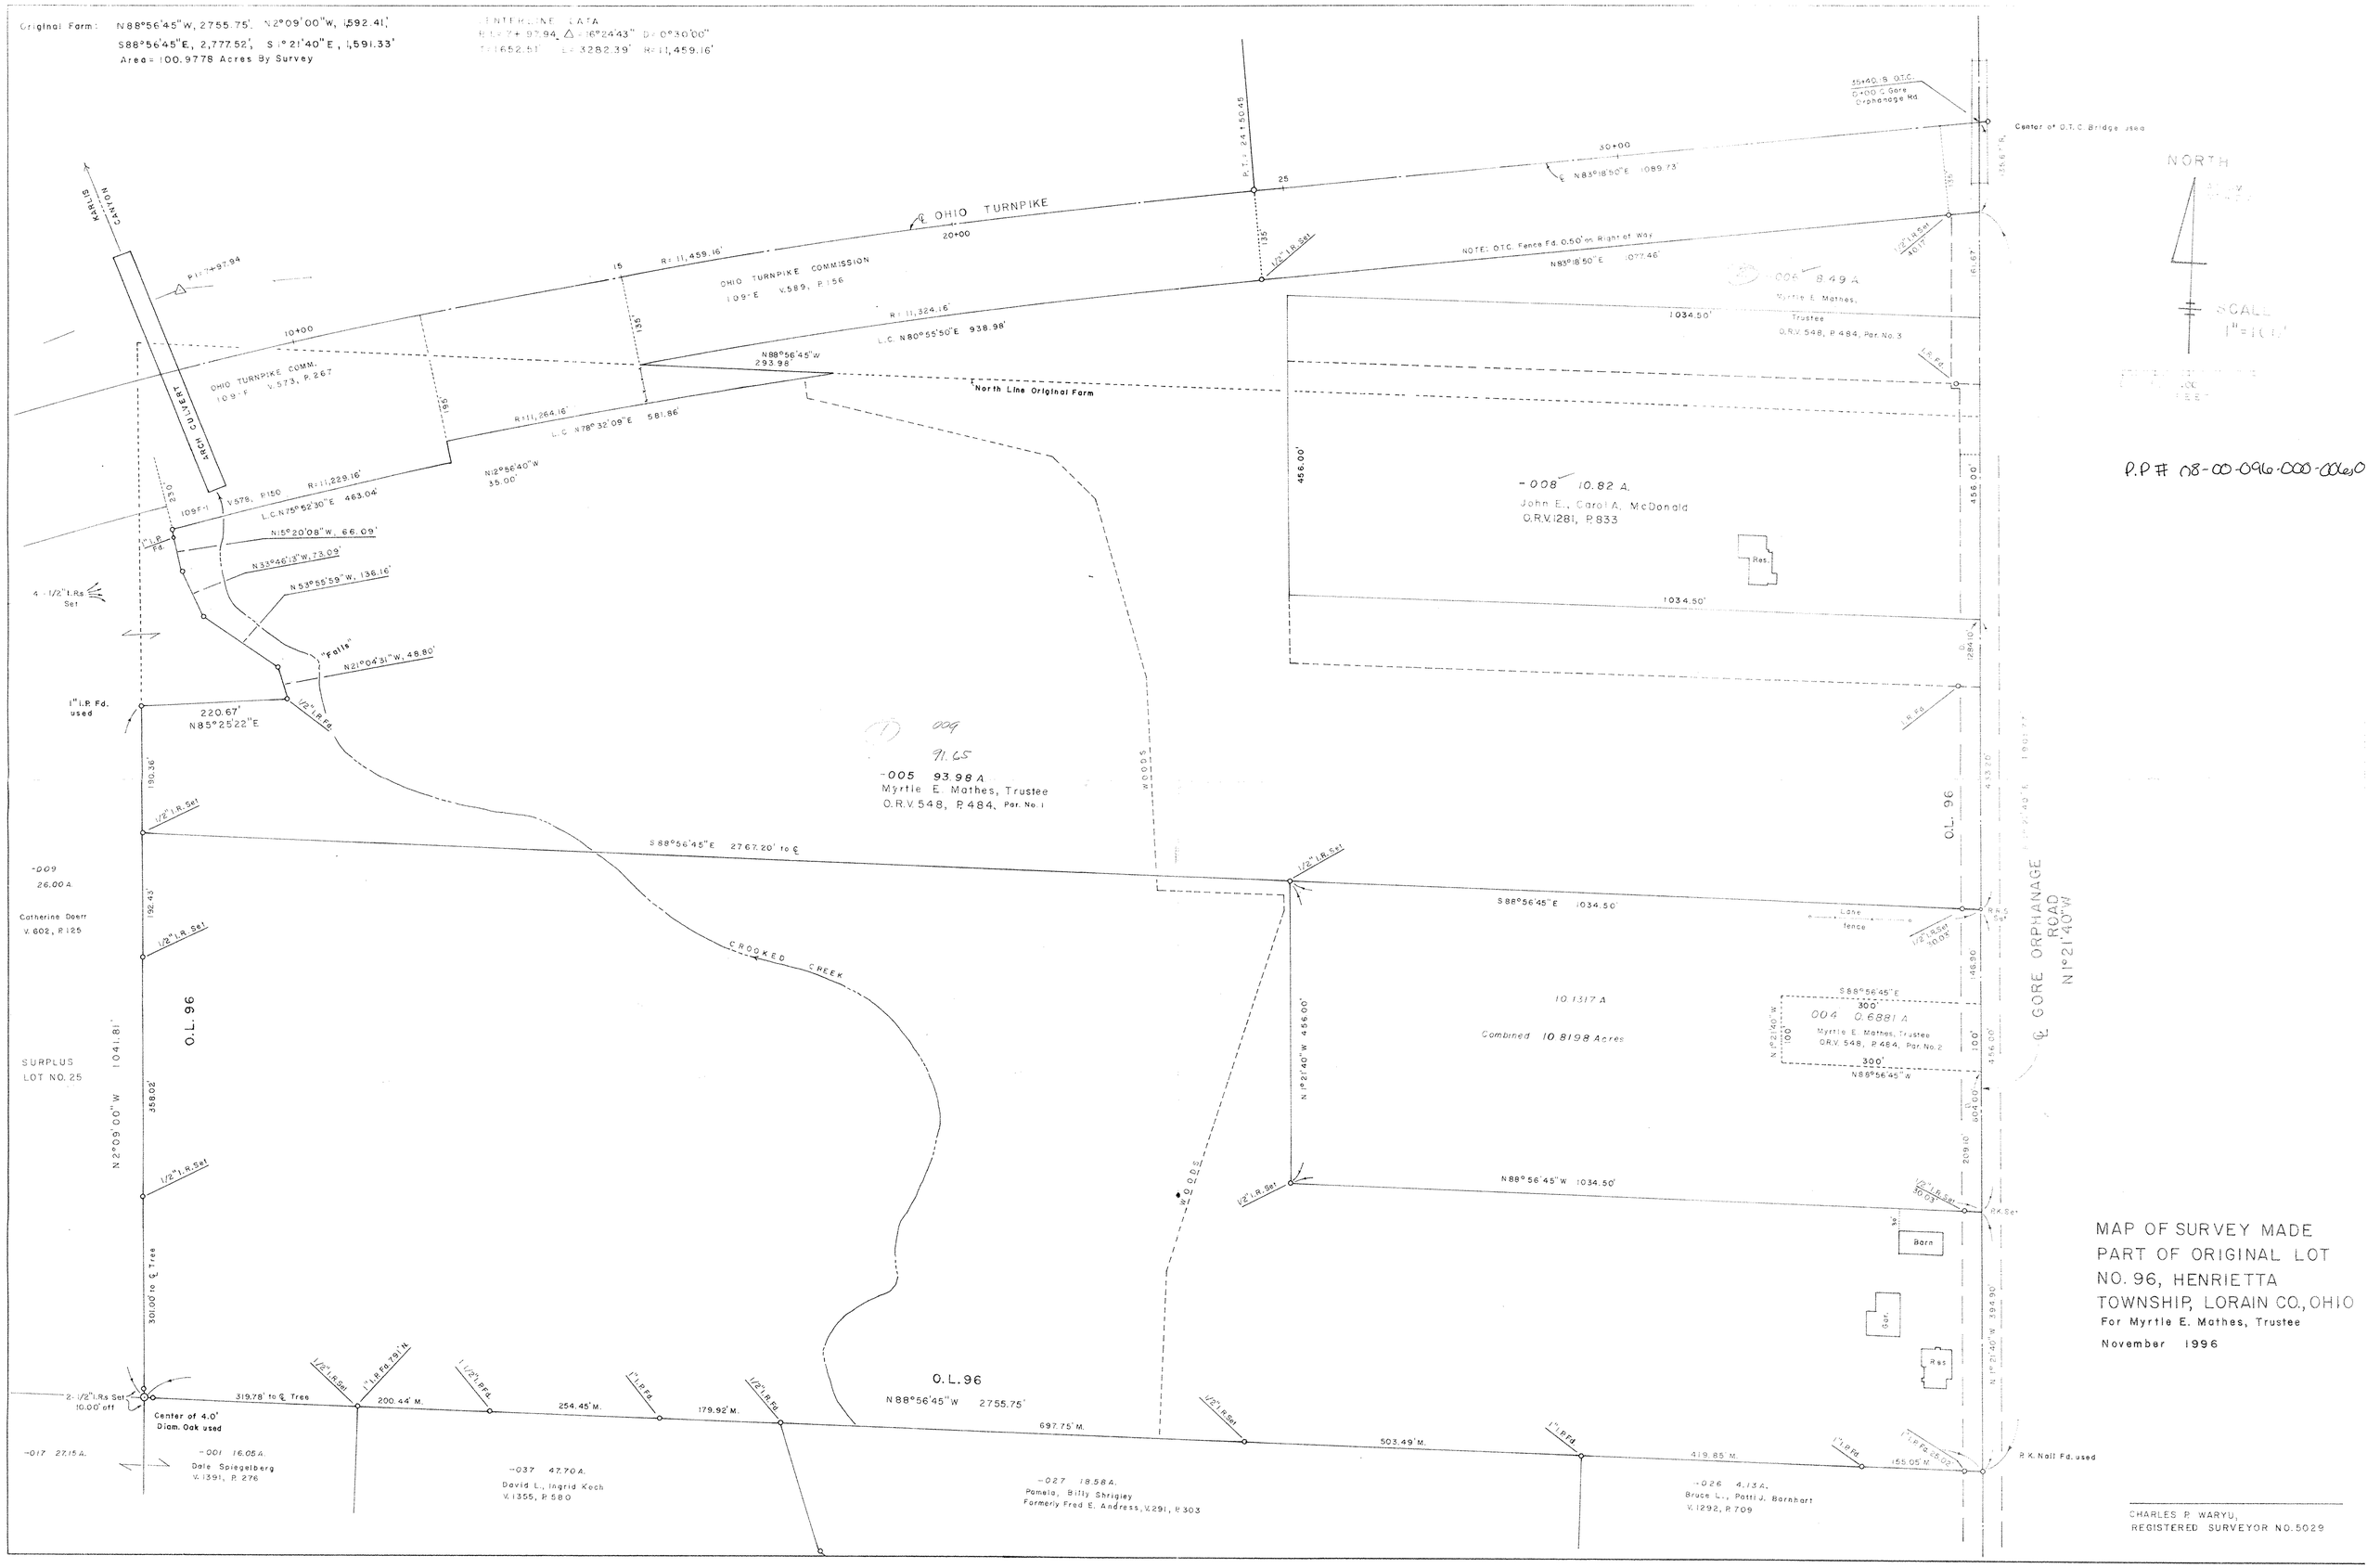

P.P # 08-00-096-000-006s0

MAP OF SURVEY MADE
PART OF ORIGINAL LOT
NO. 96, HENRIETTA
TOWNSHIP, LORAIN CO., OHIO
For Myrtle E. Mathes, Trustee
November 1996

CHARLES P. WARYU,
REGISTERED SURVEYOR NO. 5029