



LAUNDON . SIMON . CAHL & ASSOC. INC.  
 CONSULTING ENGINEERS & SURVEYORS  
 219 COURT ST. ELYRIA, OHIO 44035


SURVEY FOR

**JOHN & NANCY SCOTT**

Orig. Lot 101	City of	Date 12-20-89	Scale 1"=100'
Orig. Sec	Village of	Dwn. by R.G.S.	Chkd. by K.B.
Tract	County of LORAIN	Job No. 89-1887	F.B.
Township of HENRIETTA	State of OHIO	Printed JAN 2	

P.P # 08-00-101-000-025, 026

FIRELANDS LOCAL SCHOOL DISTRICT  
 V. 566 P. 443

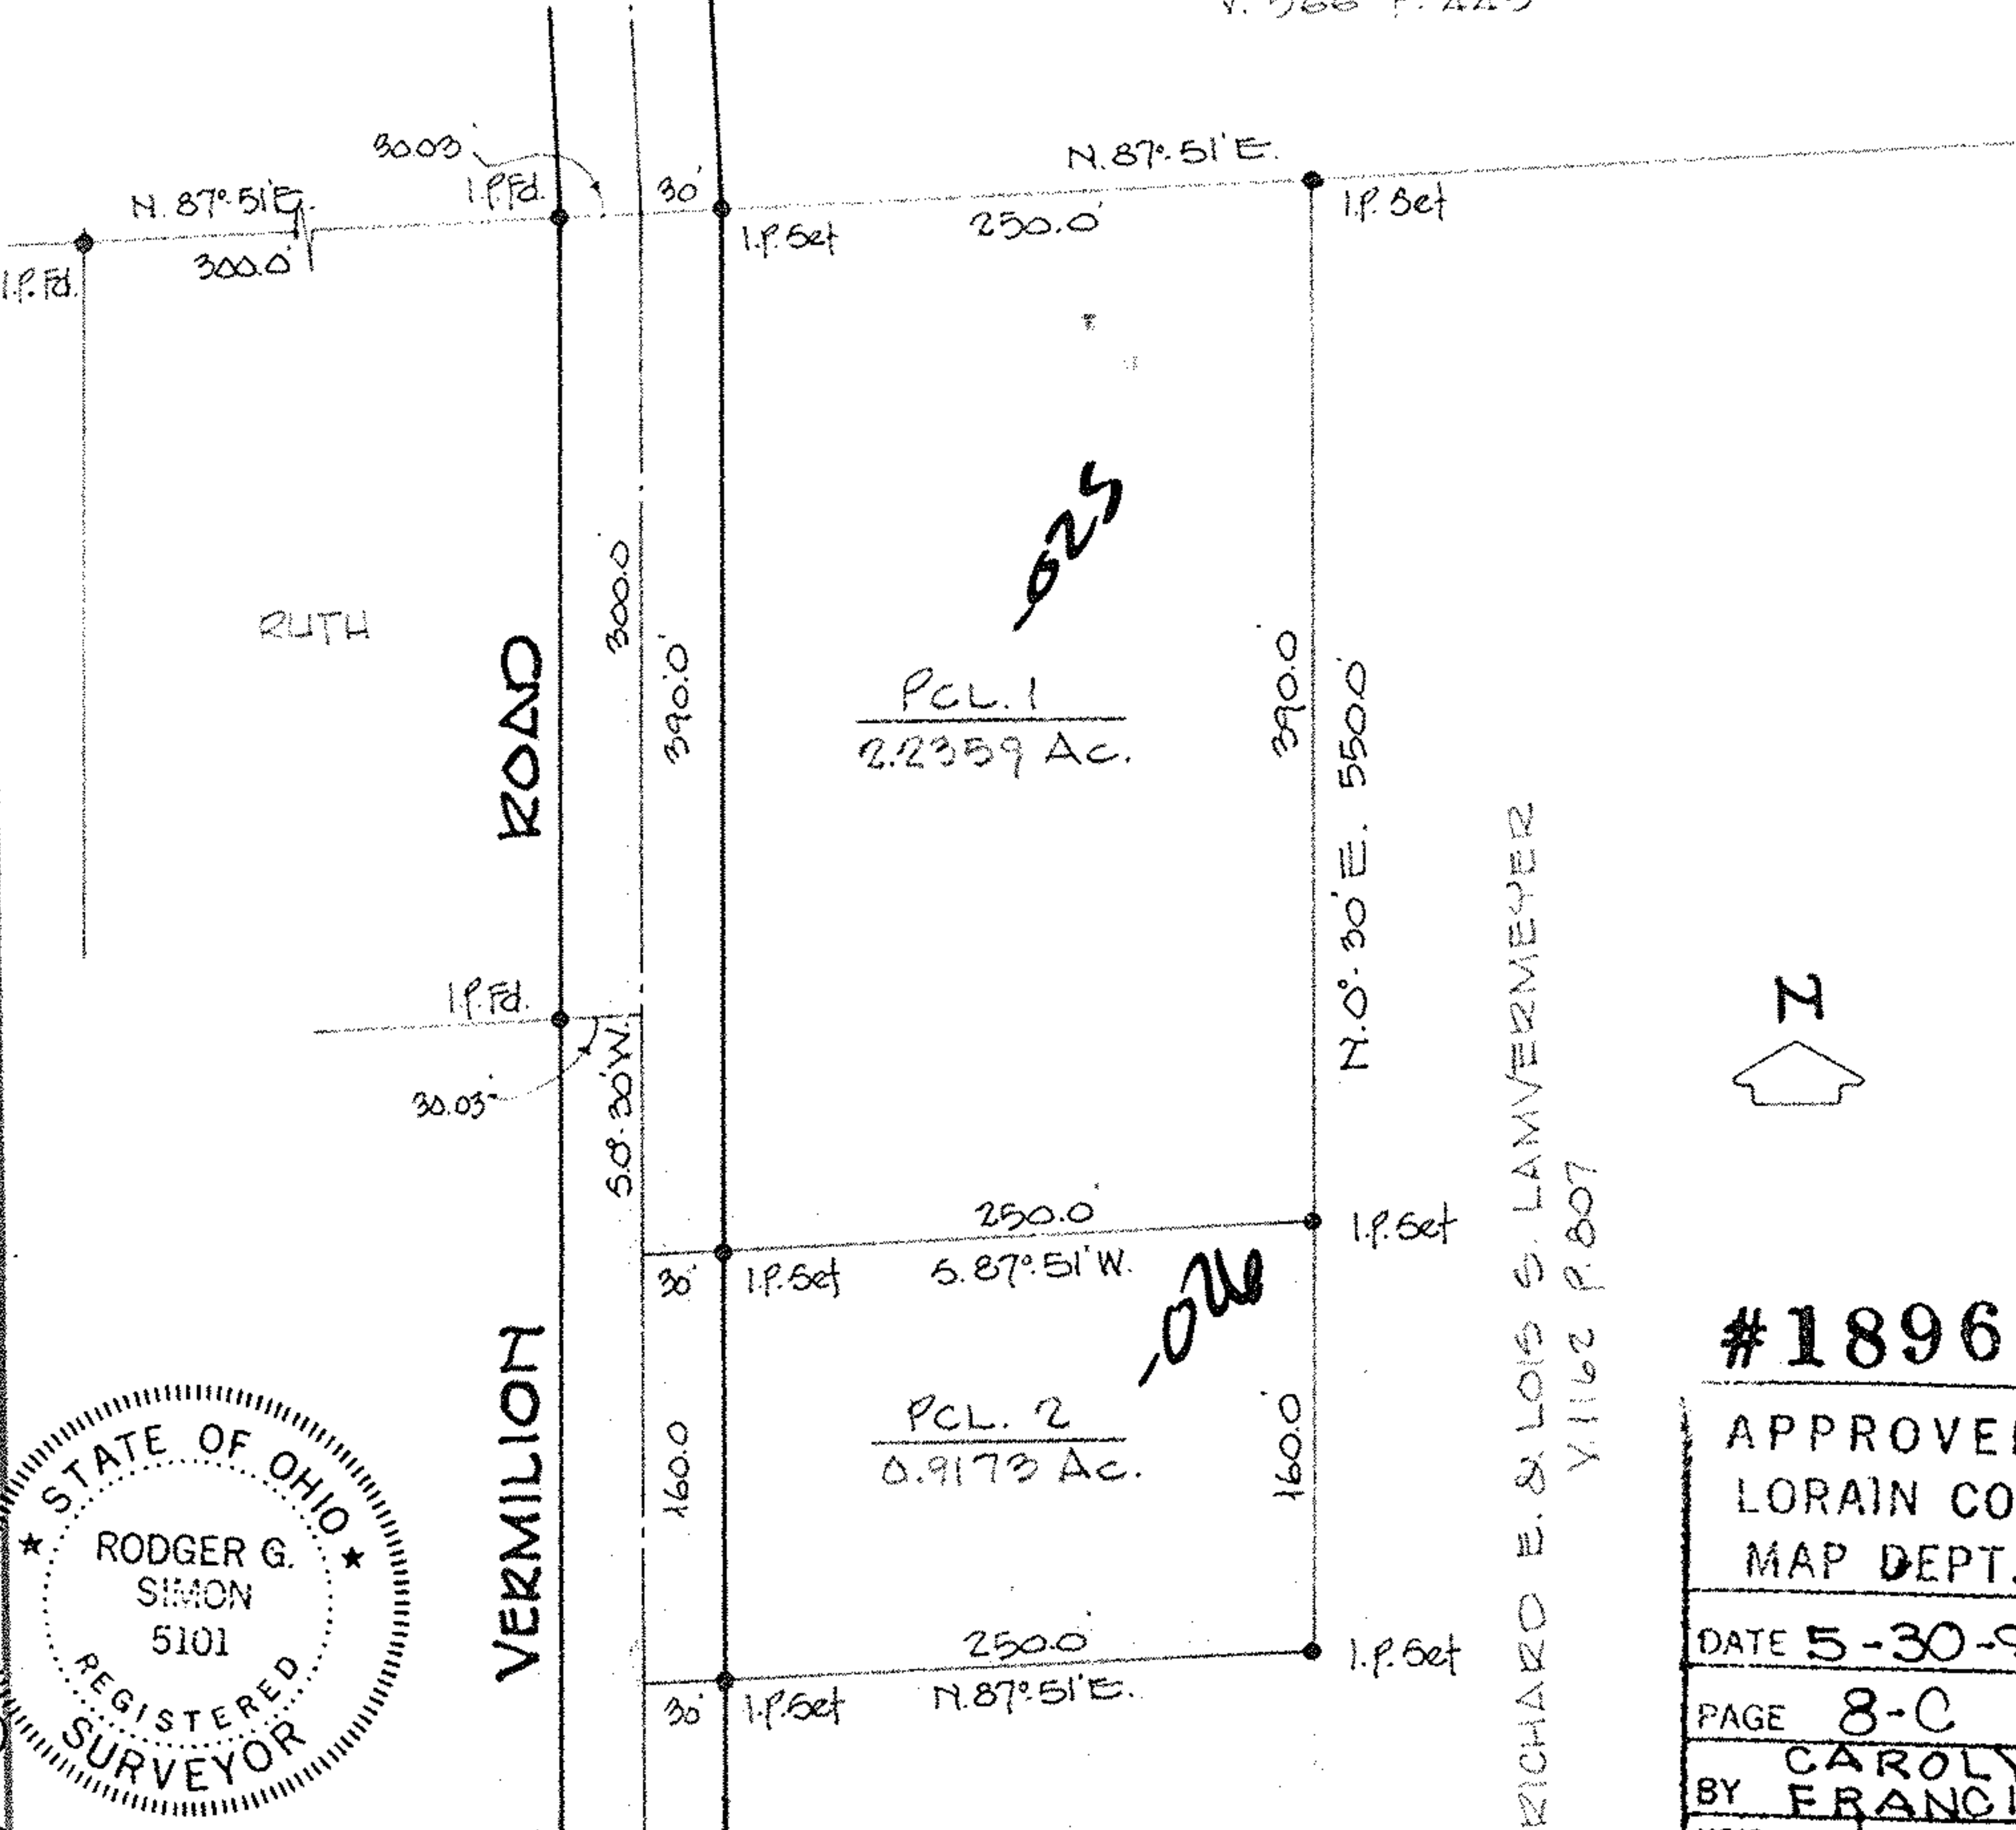

#18961

08-00-101-000-025-026



RICHARD E. & LOIS S. LAMVERMEYER  
 Y1162 P. 807

#18961

APPROVED  
 LORAIN CO.  
 MAP DEPT.

DATE 5-30-90

PAGE 8-C

BY CAROLYN FRANCIS

VOID AFTER # 18961