7-00-021

6232

Ridgeville Co

7-00-021

SURVEY

PART OF

ORIGINAL RIDGEVILLE TOWNSHIP LOT 21
CITY OF N. RIDGEVILLE
COUNTY OF LORAIN , STATE OF OHIO
JULY, 1972 SCALE: 1" = 40'

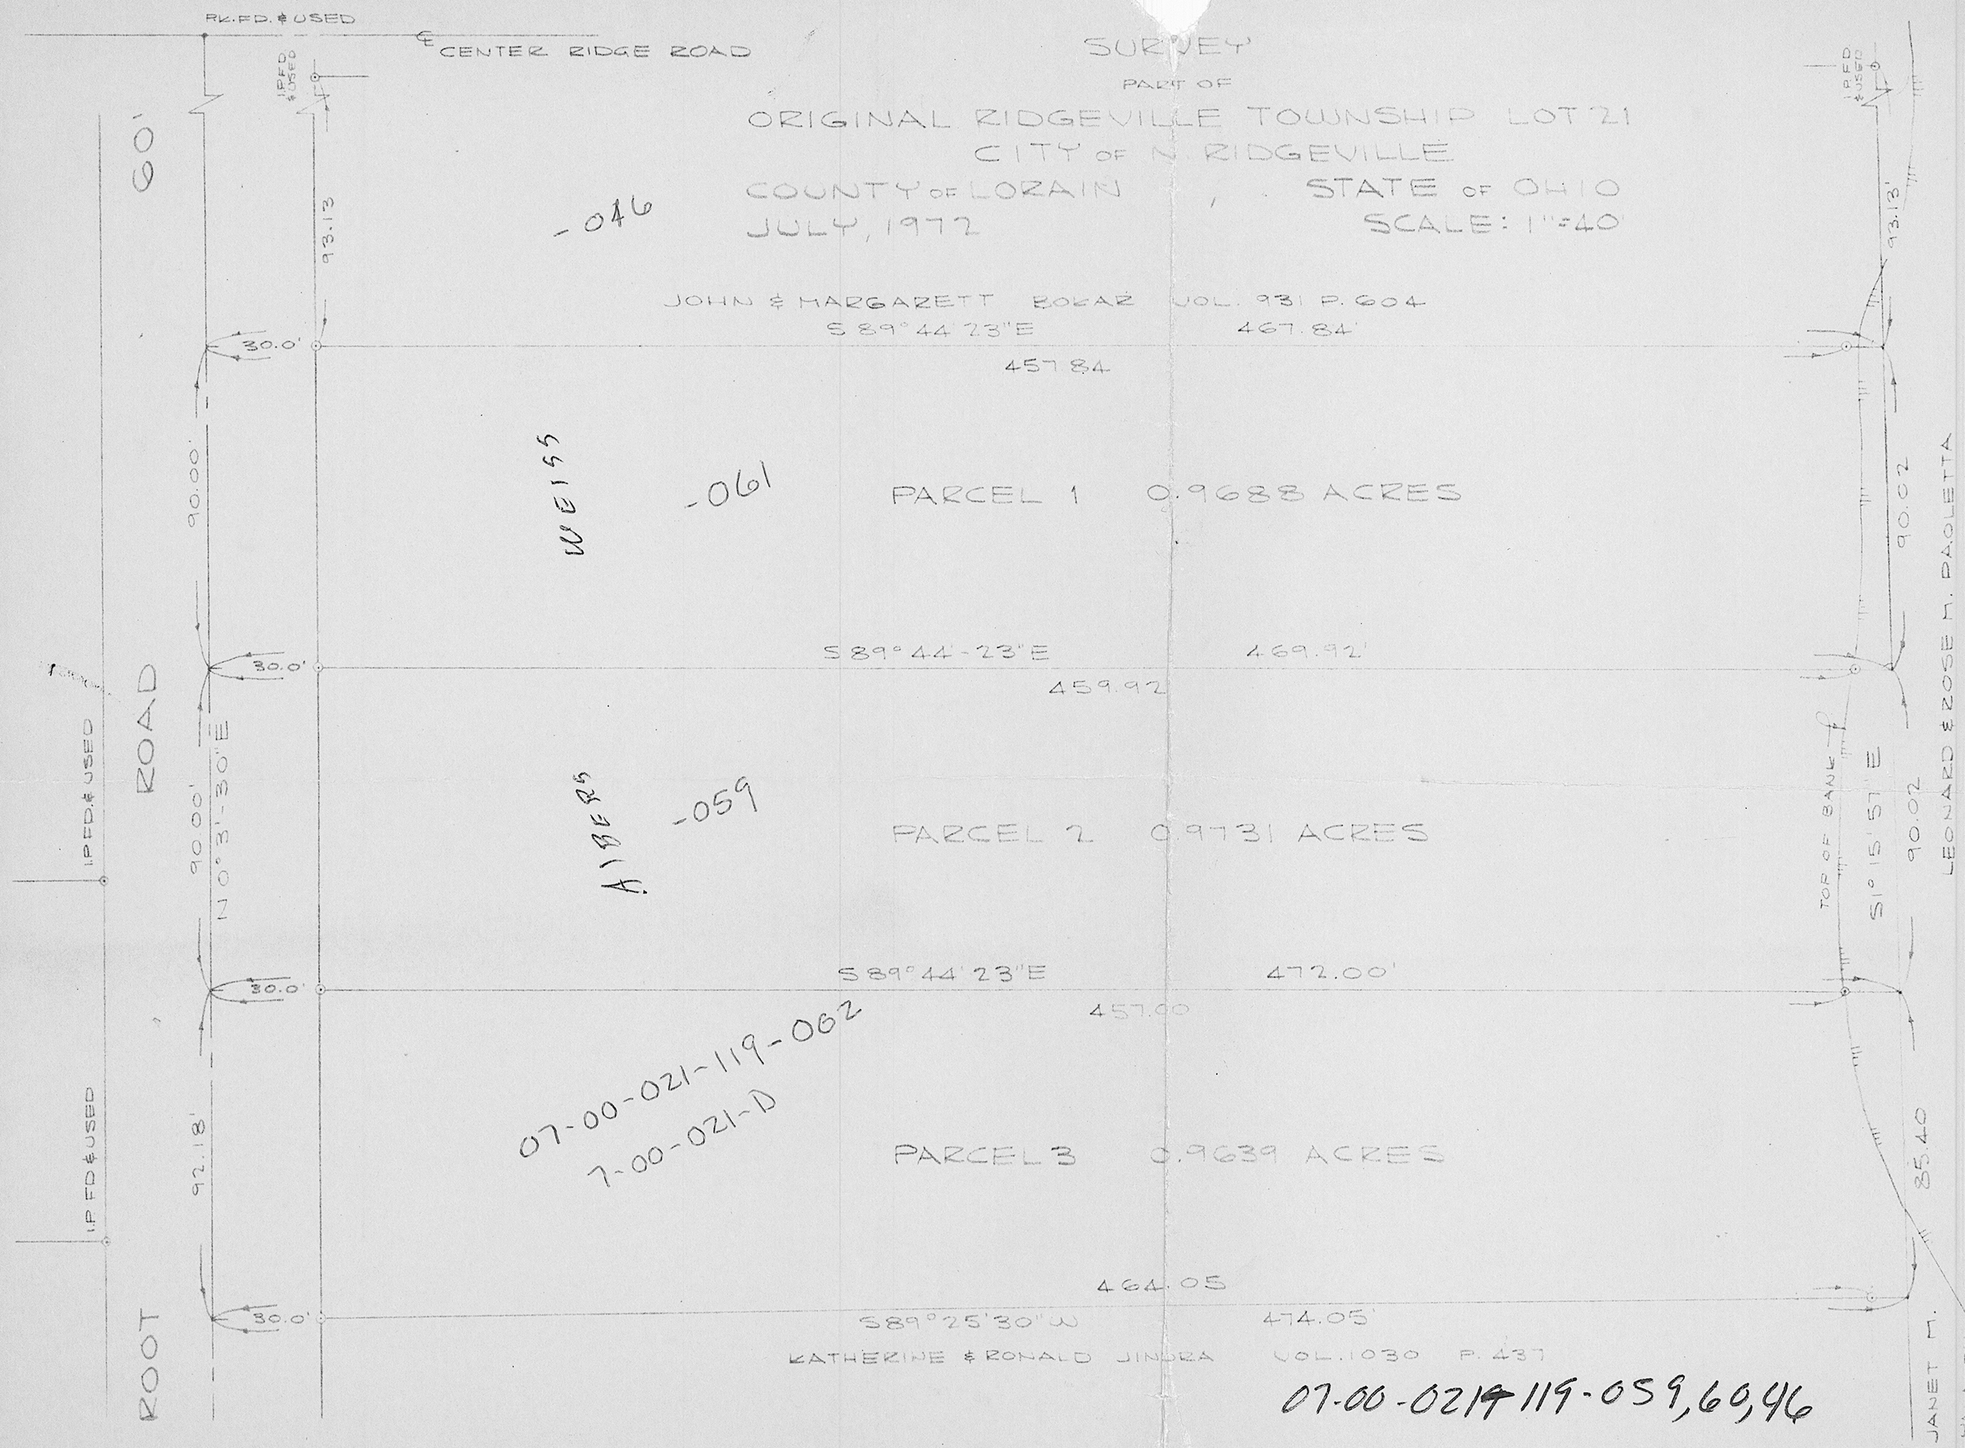

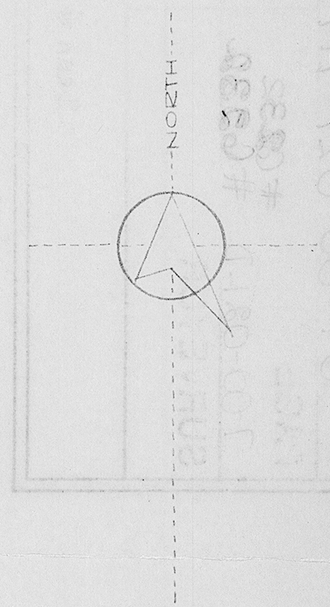

PREPARED BY
J.R. FOOR & ASSOC.
REGISTERED SURVEYORS
N. RIDGEVILLE, OHIO

PREPARED FOR
PAUL SCHUENEMANN
WESTLAKE, OHIO

STATE OF OHIO
JAMES R. FOOR
S 5818
REGISTERED
SURVEYOR

7-00-021

7L-26