P.P. NO. 07-00-018-102-023	
SPLIT #	DATE OF SURVEY
MAP PAGE 07-00-018-B	
SURVEYOR Dane A. Haponek	

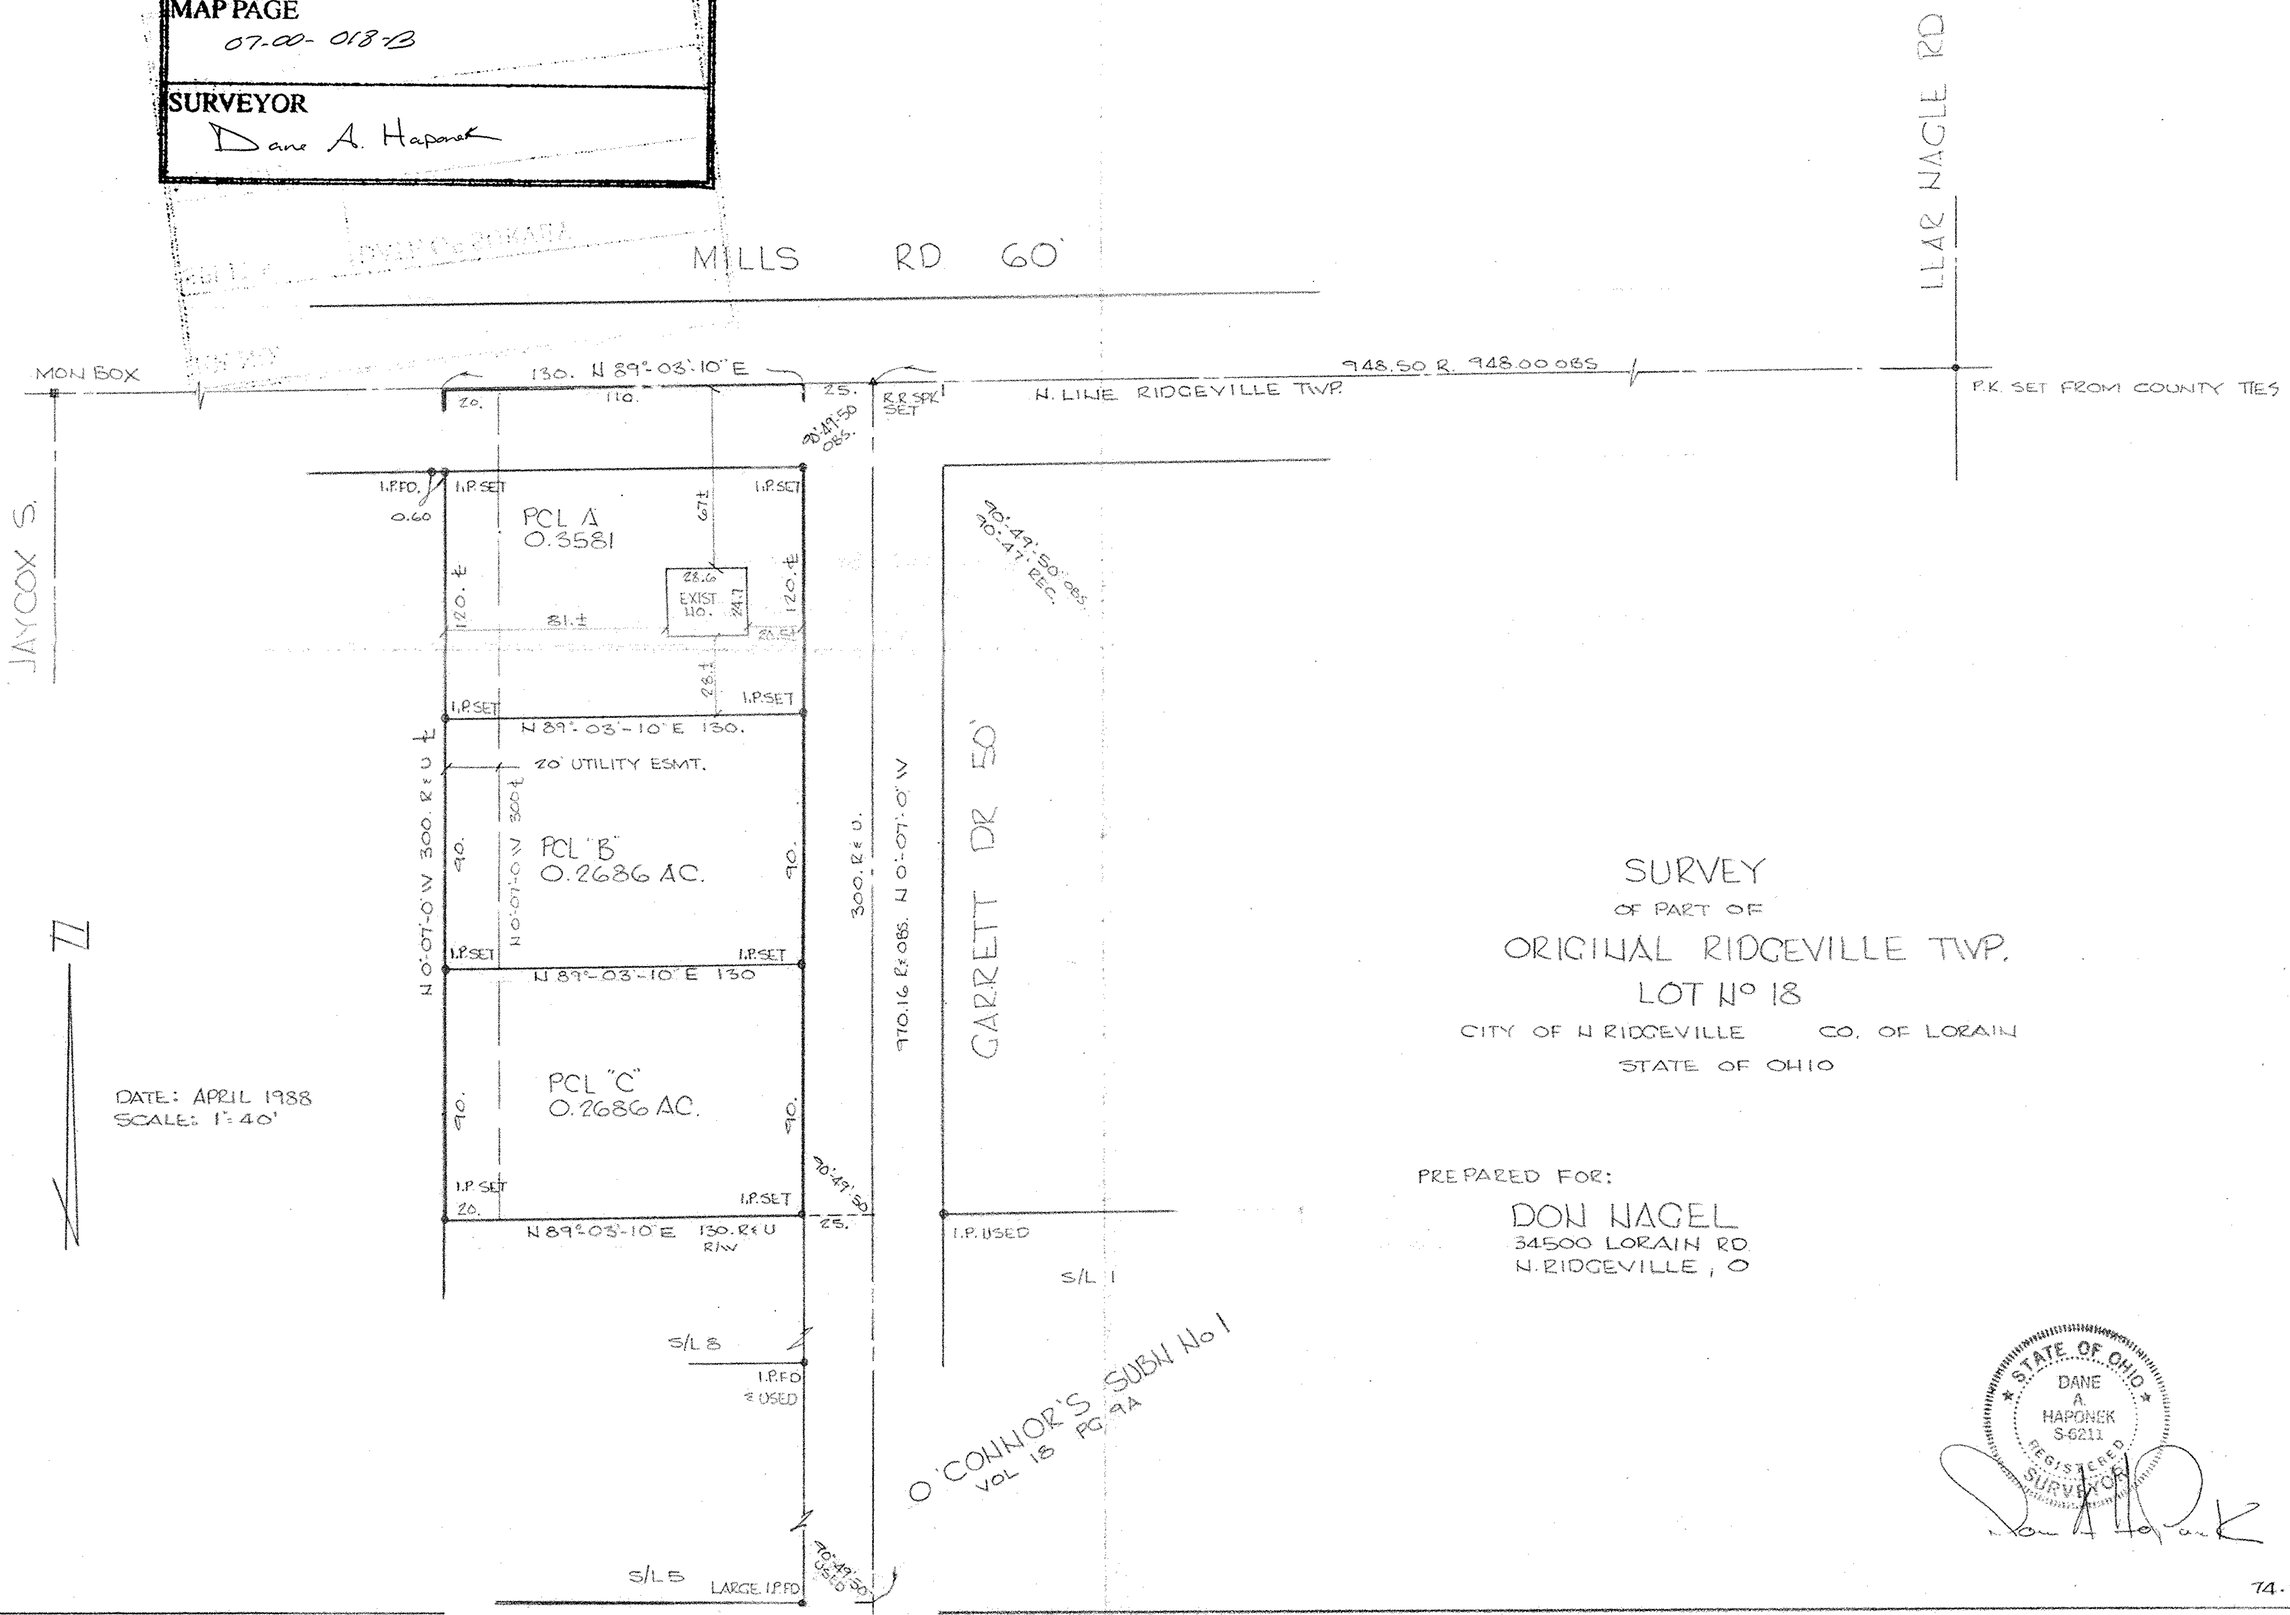

SURVEY
OF PART OF
ORIGINAL RIDGEVILLE TWP.
LOT No 18
CITY OF N RIDGEVILLE CO. OF LORAIN
STATE OF OHIO

PREPARED FOR:
DON NAGEL
34500 LORAIN RD
N. RIDGEVILLE, O

STATE OF OHIO
DANE A. HAPONEK
S-6211
REGISTERED SURVEYOR

Dane A. Haponek

74-77