P.P. NO. 07-00-018-101- 301, 302, 303, 317, & 318	
SPLIT # 22382	DATE OF SURVEY Sept 1996
MAP PAGE 07-00-018-C	
SURVEYOR Dave A. Haponek SURVEY	

ALL OF S/L 20, WEST ½ S/L 19
AND
ALL OF S/L 18, EAST ½ S/L 19
IN
HEATHERWOOD ESTATES
PLAT VOL 55 PGS 29-30
CITY OF N RIDGEVILLE CO. OF LORAIN
STATE OF OHIO

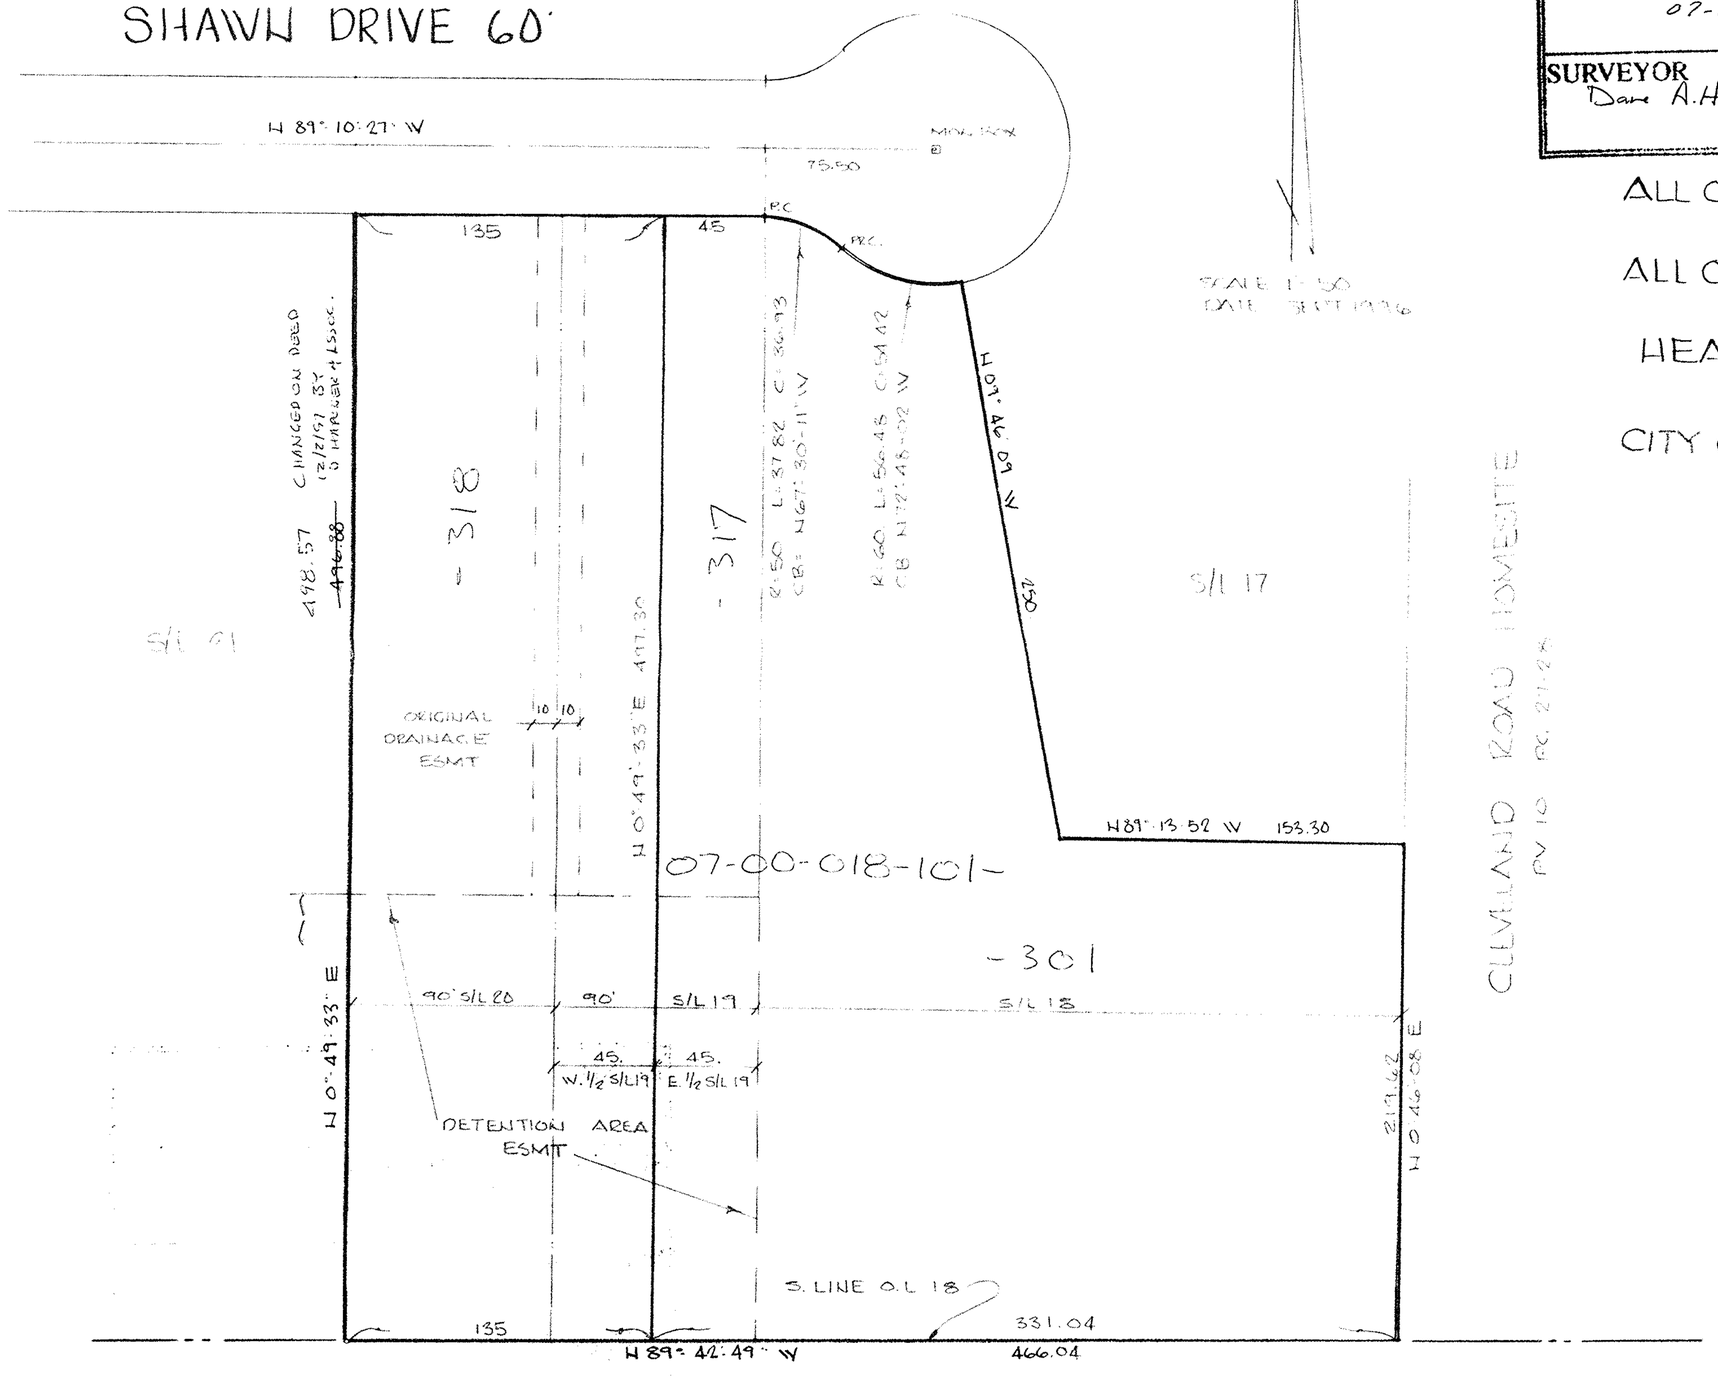

PREPARED FOR:
KIMBLE CONST.
N RIDGEVILLE, OH

PREPARED BY:
HAPONEK & ASSOC.
SURVEYORS
N RIDGEVILLE, OH.

STATE OF OHIO
DAVE A. HAPONEK
6021
REGISTERED SURVEYOR

#22382
APPROVED
LORAIN CO.
MAP DEPT
DATE 12/10/97
PAGE 7-00-018-C
BY K. Colbert