APONEK & ASSOCIATES, INC. Engineers & Surveyors
34100 Center Ridge Road North Ridgeville, Ohio 44039 (440) 327-4776

07-00-014-103-259, 260
01-00503-A
07-00-014-C

REPLATTING OF SUBLOT 11 IN DEERFIELD MEADOWS 2

CITY OF NORTH RIDGEVILLE COUNTY OF LORAIN
STATE OF OHIO

DATE: NOV., 2000
SCALE: 1"=40'

PREPARED FOR:
RYAN HOMES

STATE OF OHIO
CANE
A.
HAPONEK
6611
REGISTERED
SURVEYOR

SEC-
6S/31 & 32

07-00-014-103-260
259

#00503-A

APPROVED
LORAIN CO.
MAP DEPT.
DATE 1-24-01
PARCEL 7-00-014-C
BY R. Maines
VOID
LETTER 01-00503-A

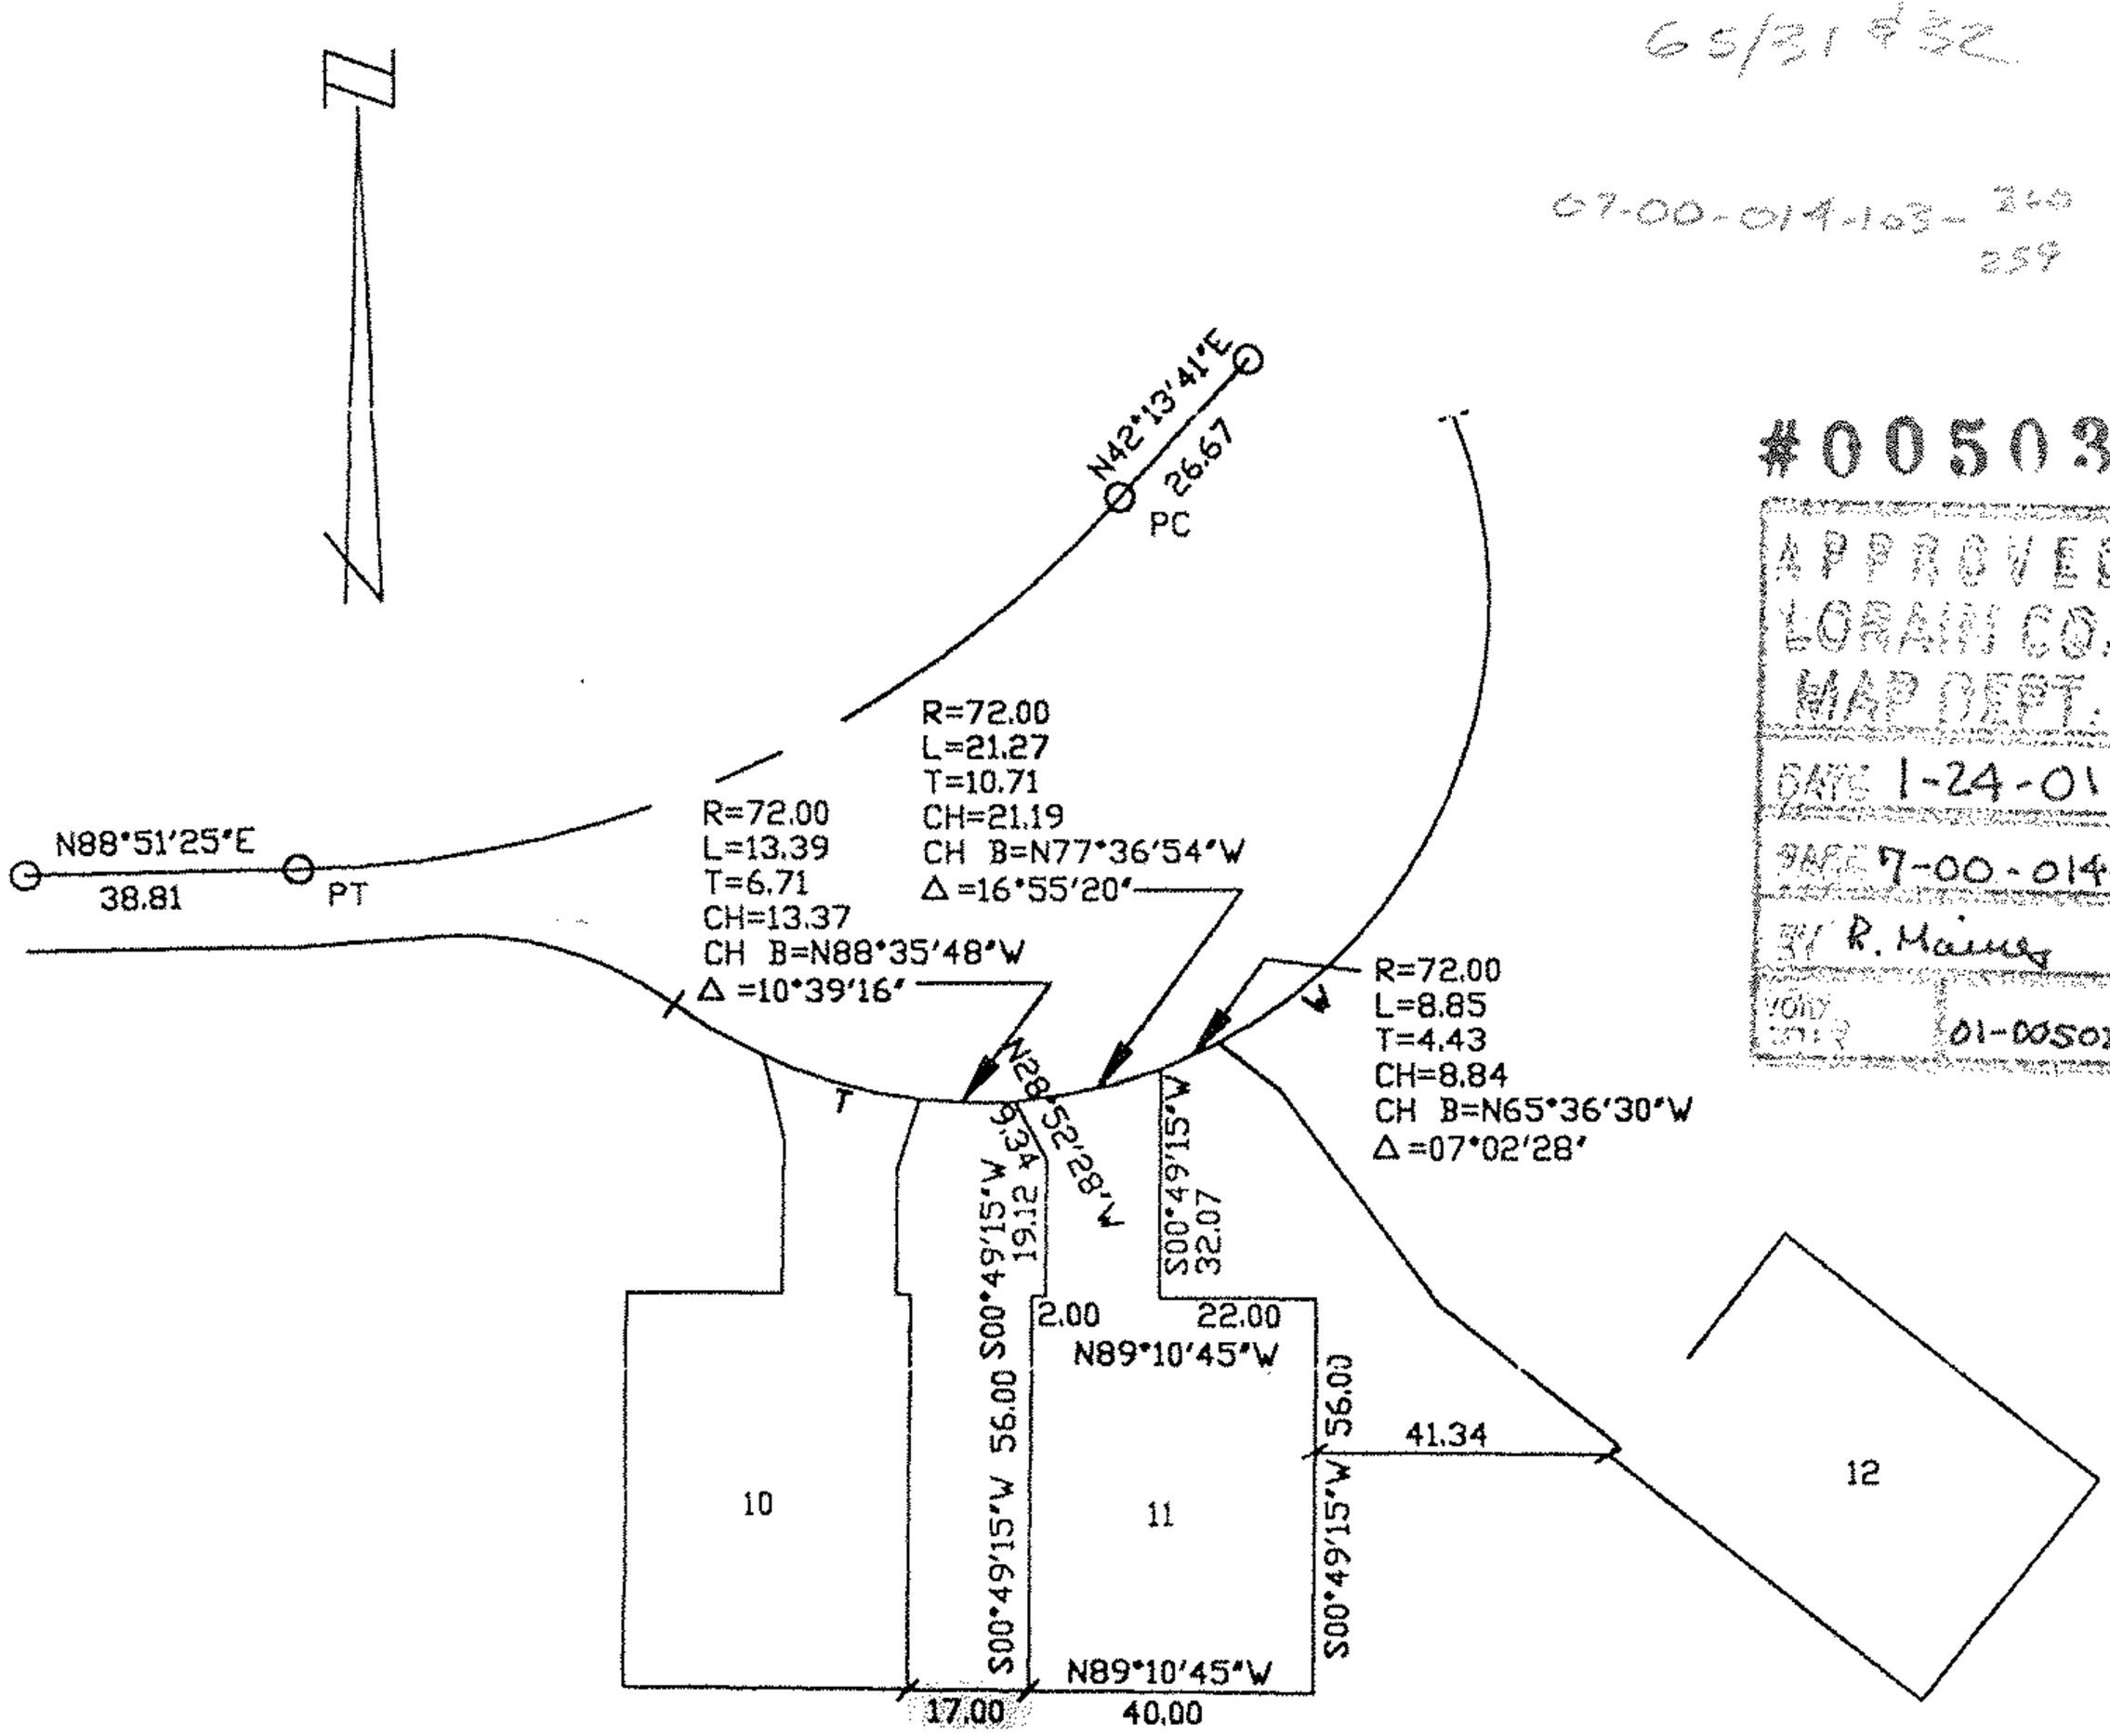

* THE HIGHLIGHTED PLAT REVISION ON THIS DRAWING MEETS THE NORTH RIDGEVILLE ZONING CODE. PLANNING COMMISSION HAS BEEN NOTIFIED AND DID NOT HAVE A PROBLEM WITH THIS REVISION.

GUY M. FURSDON C.B.O.
Guy M. Fursdon C.B.O.
1-5-01