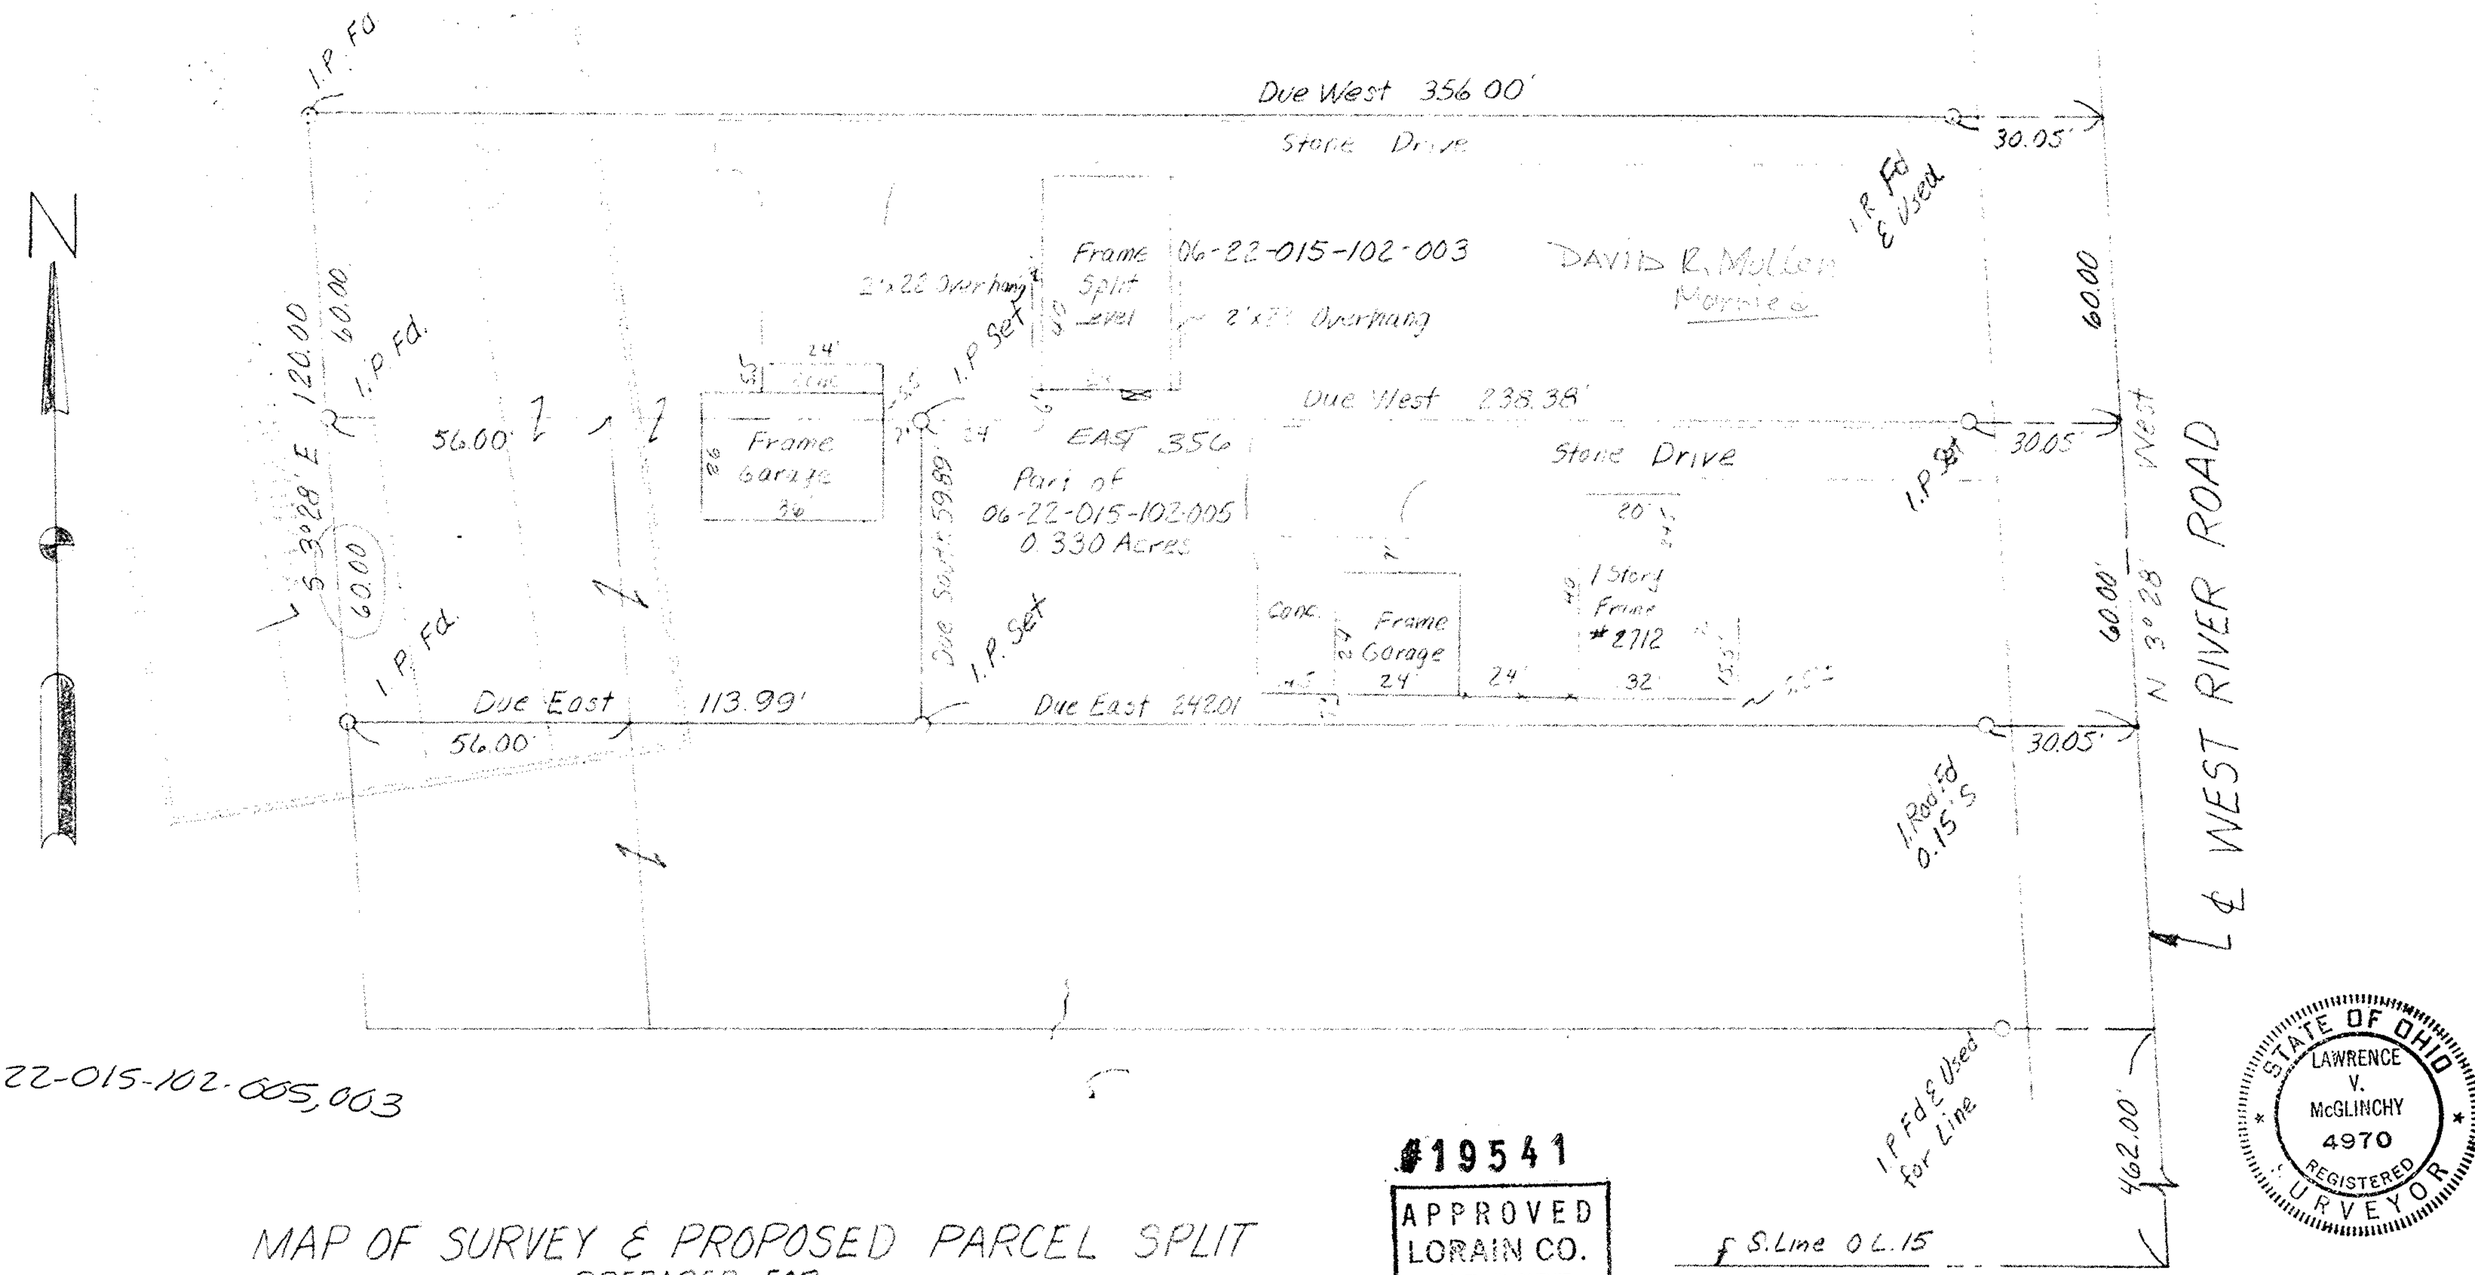

06-22-015-102-005,003

MAP OF SURVEY & PROPOSED PARCEL SPLIT

PREPARED FOR

DAVID R. MULLEN

PART OF ORIGINAL ELYRIA TOWNSHIP LOT NO. 15, BURRELL & DAY TRACT, NOW IN CITY OF ELYRIA, LORAIN COUNTY, OHIO

#19541

APPROVED
LORAIN CO.
MAP DEPT.
DATE 10-3-91
PAGE 6-10
BY T. McMain
VOID, 19541

STATE OF OHIO
LAWRENCE V. McGLINCHY
4970
REGISTERED SURVEYOR

McGLINCHY AND ASSOCIATES
PROFESSIONAL ENGINEERS AND SURVEYORS
625 North Woodhill Drive Amherst, Ohio

SCALE: 1" = 30' DRAWN BY: L.V. McGlinchy
DATE: 4/13/91 JOB NO: 918813
Rev. 6/30/91