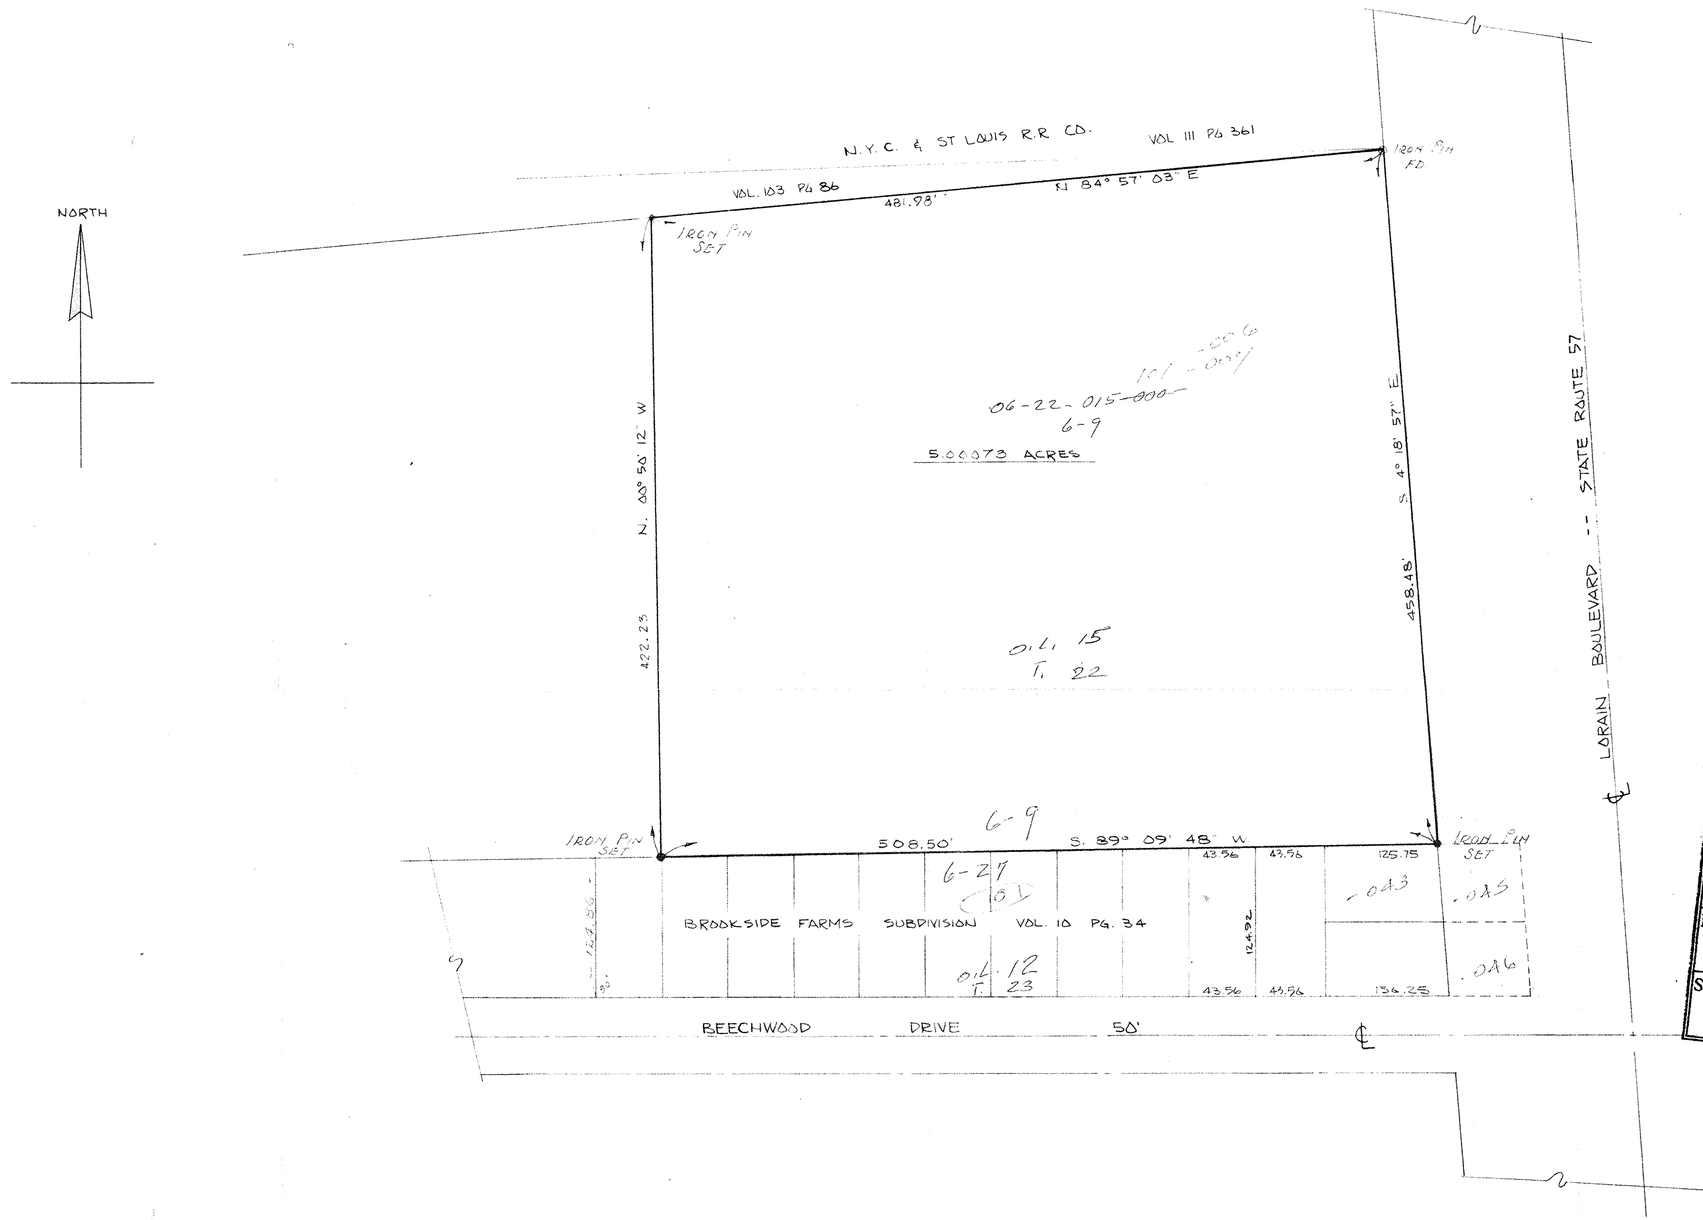

P.P. NO.	
06-22-015-101-006, 007 012-101-043, 045, 046	
SPLIT #	DATE OF SURVEY
MAP PAGE 6-9	
SURVEYOR John Meno	

STATE OF OHIO JOHN L. MENO 3662 REGISTERED SURVEYOR

REFERENCE: RAY HOLLIS FIELD BOOK 103 PGS 52, 53, 54, 56
RAY HOLLIS DRAWING, FILE NO. 6-BURRELLDAY-15, 16

REVISED 3-8-73

MILAN INDUSTRIES INC.
N. MAIN STREET
MILAN, OHIO

SCHAFER, HURA & ASSOCIATES, INC.
ENGINEERS AND SURVEYORS
4370 OBERLIN AVE.
LORAIN, OHIO

SURVEY

ORIGINAL LOT 15, BURRELL DAY TR	DATE 12-4-72
TOWNSHIP ELYRIA	SCALE 1" = 50
CITY OF ELYRIA	FIELD BOOK 219, PGS 90, 91
COUNTY OF LORAIN	DRAWN BY JFR
STATE OF OHIO	CHECKED BY JM
W. O. 1879	FILE NO. 6-BURRELLDAY-15