06-22-018-119-001,023

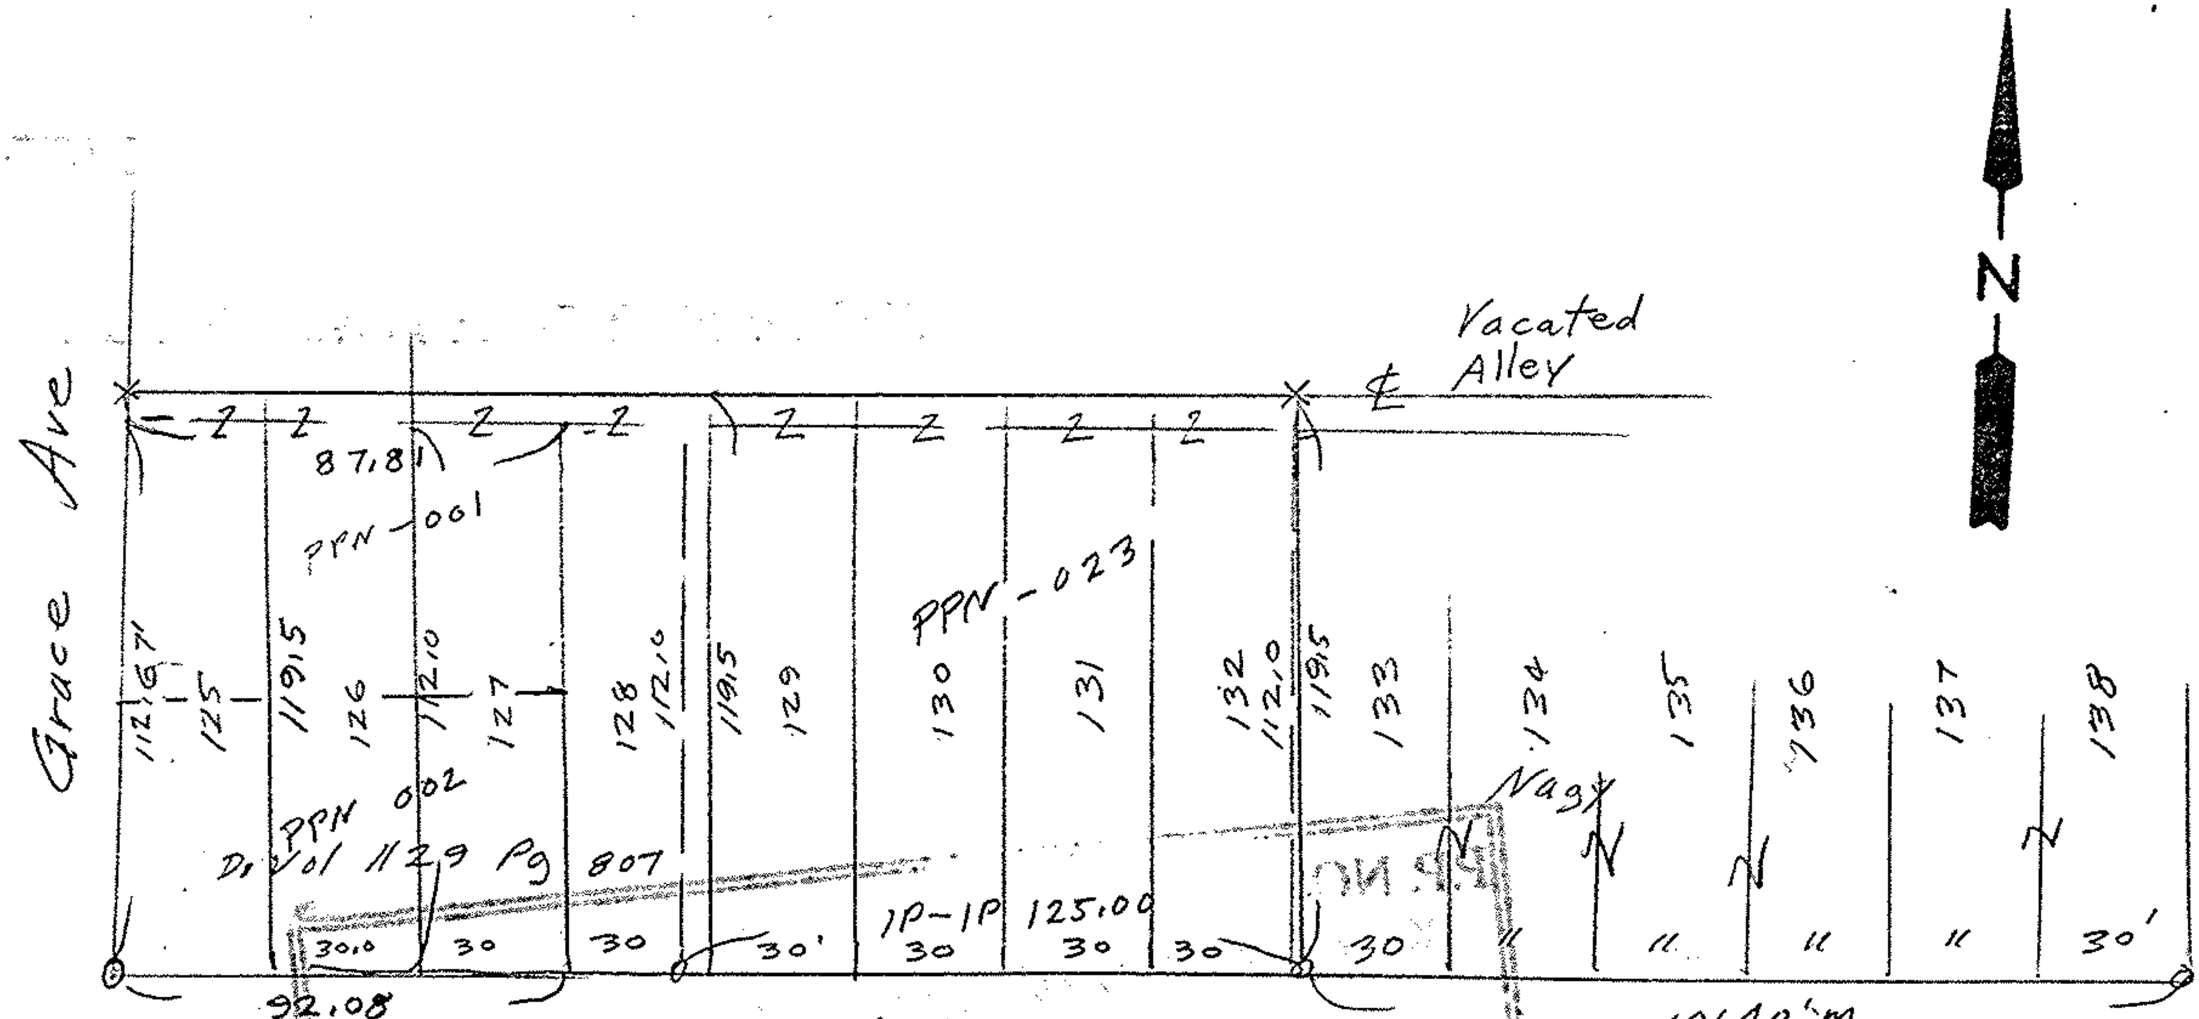

o iron pipes fd

X pk nails set in Blacktop

John Pozywak
Reg Surveyor
5292

Survey for
Irene Hampton
sublots 125-132
Clearview Subdivision
P. Vol 10 Pg 8
Original 18
Burrell and Day Tract
Elyria Township
Lorain County Ohio
Scale 1" = 50 May 21, 1995