6-24-011
6-24-012

DEC 24 1974
DEC 1 1975

TOTAL AREA	20.31144 ACRES
TAKE AREA	- 12.71848 ACRES
REMAINDER	- 07.59318 ACRES

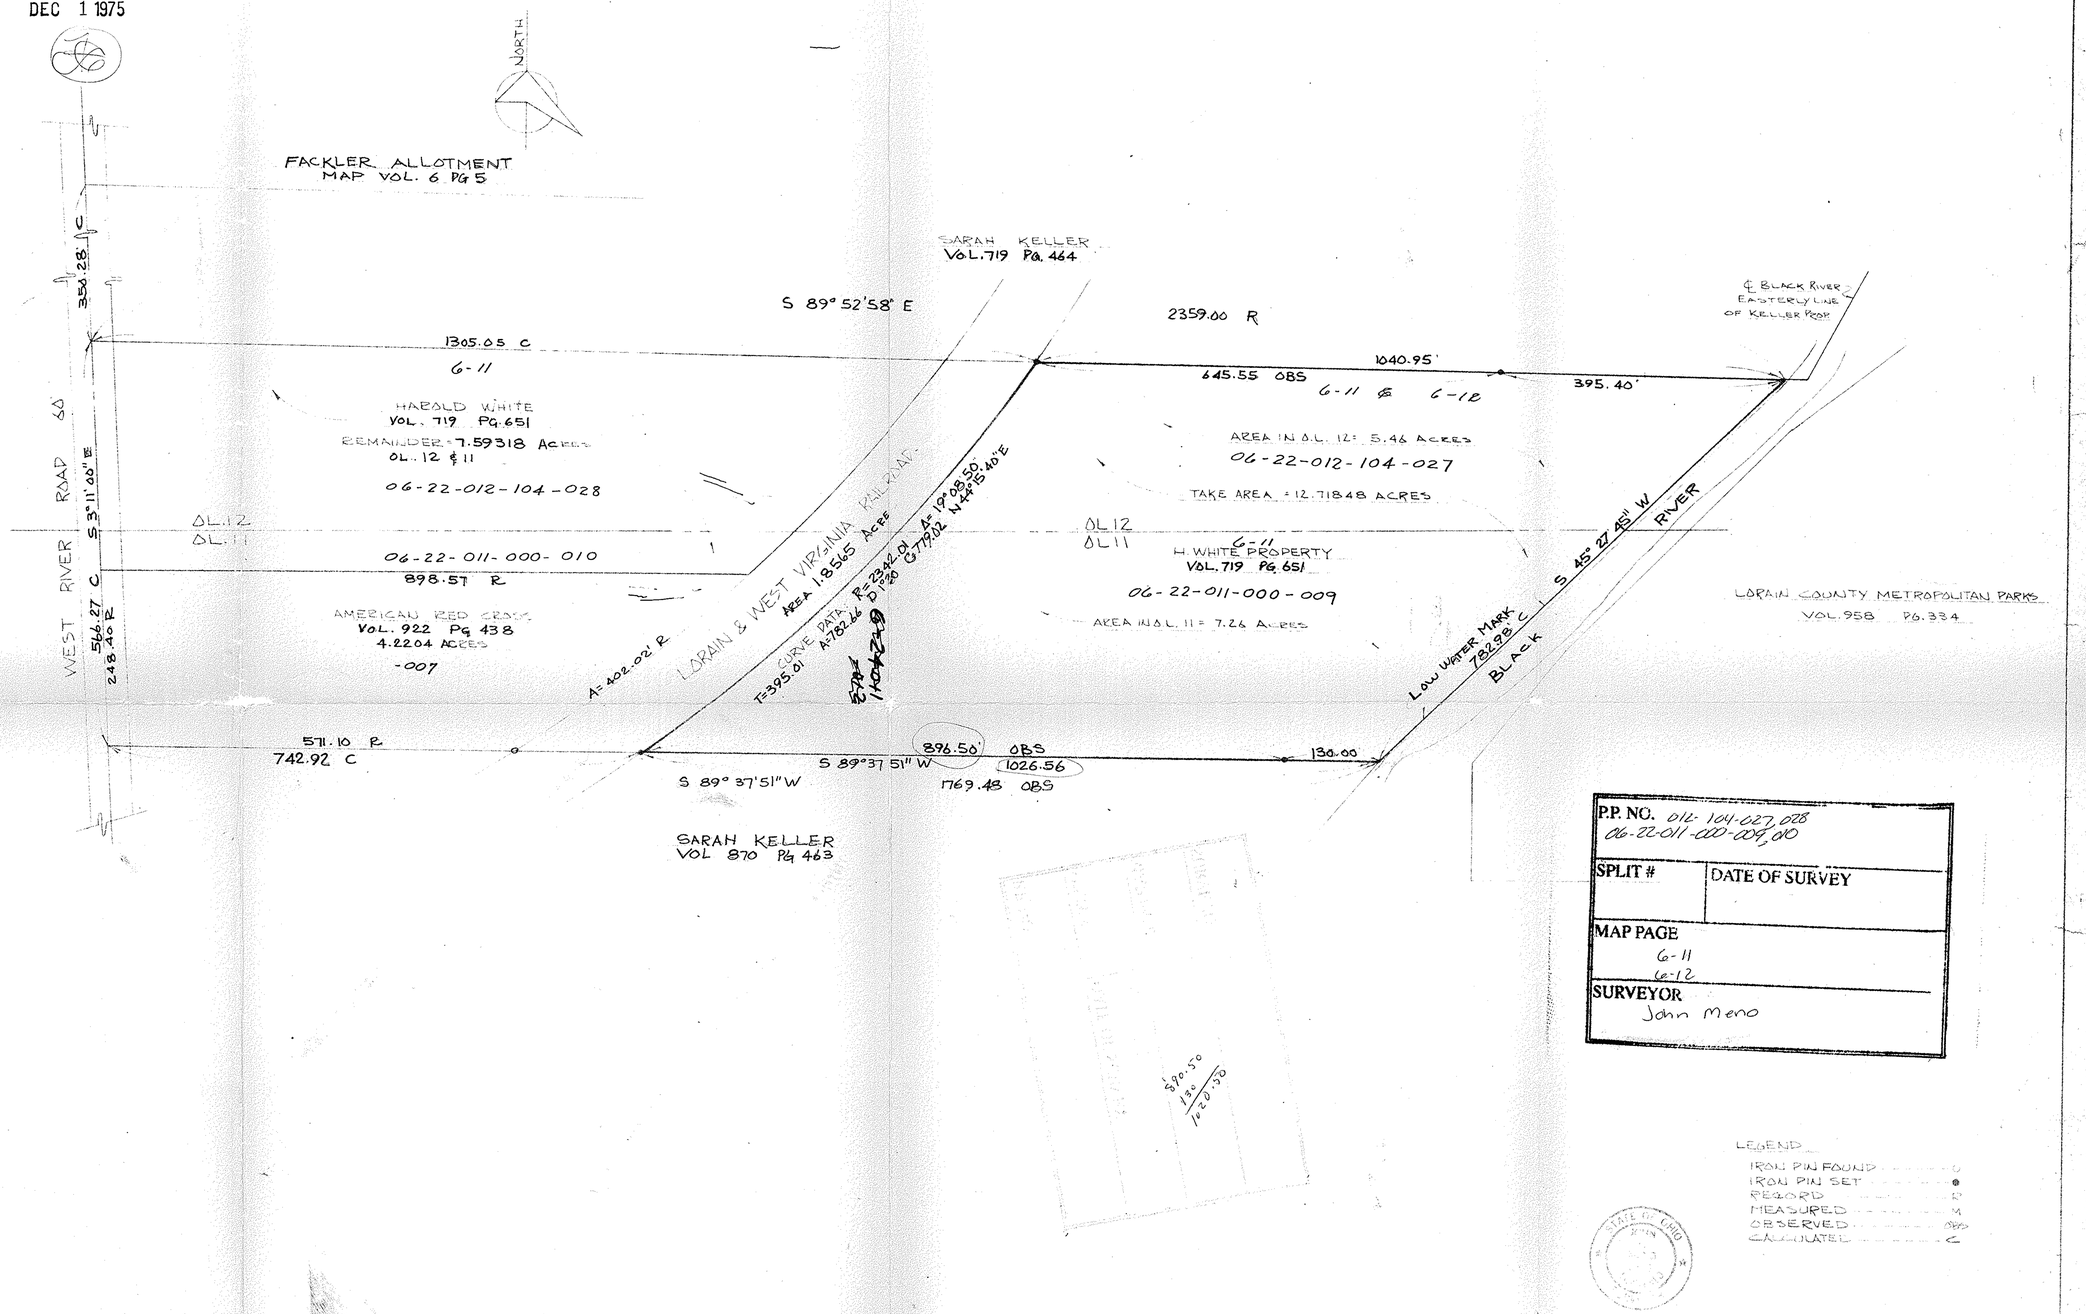

P.P. NO.	012-104-027, 028 06-22-011-000-009, 010
SPLIT #	DATE OF SURVEY
MAP PAGE	6-11 6-12
SURVEYOR	John Meno

LEGEND
IRON PIN FOUND ..... O
IRON PIN SET ..... ●
RECORD ..... R
MEASURED ..... M
OBSERVED ..... OBS
CALCULATED C

LORAN COUNTY METROPOLITAN PARK DISTRICT
LAND ACQUISITION SURVEY
HAROLD WHITE PROPERTY
ELYRIA TOWNSHIP

SCHAFER, HURA & ASSOCIATES, INC.
ENGINEERS AND SURVEYORS
4370 OBERLIN AVE.
LORAIN, OHIO

NBR
22

REVISED 5-23-78 JR

ORIGINAL LOT	11 & 2	DATE	1-18-72
TOWNSHIP	ELYRIA	SCALE	1" = 100'
CITY OF		FIELD BOOK	19 PG 121
COUNTY OF	LORAIN	DRAWN BY	TCR
STATE OF	OHIO	CHECKED BY	J.L.M.
W. O.	16962-14	FILE NO.	5-FICKELL Pay (1812)