BOUNDARY SURVEY OF PART OF

ELYRIA TOWNSHIP ORIGINAL LOT 9 - BURRELL & DAY TR.

CITY OF ELYRIA — COUNTY OF LORAIN — STATE OF OHIO

SCALE : 1" = 30' — MAY 1, 1984

Revised May 9, 1984
Revised July 9, 1984
Revised July 26, 1984

PREPARED BY
KLEINOEDER-SCHMIDT & ASSOC.
CONSULTING ENGINEERS & SURV.

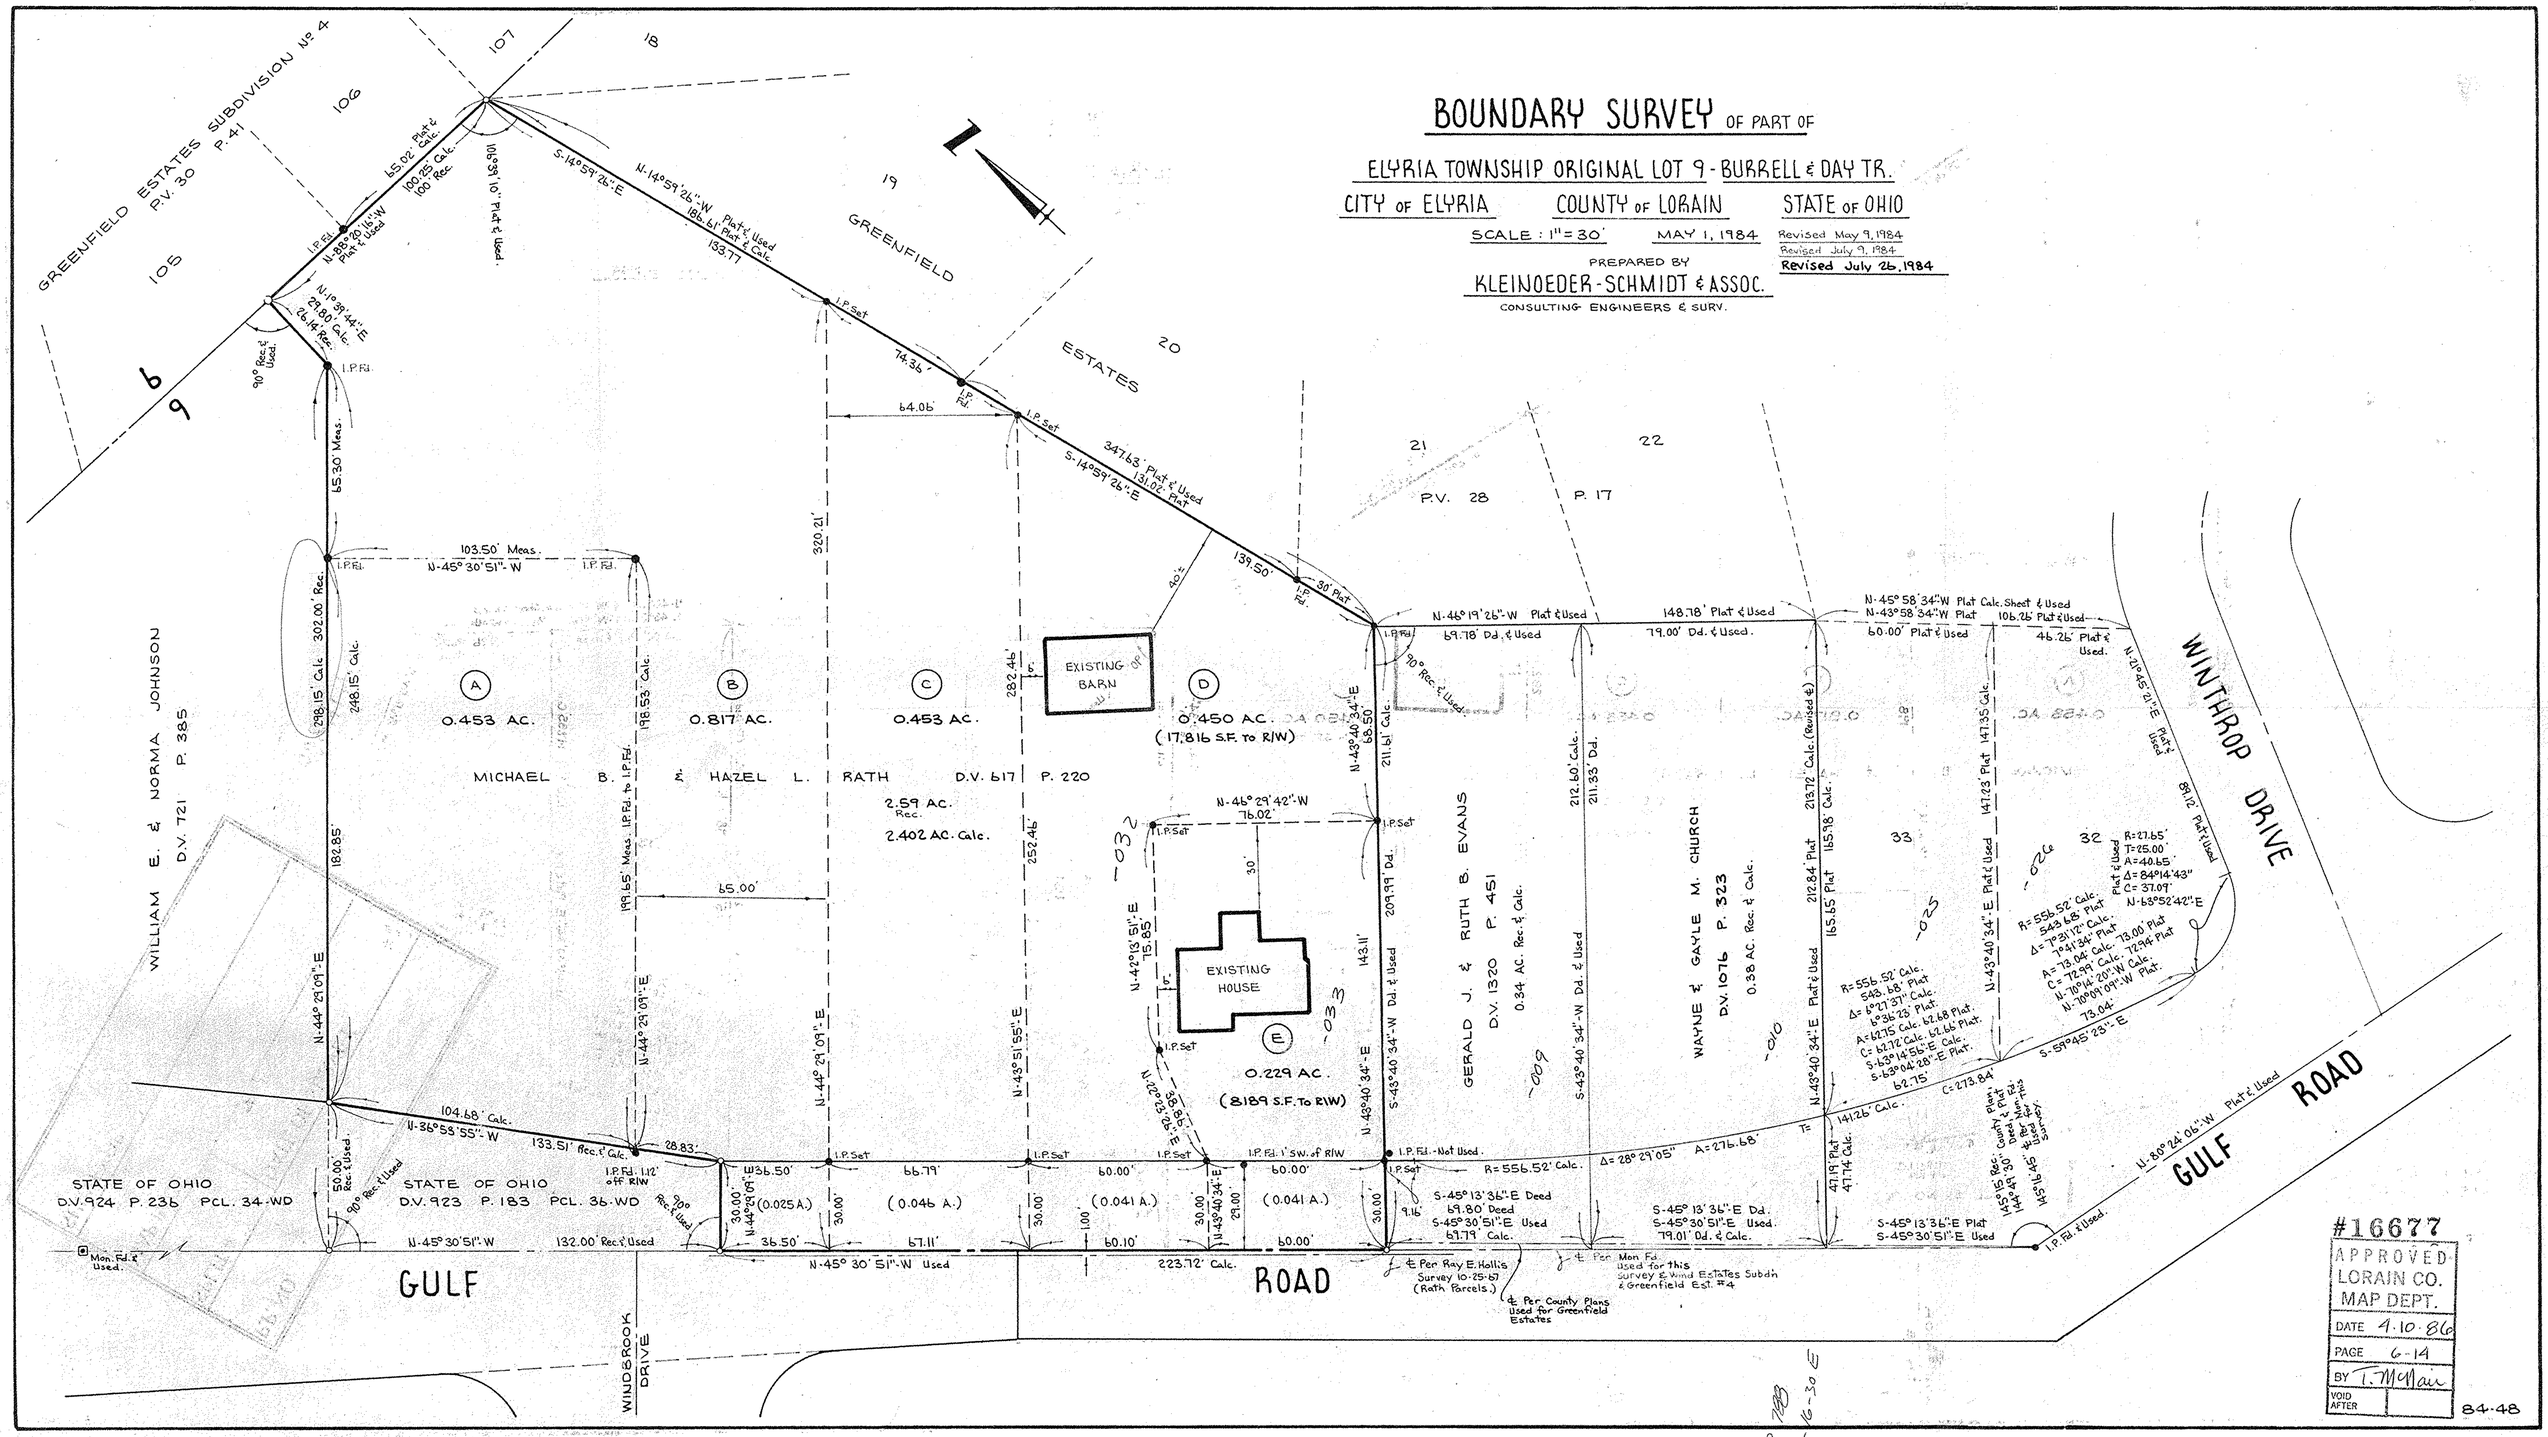

#16677
APPROVED
LORAIN CO.
MAP DEPT.
DATE 4-10-86
PAGE 6-14
BY T. McMan
VOID AFTER

84-48