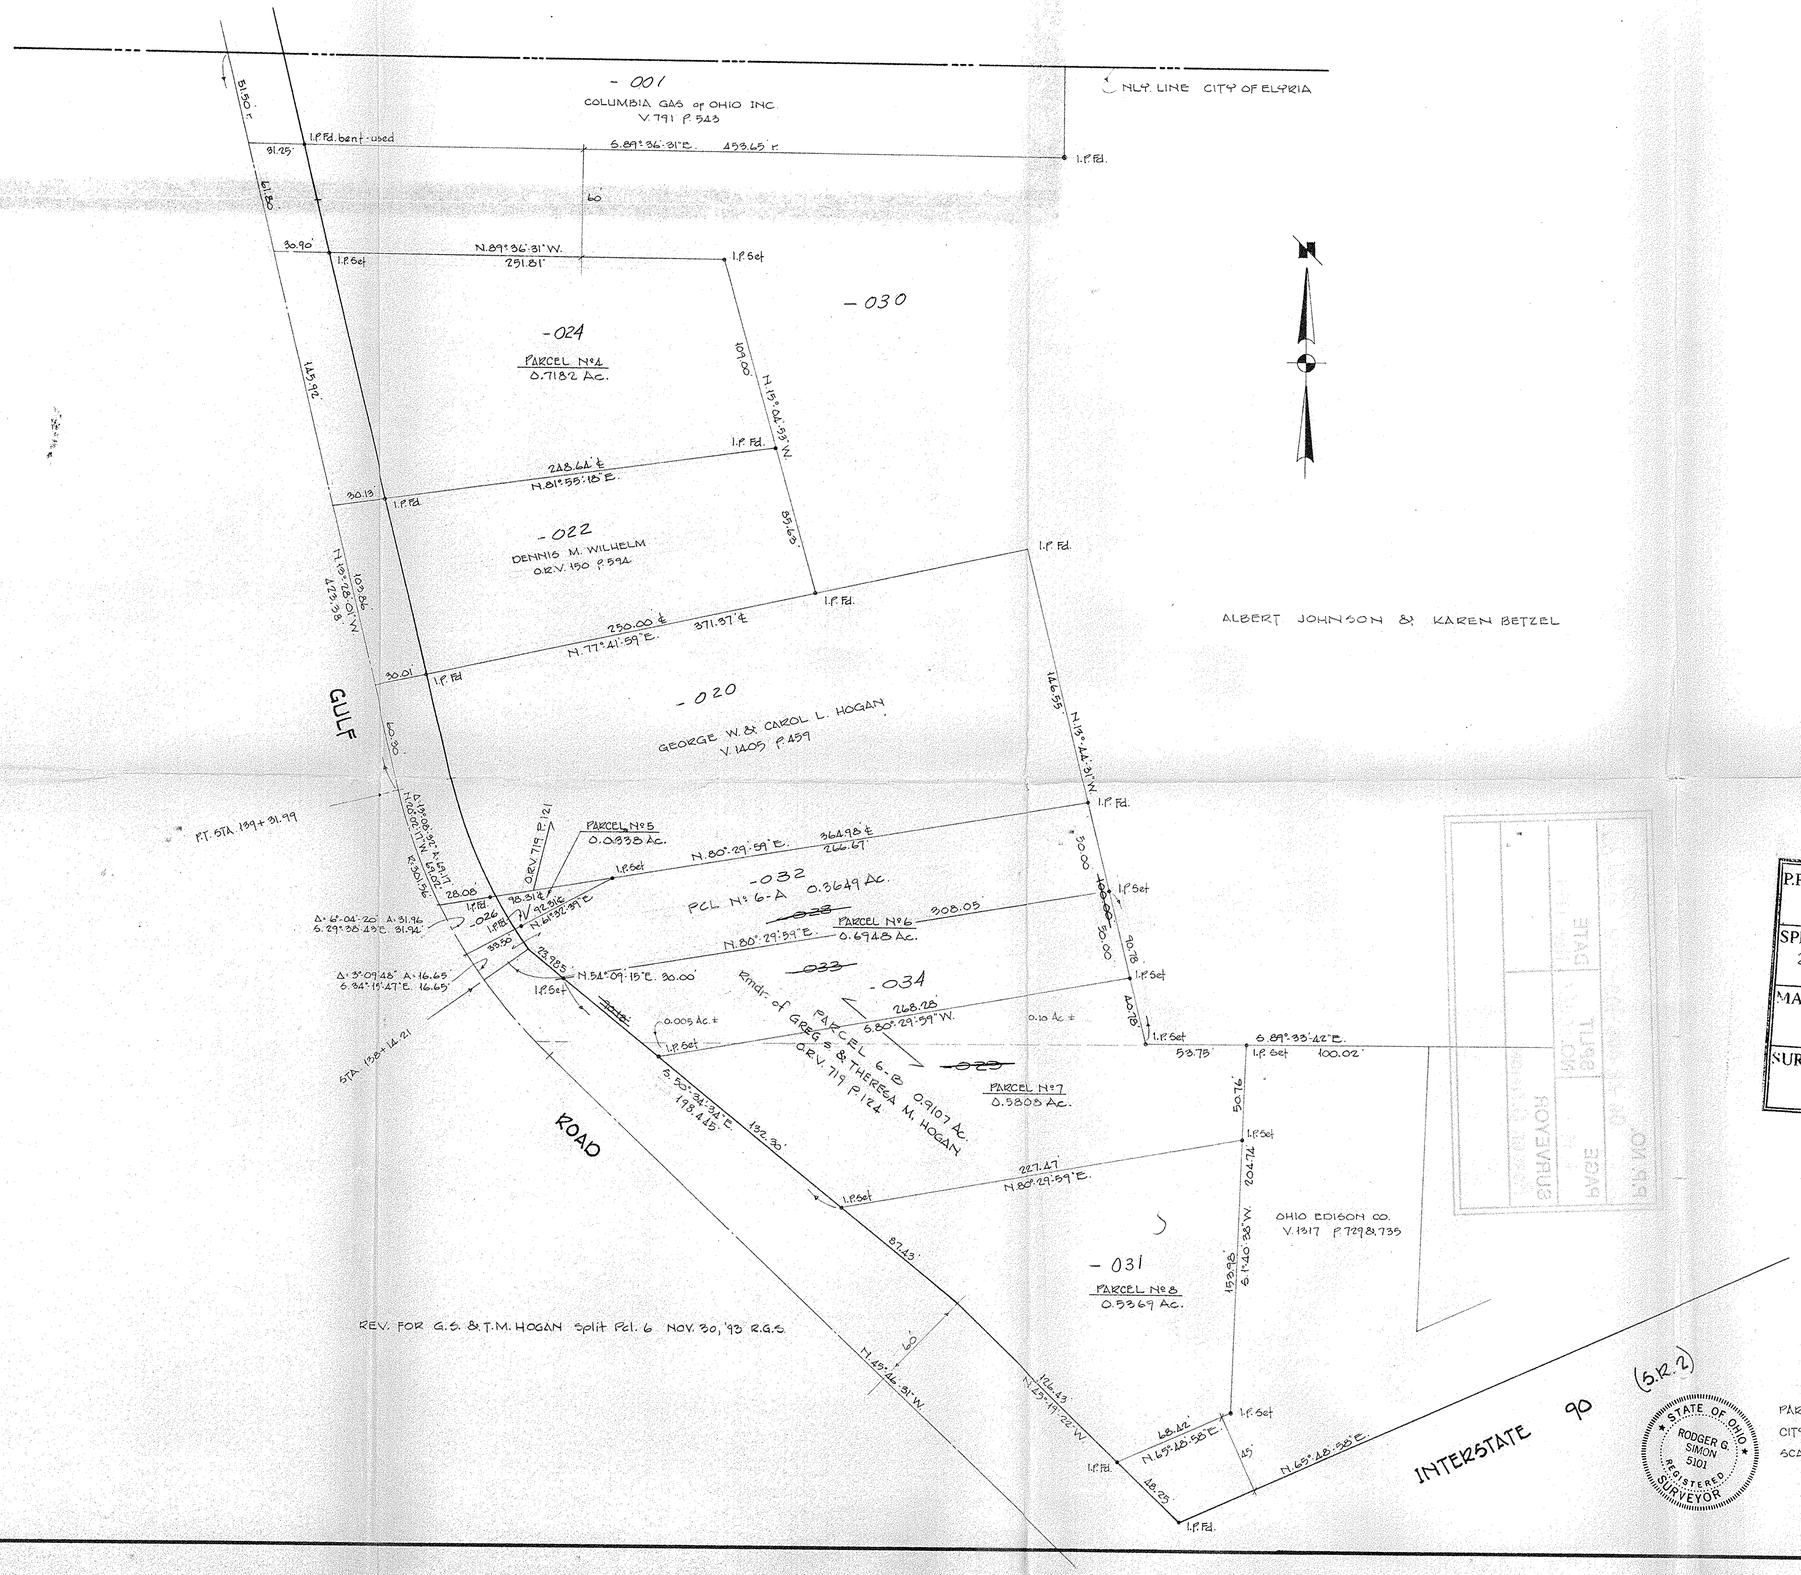

P.P. No. 06-22-006-103-032, 034	
SPLIT # 20685	DATE OF SURVEY Nov. 1993
MAP PAGE 06-014	
SURVEYOR Rodger G. Simon	

06-22-006-103

20685

APPROVED
LORAIN CO.
MAP DEPT.
DATE 1-12-94
PAGE G-14
BY CAROLYN FRANCIS
VOID ~~MASTER~~ # 20685

SURVEY FOR

ALBERT JOHNSON

PART OF O.L. 6 BURRELL & DAY TRACT OF ELYRIA TWP.
CITY OF ELYRIA LORAIN COUNTY OHIO
SCALE 1"=40' APRIL, 1990

LAUNDON · SIMON · CAHL & ASSOC.
ENGINEERS SURVEYORS

(5.R.2)

STATE OF OHIO
RODGER G. SIMON
5101
REGISTERED SURVEYOR

JOB No 90-1926