SURVEY FOR.

JOHN E. & NEALIE G. PORTER

PT. OF O.L.'s 73 & 74 WEST OF BLACK RIVER

TWP. OF ELYRIA – CITY OF ELYRIA - STATE OF OHIO

SCALE 1"=30' NOV. 9, 1983

LAUNDON • SIMON • CAHL & ASSOC.
ENGINEERS SURVEYORS
Job No. 83-1241.

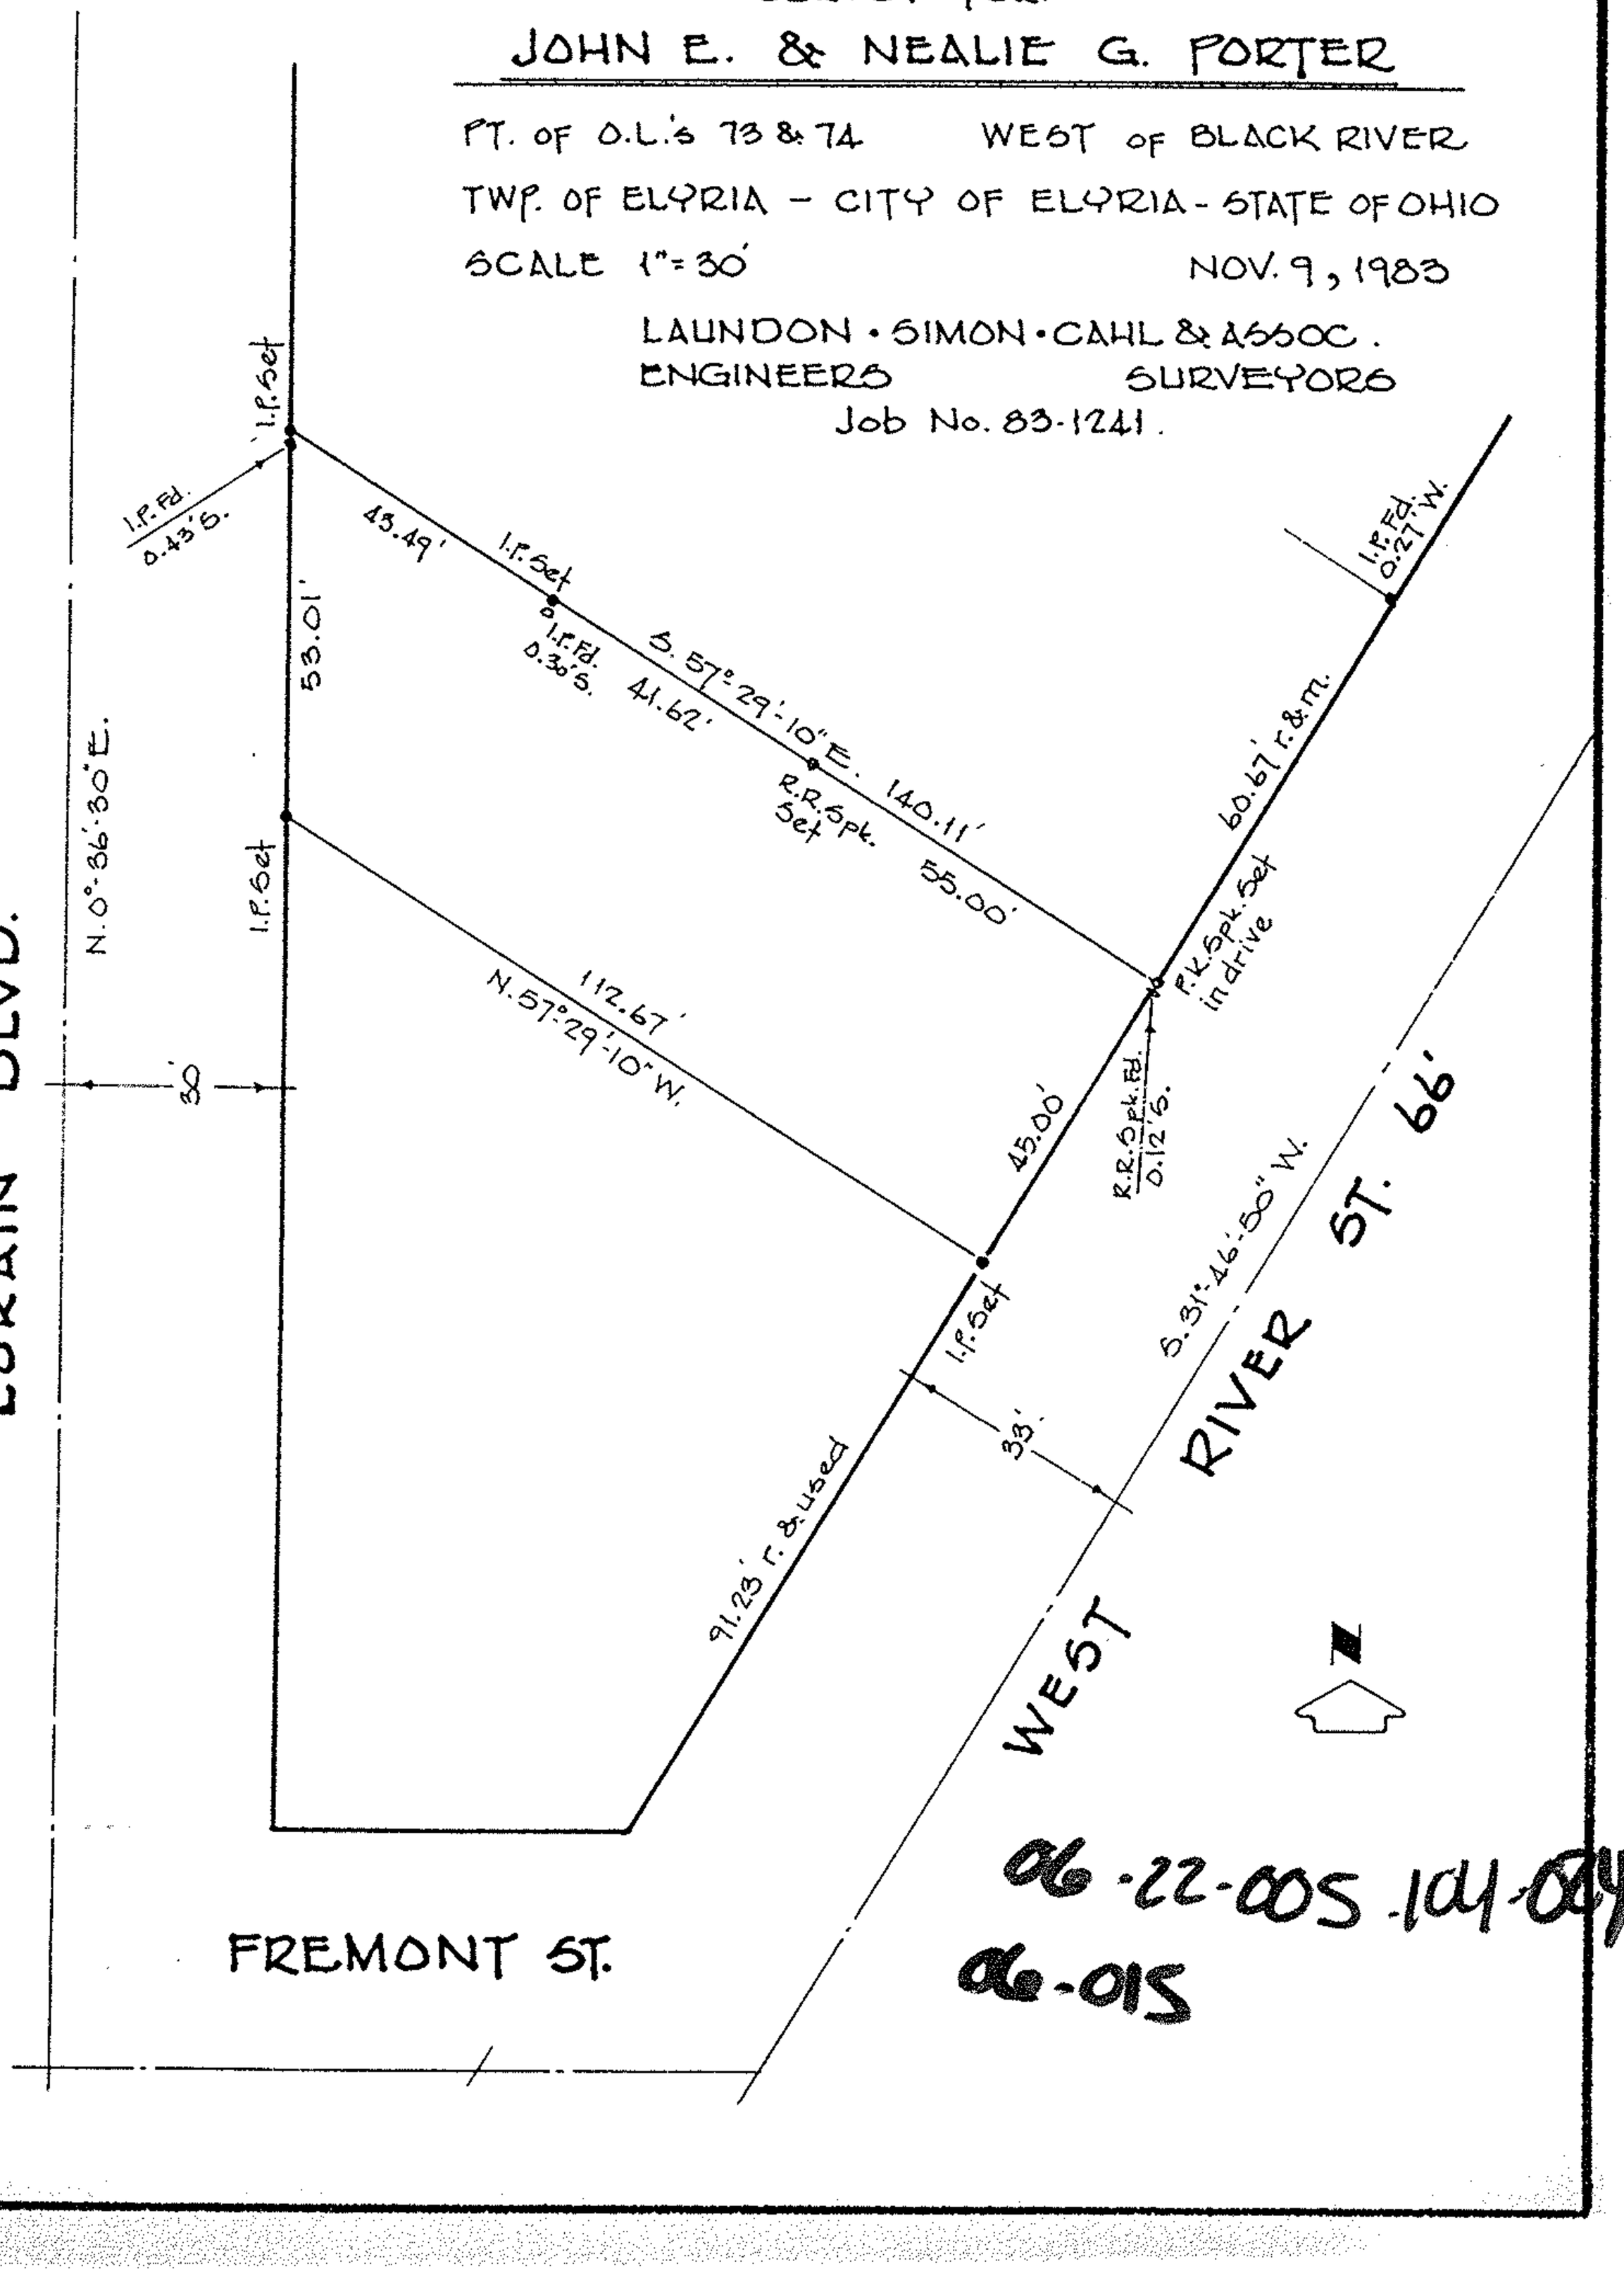

06-22-005-104-04
06-015