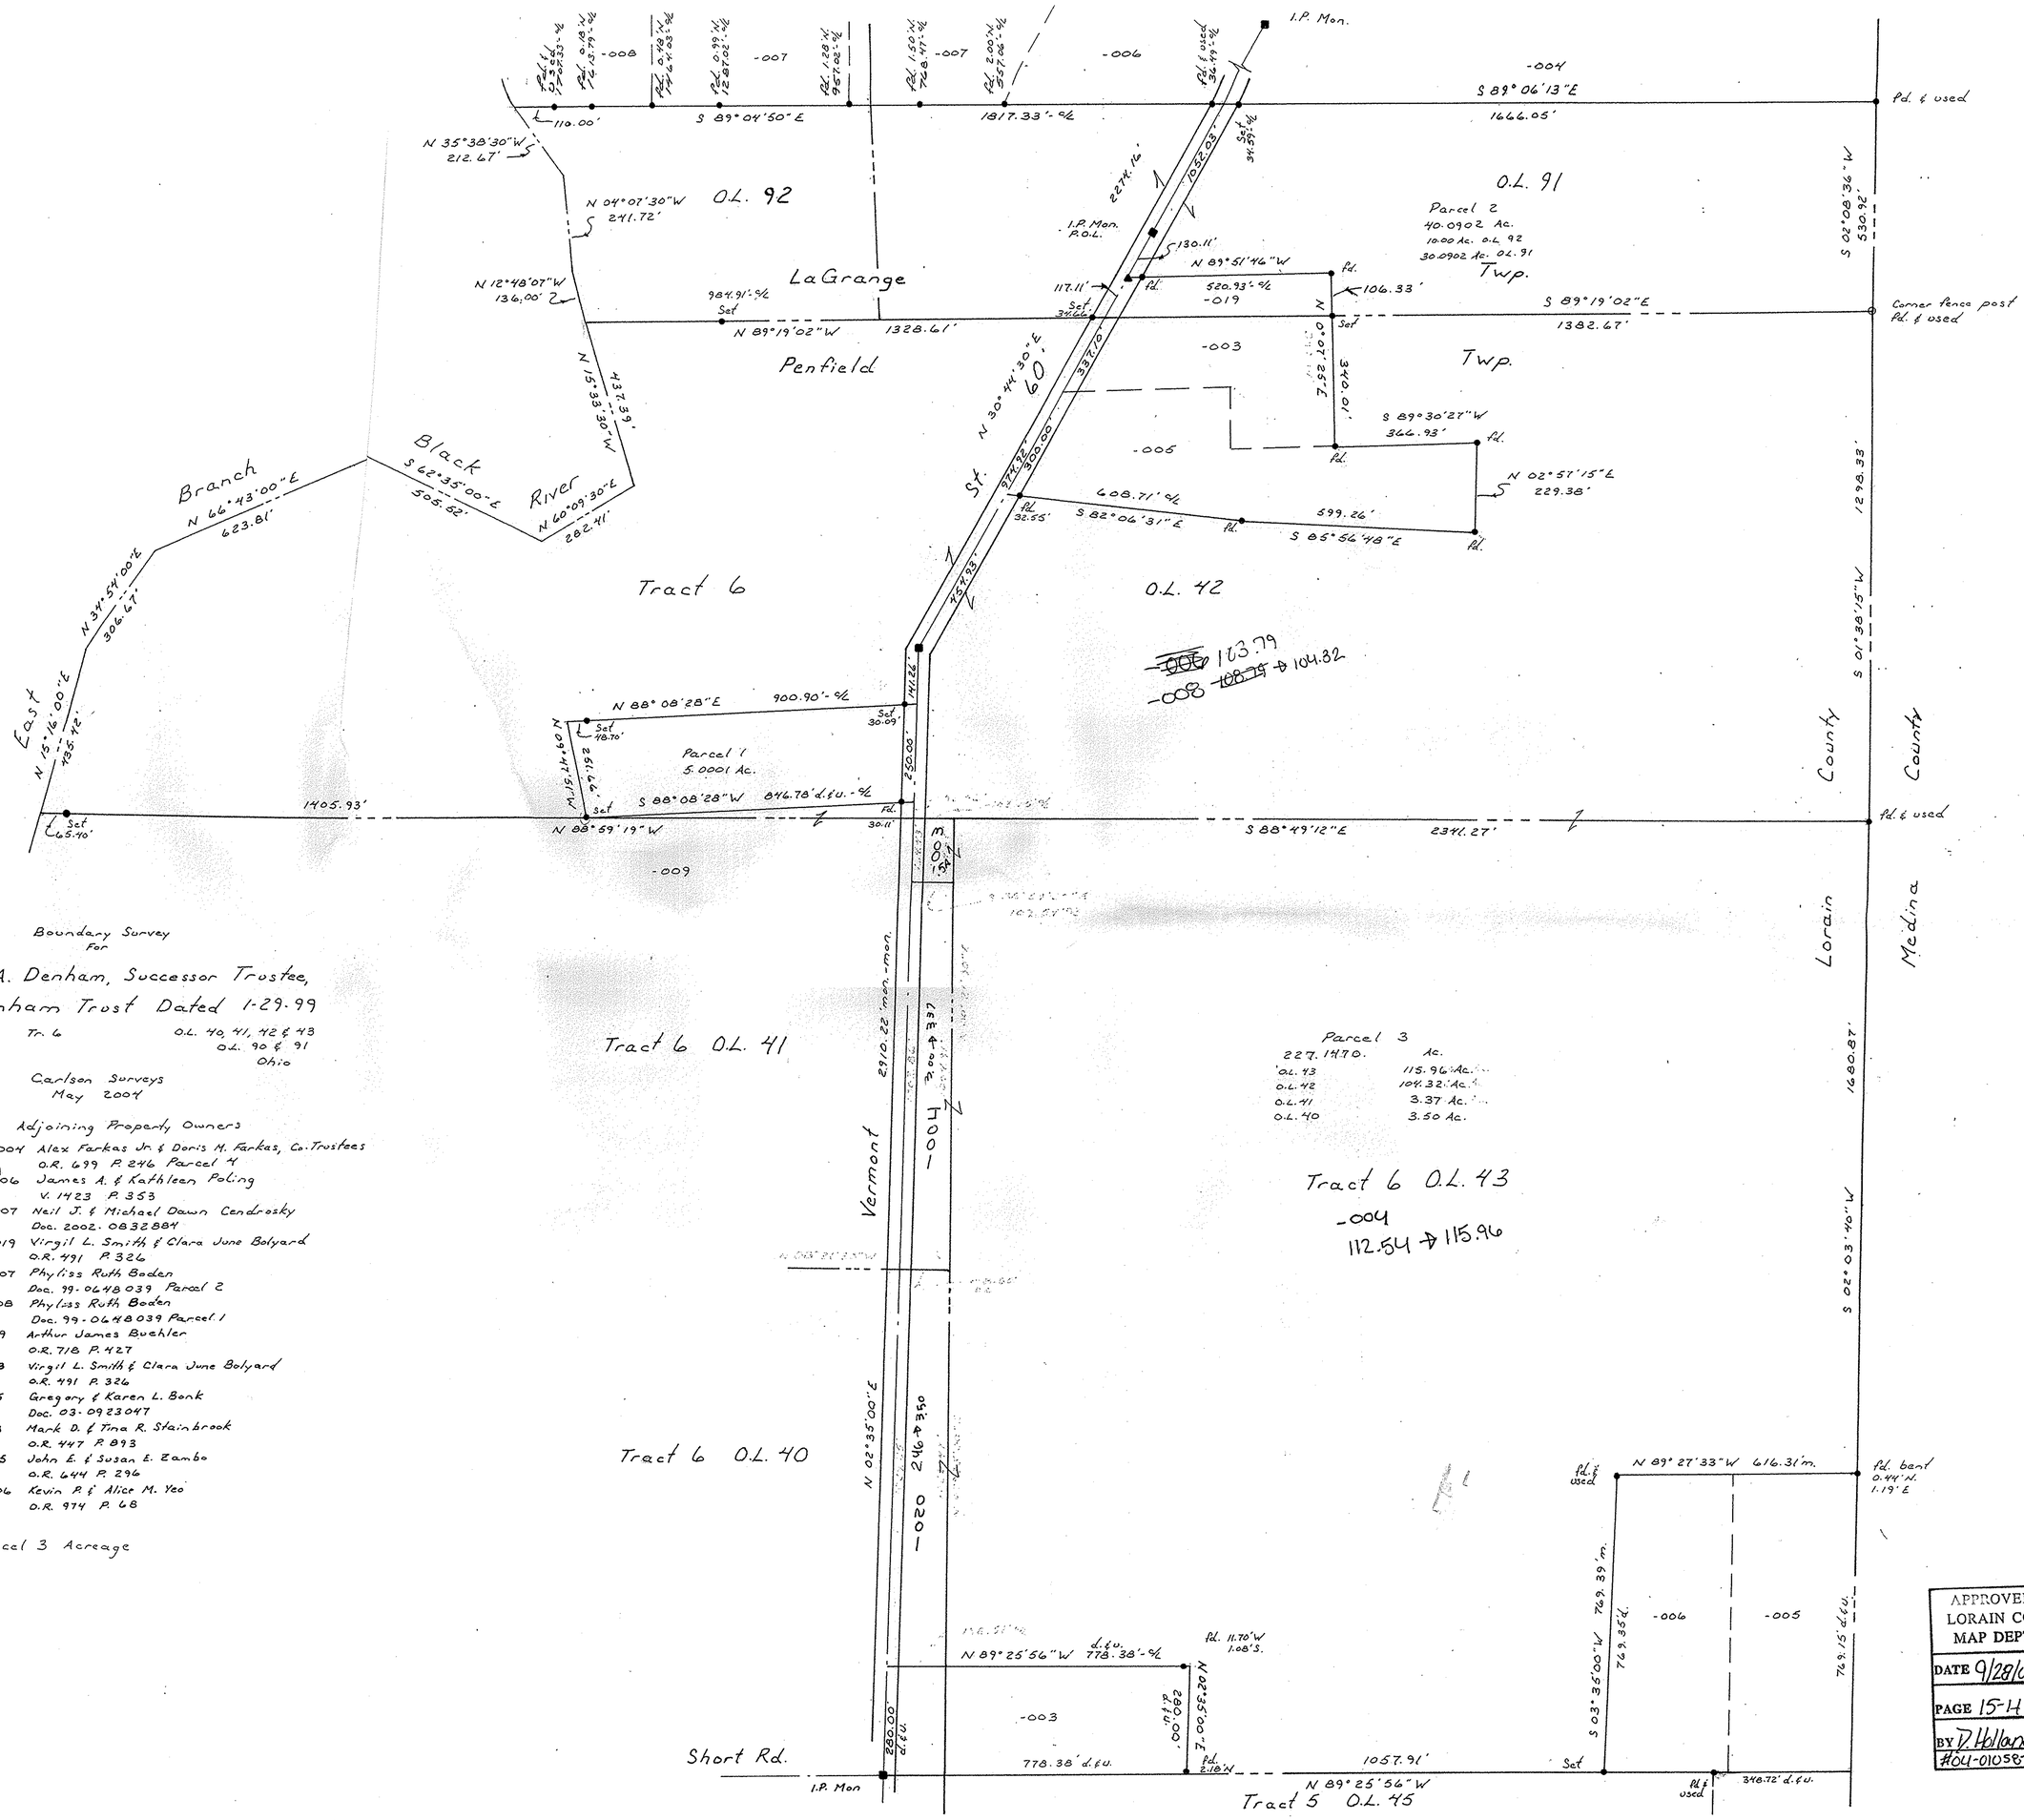


Boundary Survey
for

Raymond A. Denham, Successor Trustee,
Myrle T. Denham Trust Dated 1-29-99

Penfield Twp. Tr. 6 O.L. 40, 41, 42 & 43
LaGrange Twp. O.L. 90 & 91
Lorain Co. Ohio

Carlson Surveys
May 2004

Adjoining Property Owners

| | |
|---|---|
| 15-00-091-000-004 | Alex Farkas Jr. & Doris M. Farkas, Co-Trustees O.R. 699 P. 246 Parcel 4 |
| 15-00-091-000-006 | James A. & Kathleen Poling V. 1423 P. 353 |
| 15-00-091-000-007 | Neil J. & Michael Dawn Cendrosky Doc. 2002-0832884 |
| 15-00-091-000-019 | Virgil L. Smith & Clara June Bolyard O.R. 491 P. 326 |
| 15-00-092-000-007 | Phyliss Ruth Boden Doc. 99-0648039 Parcel 2 |
| 15-00-092-000-008 | Phyliss Ruth Boden Doc. 99-0648039 Parcel 1 |
| 19-06-041-000-009 | Arthur James Buehler O.R. 718 P. 427 |
| 19-06-042-000-003 | Virgil L. Smith & Clara June Bolyard O.R. 491 P. 326 |
| 19-06-042-000-005 | Gregory & Karen L. Bank Doc. 03-0923047 |
| 19-06-043-000-003 | Mark D. & Tina R. Stainbrook O.R. 447 P. 893 |
| 19-06-043-000-005 | John E. & Susan E. Zambo O.R. 644 P. 296 |
| 19-06-043-000-006 | Kevin P. & Alice M. Yeo O.R. 974 P. 68 |

Rev. 9-1-04 Parcel 3 Acreage

APPROVED
LORAIN CO.
MAP DEPT
DATE 9/28/04
PAGE 15-H
BY D. Holland
#04-01058-D