9-00-094

3

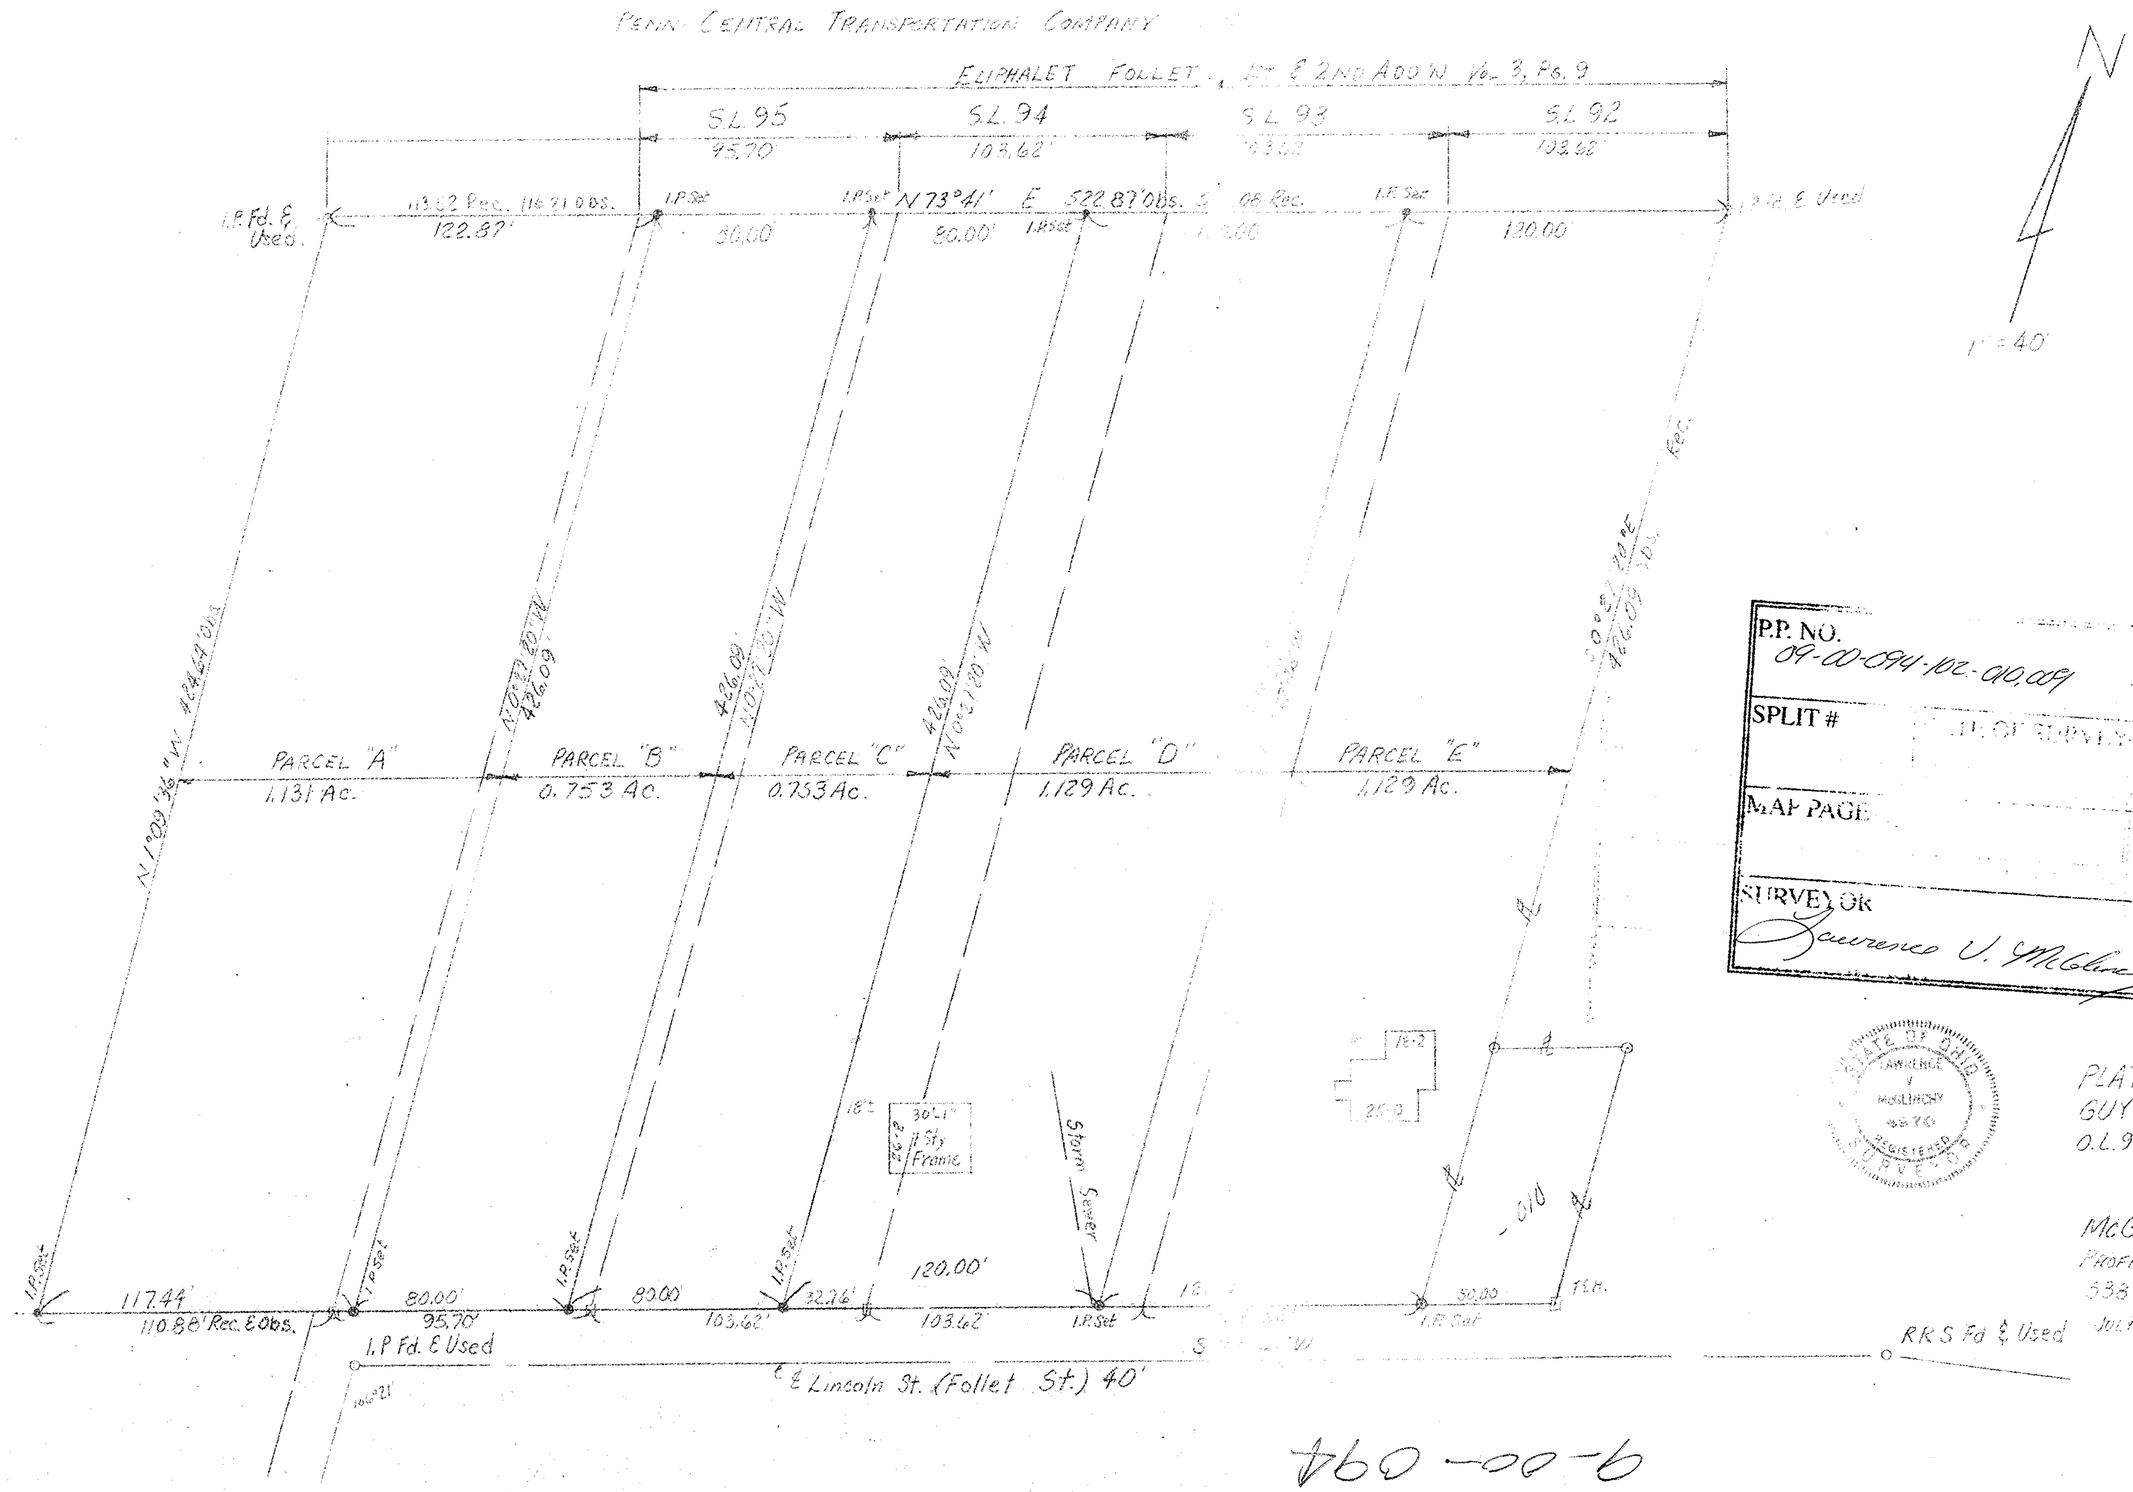


P.P. NO.
09-00-094-102-010,009

SPLIT #

MAP PAGE

SURVEYOR
Laurence V. McGlinchy

STATE OF OHIO
LAWRENCE V. McGLINCHY
4876
REGISTERED
SURVEYOR

PLAT OF SURVEY FOR
GUY & HELEN NICHOLSON
O.L. 94, RUSSIA TWP., OBERLIN CIT
LORAIN COUNTY, OHIO

McGLINCHY & ASSOCIATES
PROFESSIONAL ENGINEER & SURVEYOR
538 W. BROAD ST. ELYRIA, OHIO
JULY 28, 1975 Job. No. 75379

9-00-094

Lou HALL