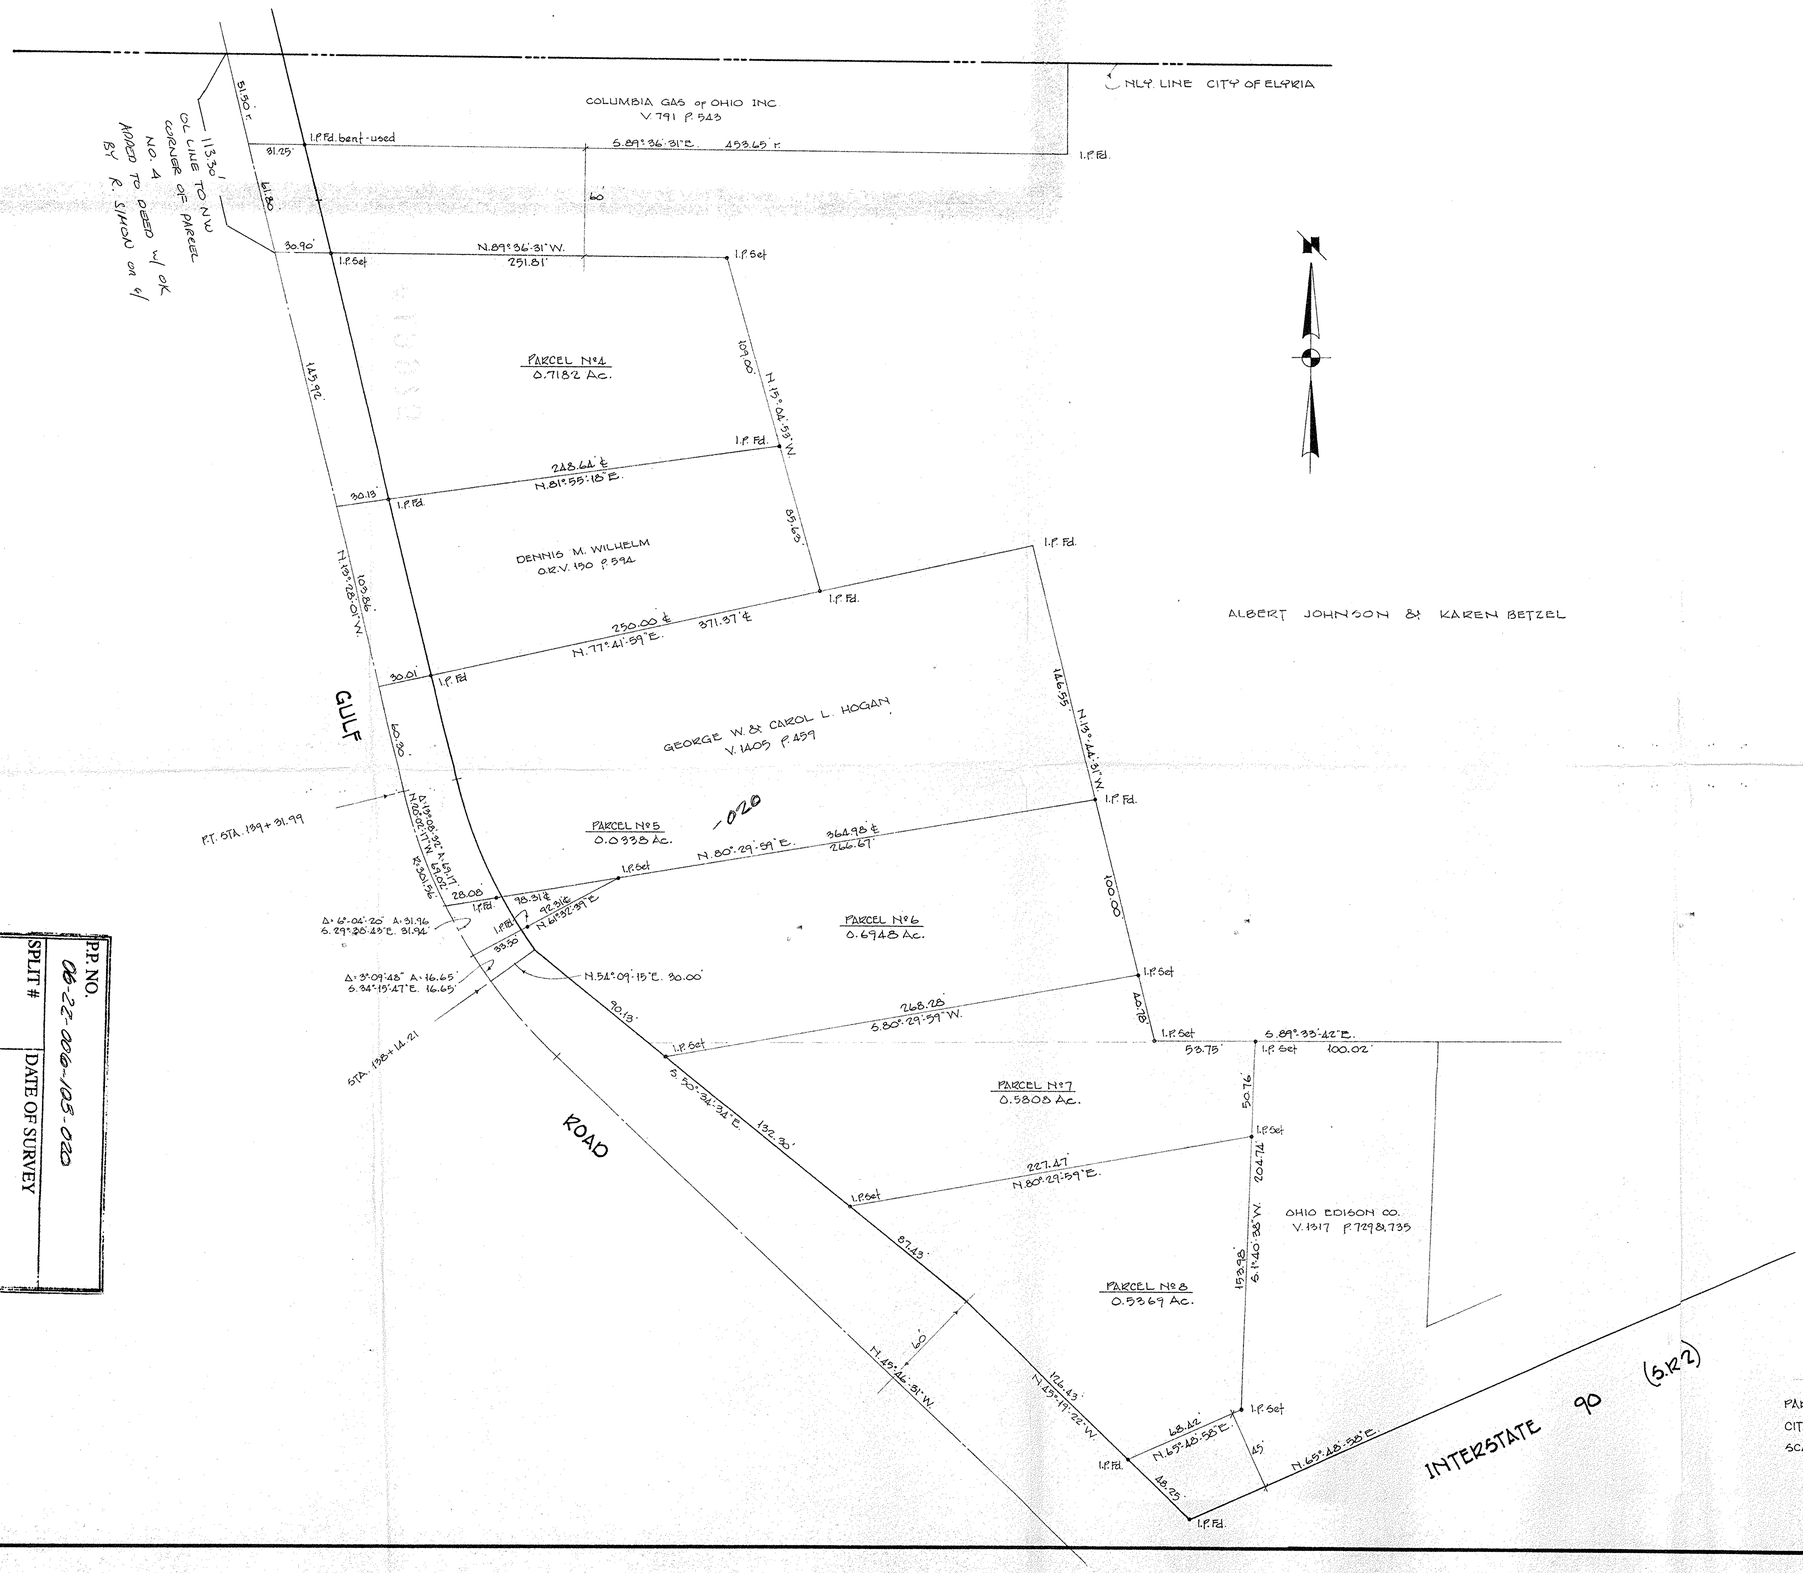

P.P. NO.
06-22-006-103-020
SPLIT #
DATE OF SURVEY
AP PAGE

19975
APPROVED
LORAIN CO.
MAP DEPT.
DATE 6-25-92
PAGE 6-14
BY CAROLYN FRANCIS
VOID AFTER # 19975

06-22-006-103-

STATE OF OHIO
RODGER G. SIMON
5101
REGISTERED SURVEYOR

SURVEY FOR

ALBERT JOHNSON

PART OF O.L. 6 BURRELL & DAY TRACT OF ELYRIA TWP.
CITY OF ELYRIA LORAIN COUNTY OHIO
SCALE 1" = 40' APRIL, 1990

LAUNDON · SIMON · CAHL & ASSOC.
ENGINEERS SURVEYORS

JOB No 90-1926

249