06-24-021-000

#19472
APPROVED
LORAIN CO.
MAP DEPT.
DATE 7-16-91
PAGE 6-75
BY CAROLYN FRANCIS
VOID AFTER # 19472

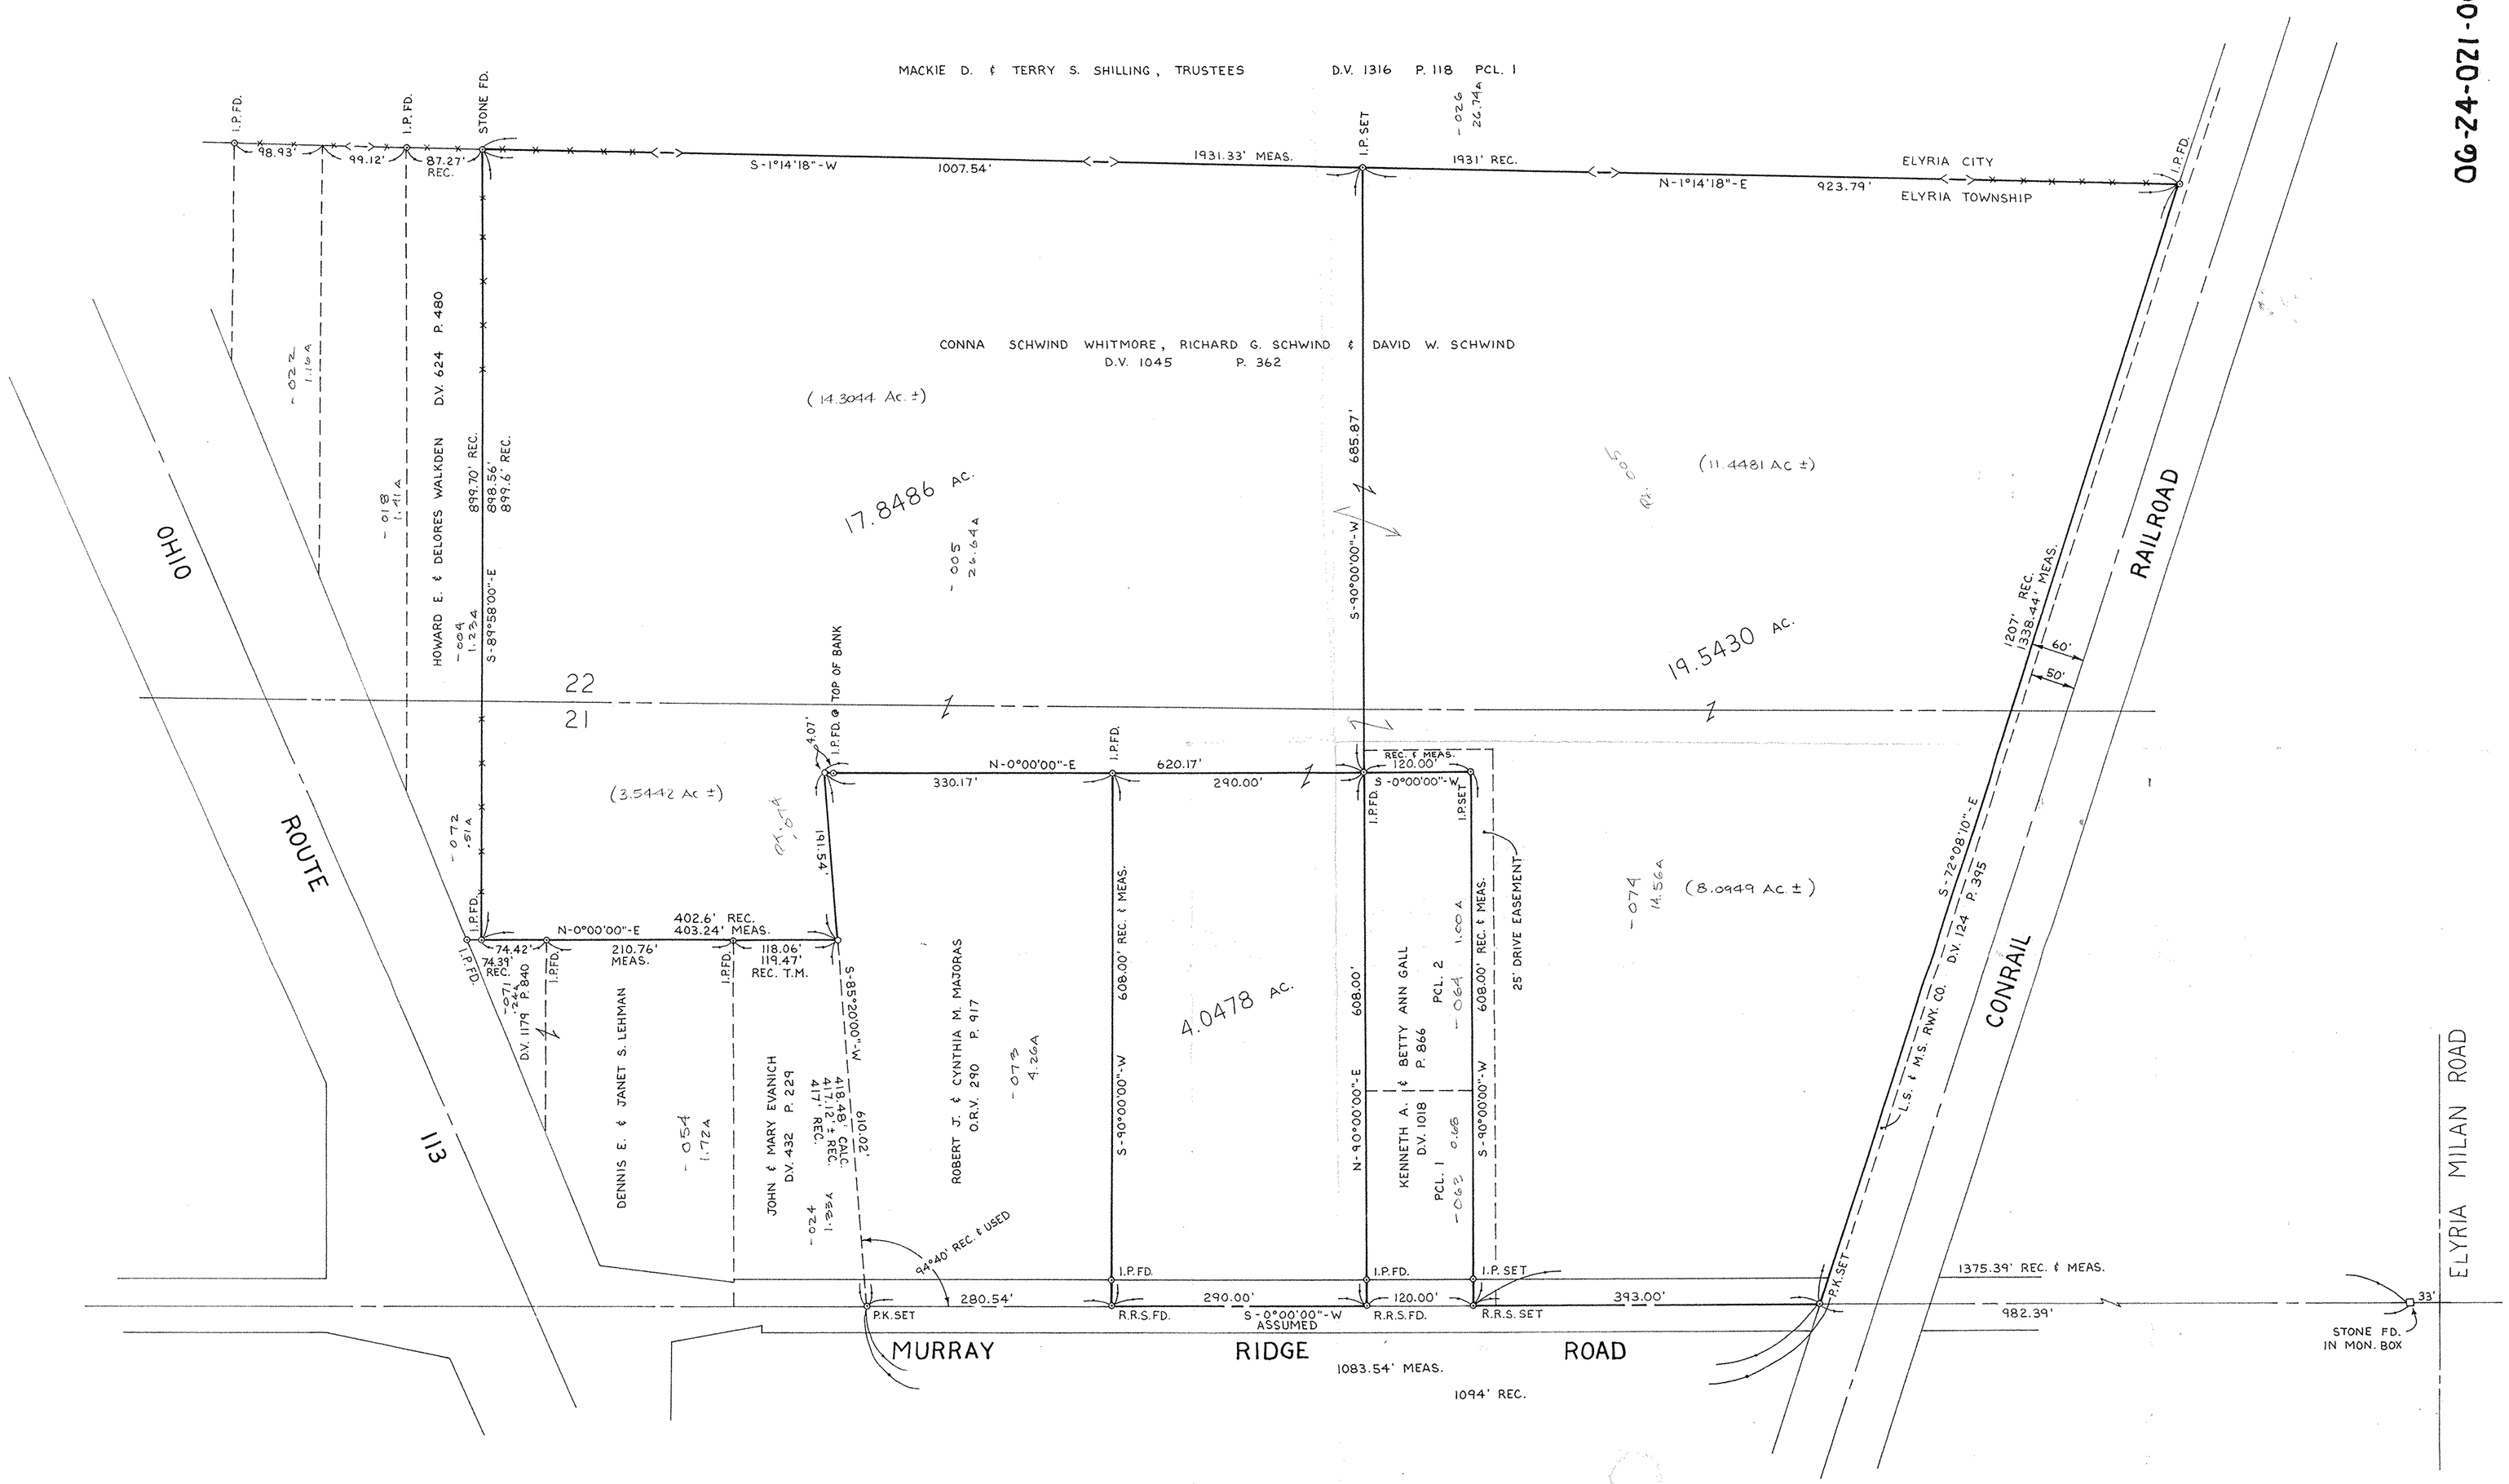

NORTH

0 50 100 200 300

SCALE: 1" = 100'

BOUNDARY SURVEY

OF PART OF

ELYRIA TOWNSHIP ORIGINAL LOTS NOS. 21 & 22

WEST OF THE BLACK RIVER

TWP. OF ELYRIA · COUNTY OF LORAIN · STATE OF OHIO

PREPARED BY:
KS ASSOCIATES INC.
ENGINEERS · SURVEYORS

David L. Elwell
DAVID L. ELWELL REG. SURVEYOR NO. 6333
DEC. 14, 1990

STATE OF OHIO
DAVID L. ELWELL
6333
REGISTERED SURVEYOR

P.P. NO.	
06-24-021-000 .074/064/063/073	
SPLIT 19472	DATE OF SURVEY
SUR. David L. Elwell	

87-81 A