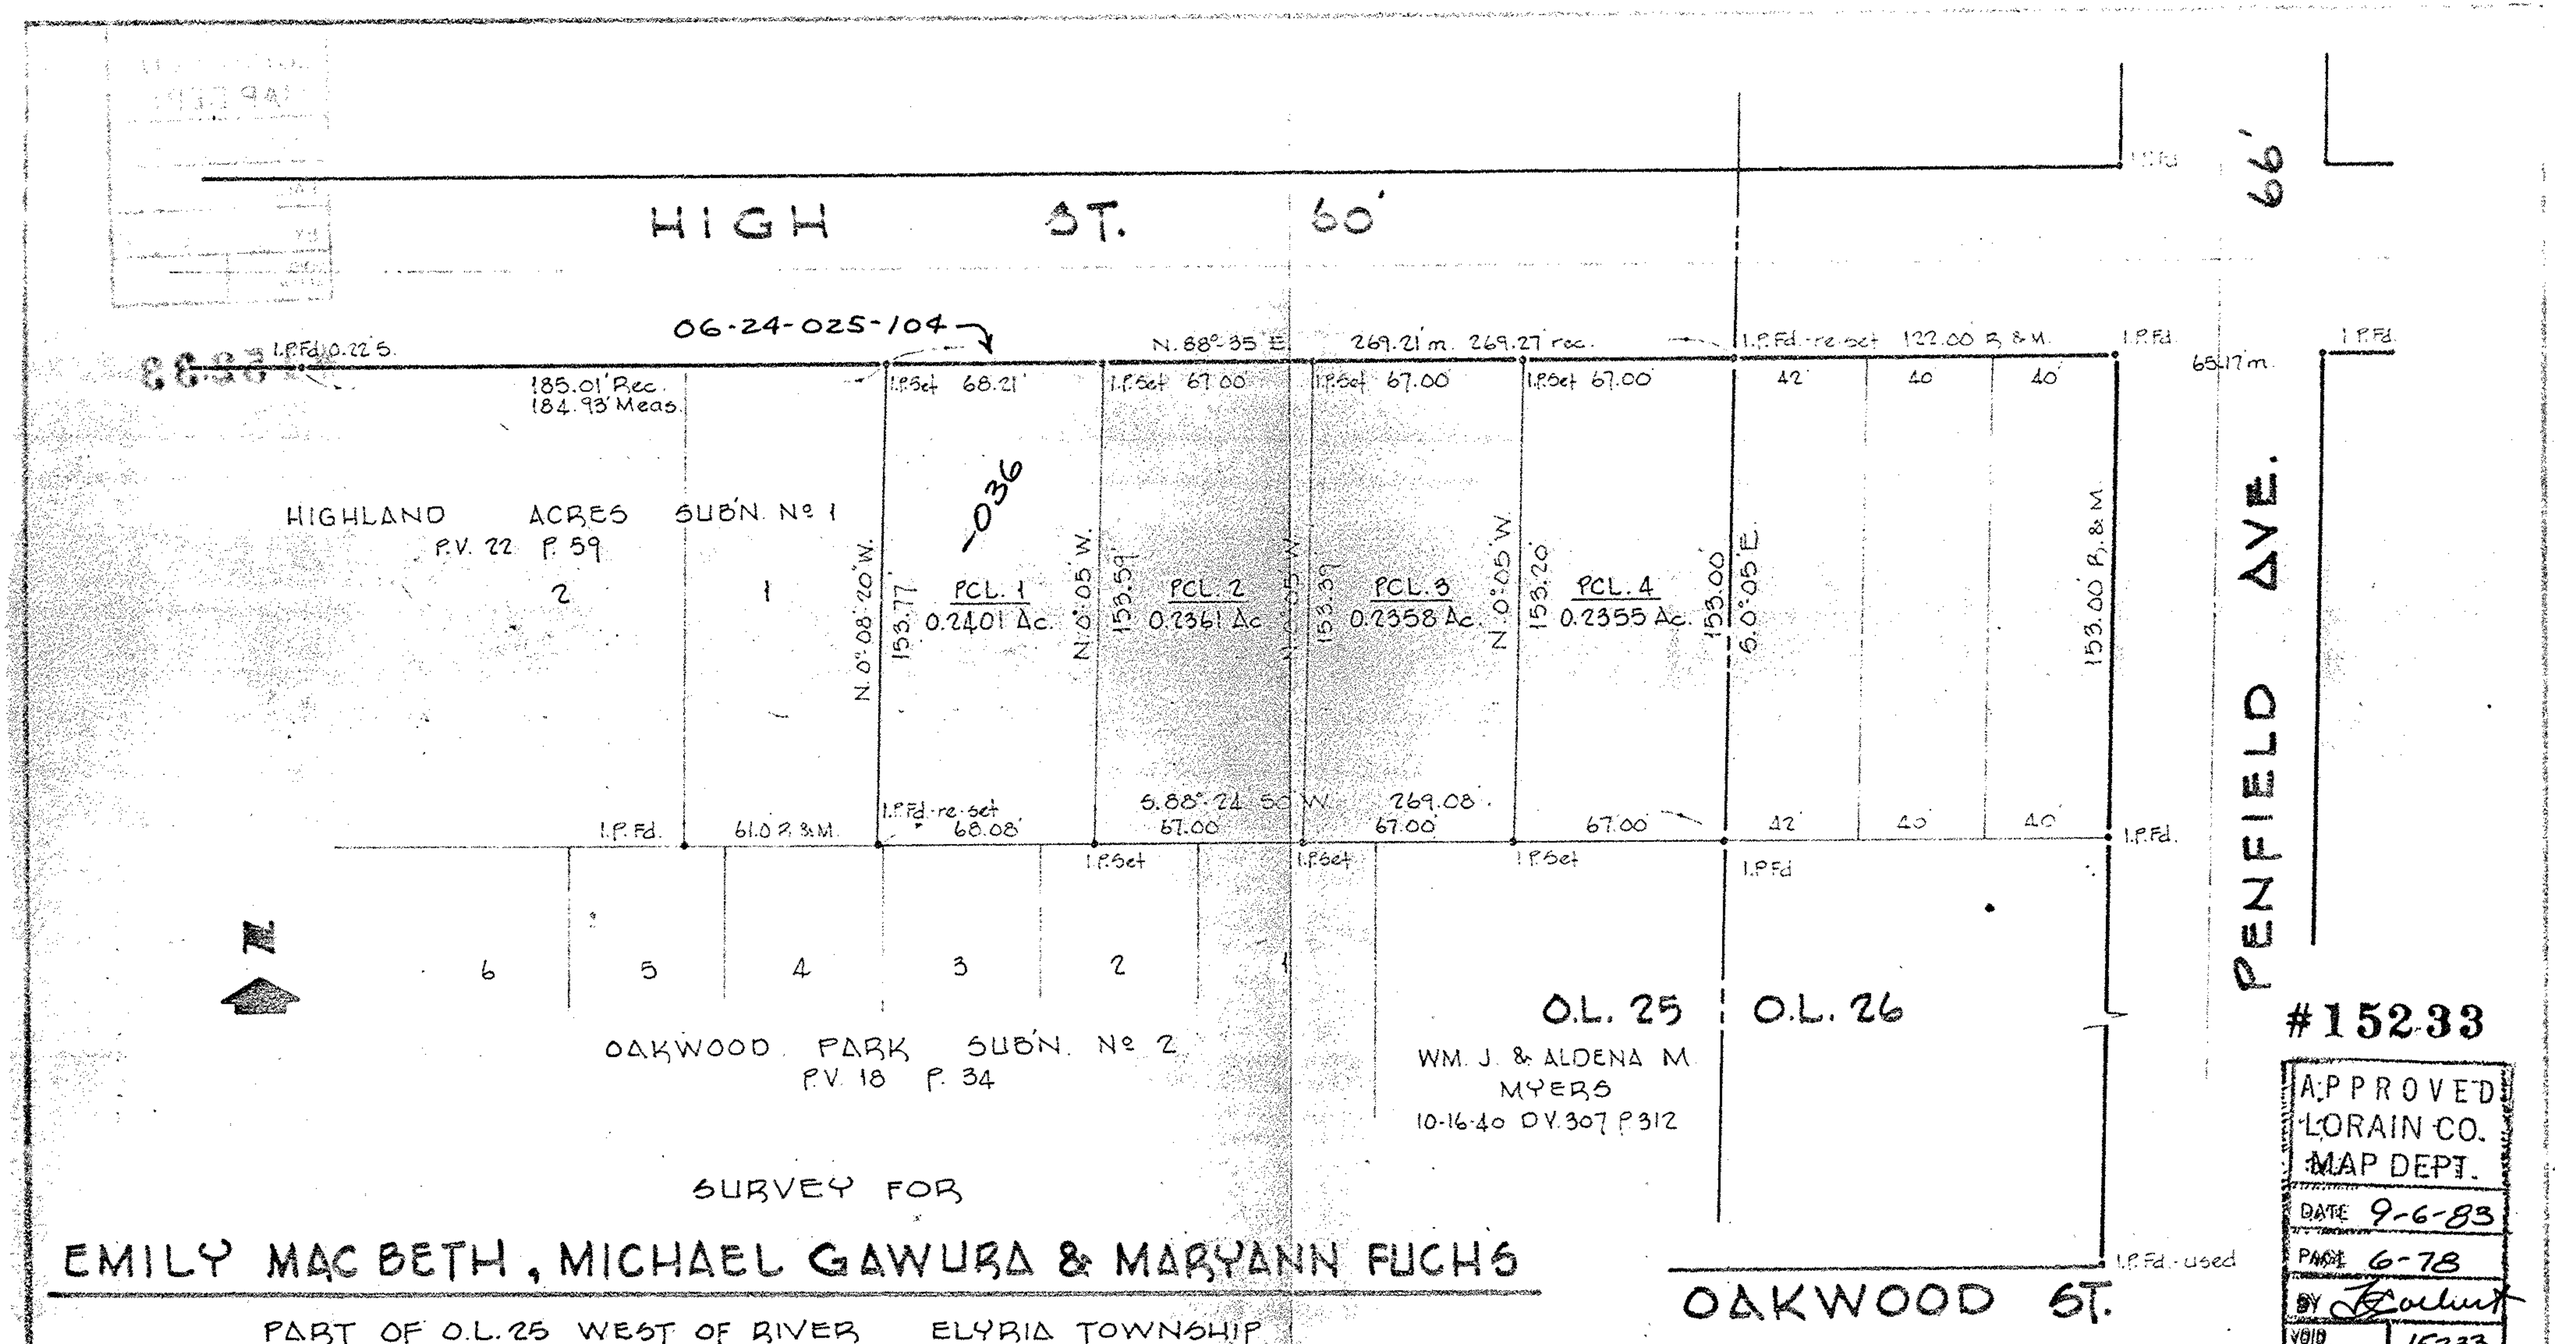

SURVEY FOR

EMILY MAC BETH, MICHAEL GAWURA & MARYANN FUCHS

PART OF O.L. 25 WEST OF RIVER ELYRIA TOWNSHIP
CITY OF ELYRIA COUNTY OF LORAIN STATE OF OHIO
SCALE 1"=50' OCT. 4, 1982

LAUNDON • SIMON • CAHL & ASSOC.
ENGINEERS SURVEYORS

06-24-025-104-036

#15233

APPROVED
LORAIN CO.
MAP DEPT.
DATE 9-6-83
PAGE 6-78
BY [signature]
VOID AFTER 15233

JOB Nº 82-1149 F.B. 78 P. 68

162