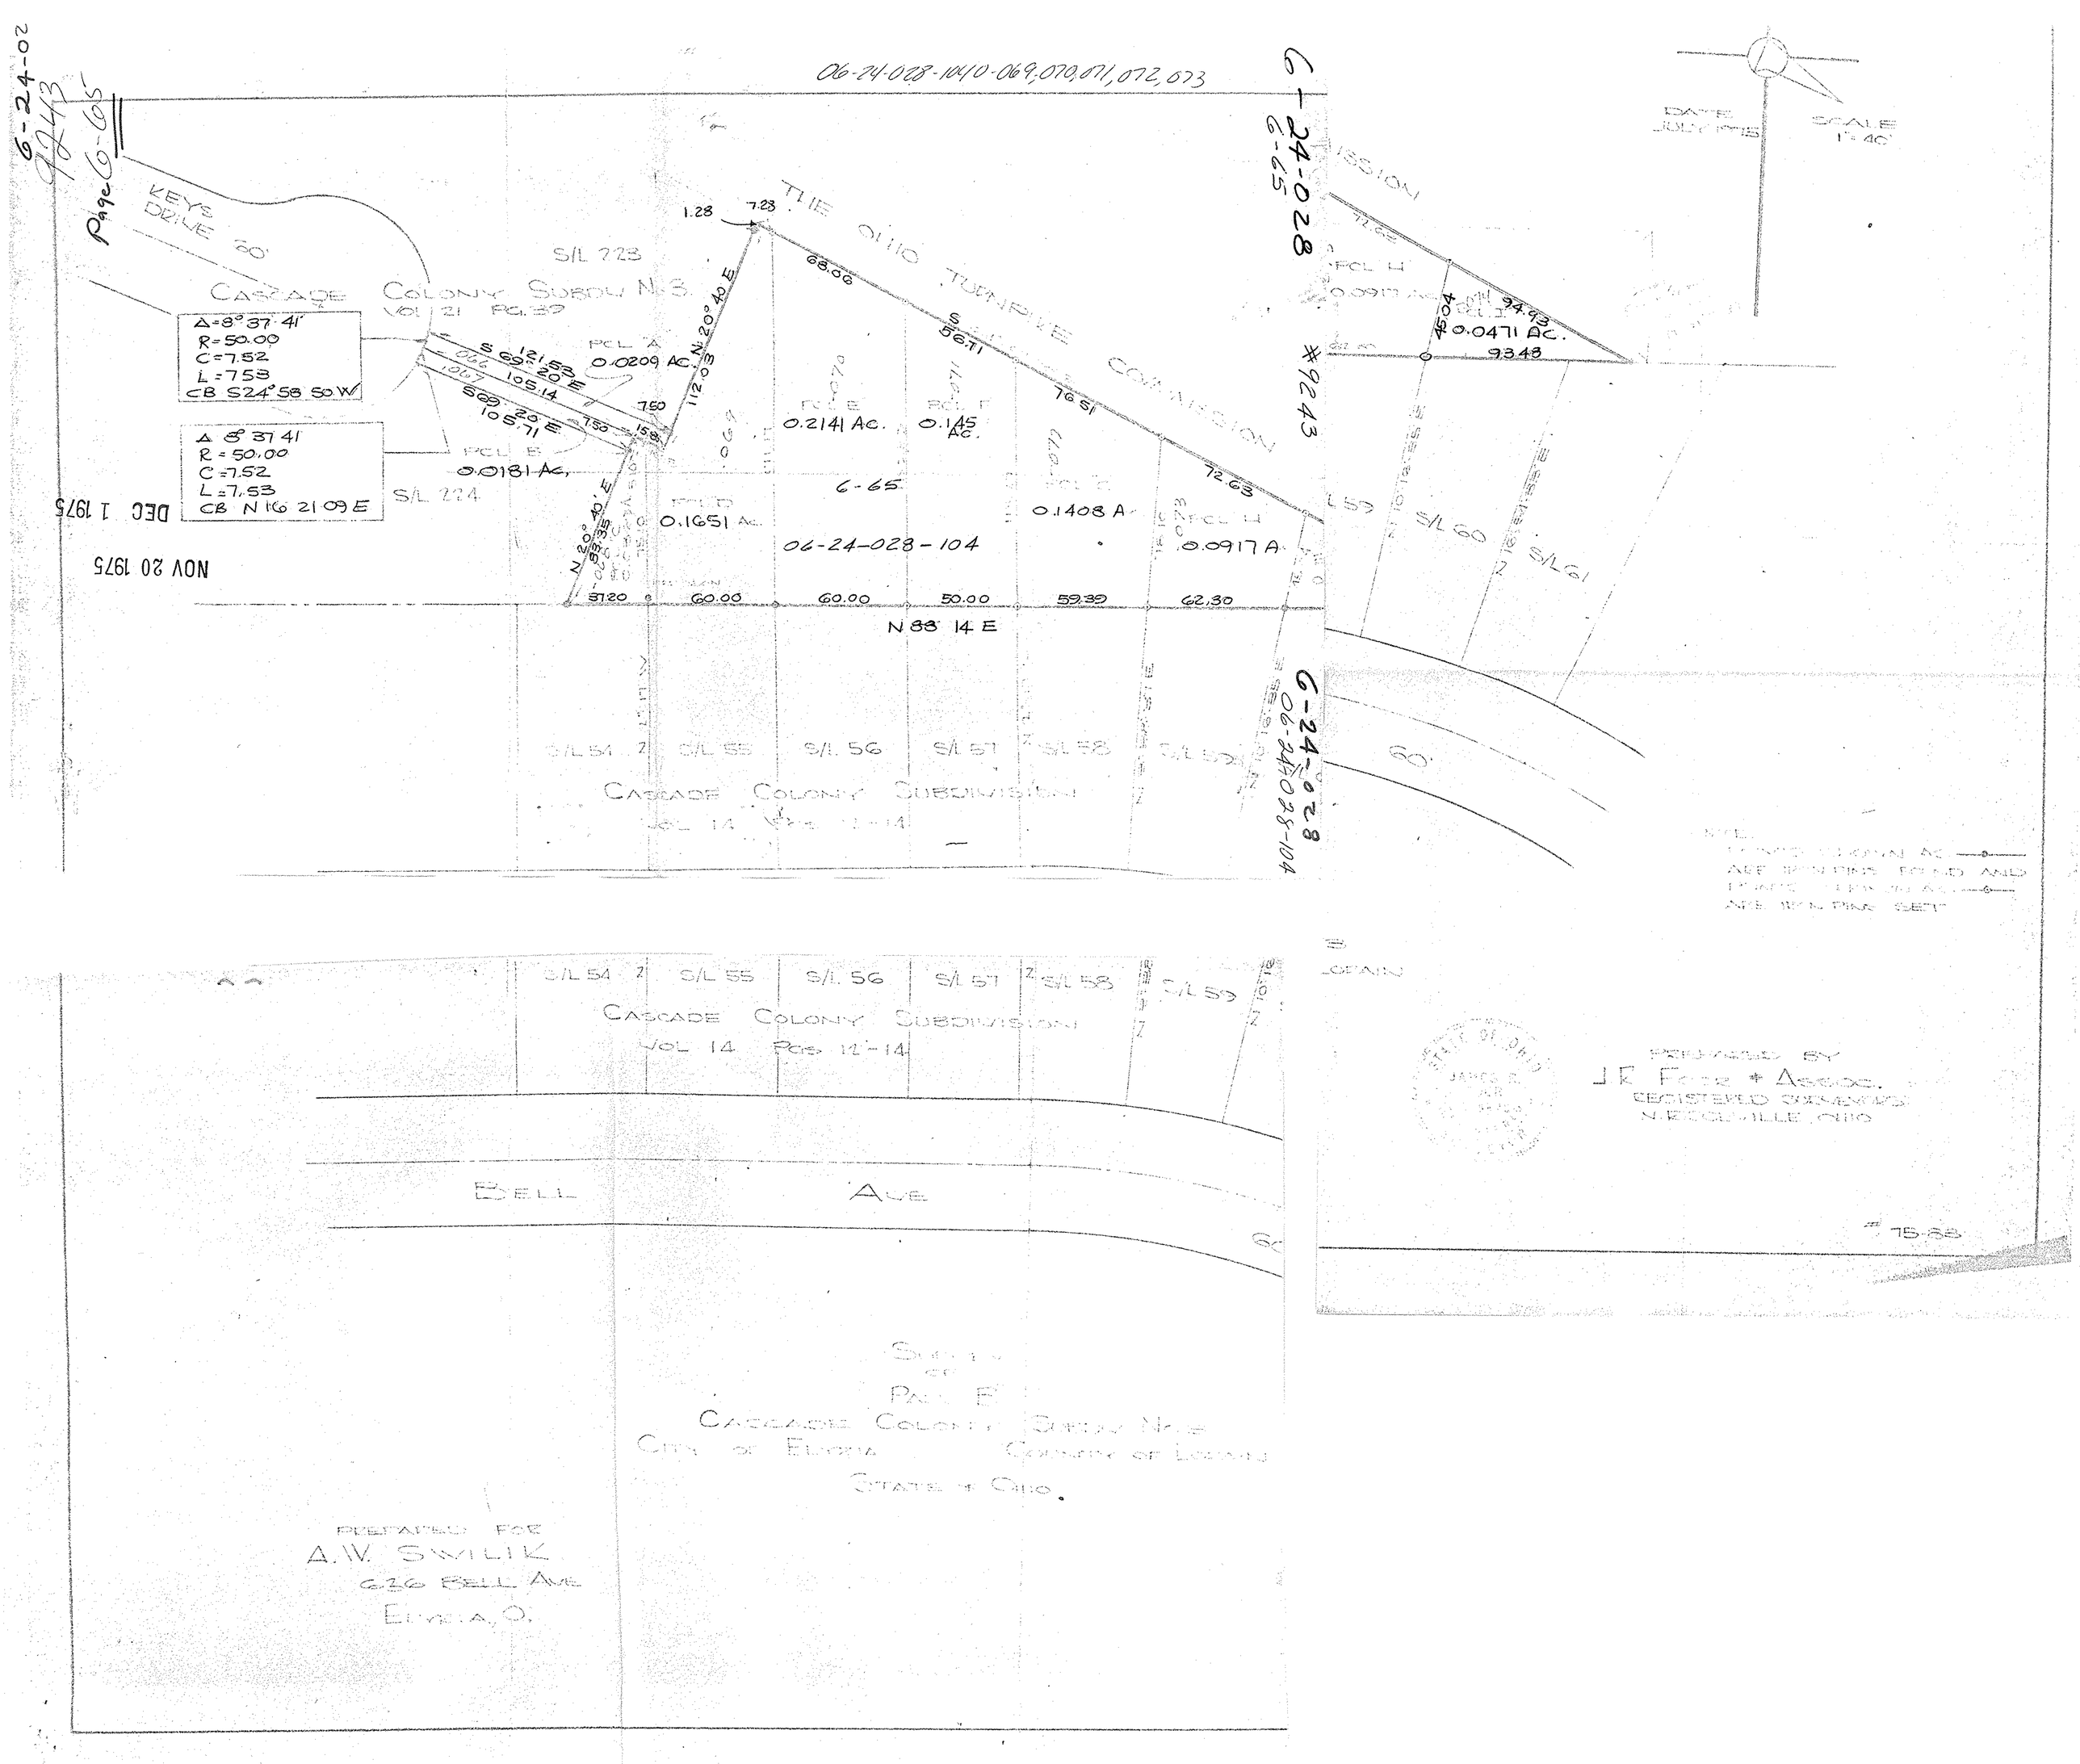

06-24-028-1040-069,070,071,072,073
6-24-028
6-65
#9243
6-24-028
06-24-028-104
Page 6-65
KEYS DRIVE 60'
CASCADE COLONY SUBDIV. NO. 3
VOL 21 PG. 39
S/L 223
S/L 224
THE OHIO TURNPIKE COMMISSION
Δ=8°37'41"
R=50.00
C=7.52
L=7.53
CB S24°58'50"W
Δ 8°37'41"
R=50.00
C=7.52
L=7.53
CB N16°21'09"E
PCL A 0.0209 AC.
PCL B 0.0181 AC.
PCL C 0.1408 A
PCL D 0.1651 AC.
PCL E 0.2141 AC.
PCL F 0.145 AC.
PCL H 0.0917 A
PCL I 0.0471 AC.
6-65
06-24-028-104
N 88° 14' E
S/L 54
S/L 55
S/L 56
S/L 57
S/L 58
S/L 59
S/L 60
S/L 61
CASCADE COLONY SUBDIVISION
VOL 14 PGS 12-14
BELL AVE
60'
DEC 1 1975
NOV 20 1975
DATE JULY 1975
SCALE 1"=40'
PREPARED BY
J.R. FOOR & ASSOC.
REGISTERED SURVEYORS
N. RIDGEVILLE, OHIO
#75-88
SURVEY OF PART B
CASCADE COLONY SUBDIV. NO. 3
CITY OF ELYRIA COUNTY OF LORAIN
STATE OF OHIO
PREPARED FOR
A.W. SWILIK
636 BELL AVE
ELYRIA, O.