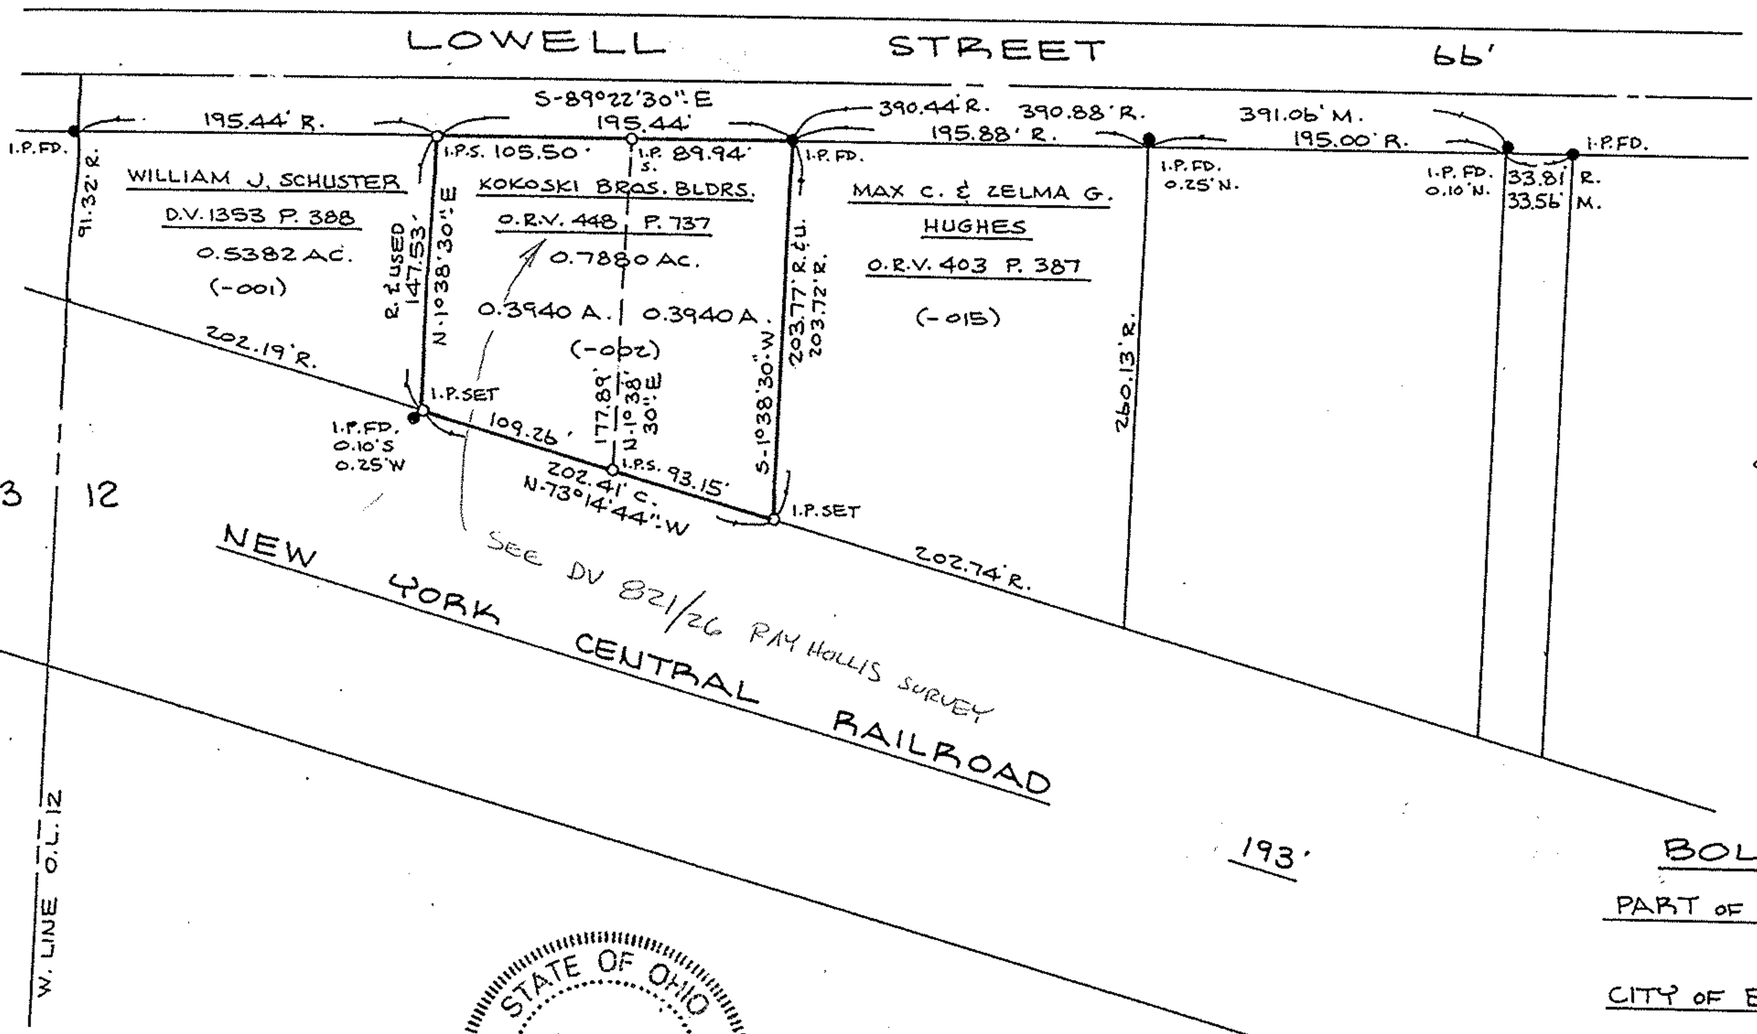

19642

APPROVED
LORAIN CO.
MAP DEPT.
DATE 11-4-91
PAGE G-96
BY CAROLYN FRANCIS
VOID #4 19642

BOUNDARY SURVEY

PART OF ELYRIA TOWNSHIP ORIG. LOT 12
WEST OF BLACK RIVER

CITY OF ELYRIA COUNTY OF LORAIN
STATE OF OHIO

PREPARED BY
KS ASSOCIATES INC.
ENGINEERS SURVEYORS
10-22-91

STATE OF OHIO
DAVID L. ELWELL
6333
REGISTERED
SURVEYOR

David L. Elwell
REG. SURV. NO. 6333

06-24-012-101-015.002.001

91-506